



## **Business Services**

### **Contracts Office**

5735 47th Avenue • Sacramento, CA 95824

(916) 643-2464

*Gerardo Castillo, Chief Business Officer*

*Jessica Sulli, Contract Specialist*

## **ADDENDUM NO. 2**

Date: May 23, 2018

Issued by: Sacramento City Unified School District

**Project: Hiram Johnson HVAC Replacement**

You are hereby notified of the following changes, clarifications, or modifications to the original Contract Documents, Specifications, and Drawings. This Addendum shall supersede the original project documents, and shall take precedence over anything to the contrary therein. All Addenda shall be acknowledged in the Bid Form. Failure to do so may result in disqualification of the bid. All other conditions remain unchanged.

---

## **PART A - TECHNICAL REQUIREMENTS**

**1.1 Refer to Specification Section 09 51 00 Suspended Acoustical Ceiling**

**Revise:** Revised size of ceiling tiles to 24" X 48" X 3/4in.

**1.2 Refer to Specification Section 22 05 00 Plumbing Piping Systems**

**Revise:** The section 2.02 Basic pipes and pipe fittings: A.1 and 2.03.C is updated to correctly specify the condensate piping material to be Galvanized steel (Tremco coating).

**1.3 Refer to Specification Section 23 09 00 Energy Management Systems**

**Revise:** Replace this section in its entirety

## **PART B – DRAWINGS**

**1.4 Refer to Drawing Sheet G0.01**

**Note:** Index of Drawings revised

**Refer to Drawing Sheet A6.11 & A6.12**

**Note:** Clouded areas clarify ceiling tile grid at 24" x 48"



**Refer to Drawing Sheet S1.2**

**Note:** Revised detail 8 to add  $\frac{3}{4}$ " shim plates under HSS4x4. The shim plates will be welded to the new W8 beams below.

**Refer to Drawing Sheet M0.01**

**Note:** Added mechanical demolition note

**Refer to Drawing Sheet M0.02 and M0.03**

**Note:** Revised the notes under packaged roof top AC unit schedule to update the spring roof curb, pressure transducer for power exhaust and 4 inch thick filter requirements

**Refer to Drawing M1.00**

**Note:** The detail B is added to show the central plant controls scope requirement and the panel location.

**Refer to Drawing M2.05**

**Note:** The drawing is updated to add the detail "C" showing the location of the new control valve location. Detail "B" updated to specify the linear for the ductwork on the roof.

**Refer to Drawing M5.01**

**Note:** The detail "A" is updated to show the spring isolator curb for the new rooftop AC unit. Detail "B" is updated to clarify the spacing requirements.

**Refer to Drawing M5.02**

**Note:** The detail "A" is updated to show the correct spring isolator curb. Detail "B" is updated to clarify the spacing requirements.

**Refer to Drawing M6.01**

**Note:** The detail "A" is updated to show the new central plan panel requirements. Detail "B" is updated and "C" is added to show the scope of work for the central plant controls requirements.

**Refer to Drawing M6.02**

**Note:** The sheet is added to the set to show the Boiler scope of work for the central plant controls requirements.

**Refer to Drawing Sheet E0.01**

**Note:** Sheet Index updated, new symbols added to the symbol list and luminaire Schedule added.

**Refer to Drawing Sheet E1.01**

**Note:** Added connection to a new mechanical controller.

**Refer to Drawing Sheet E2.01**

**Note:** Clouded areas indicate additional demolition scope.

**Refer to Drawing Sheet E2.02**

**Note:** Clouded areas indicate additional demolition scope.

**Refer to Drawing Sheet E2.04**

**Note:** Entire sheet adds lighting demolition scope.

**Refer to Drawing Sheet E2.05**

**Note:** Entire sheet adds lighting demolition scope.

**Refer to Drawing Sheet E2.22**

**Note:** Entire sheet adds lighting scope.

**Refer to Drawing Sheet E2.23**

**Note:** Entire sheet adds lighting scope.

**Refer to Drawing Sheet E3.01**

**Note:** Clouded areas indicate added FA symbols, components and updated portions of the riser diagram.

**Refer to Drawing Sheet E3.1.1**

**Note:** Clouded areas show additional site fire alarm conduit and wiring.

**Refer to Drawing Sheet E3.2.1**

**Note:** Clouded areas indicate additional fire alarm scope.

**Refer to Drawing Sheet E3.2.2**

**Note:** Clouded areas indicate additional fire alarm scope.

**Refer to Drawing Sheet E4.02**

**Note:** Clouded areas add details, notes and diagrams for lighting and lighting controls.

**List of Attachments**

- 1.5** Specification Section 09 51 00
- 1.6** Specification Section 22 05 00
- 1.7** Specification Section 23 09 00
- 1.8** Sheets G0.01, A6.11 & A6.12 (3 Full Size Drawings)
- 1.9** Sheet S1.2 (1 Full Size Drawing)
- 1.10** Sheets M0.01, M0.02, M0.03, M1.00, M2.05, M5.01, M5.02, M6.01, & M6.02 (9 Full Size Drawings)
- 1.11** Sheets E0.01, E1.01, E2.01, E2.02, E2.04, E2.05, E2.22, E2.23, E3.01, E3.11, E3.21, E3.22, and E4.02 (13 Full Size Drawings)

**END OF ADDENDUM NO. 2**

## **SECTION 09 51 00 SUSPENDED ACOUSTICAL CEILINGS**

### **PART 1 - GENERAL**

#### **1.1 SECTION INCLUDES**

- A. Suspended metal grid ceiling system.
- B. Acoustical panels.
- C. Perimeter trim.

#### **1.2 REFERENCES**

- A. ASTM A513 - Electric-Resistance-Welded Carbon and Alloy Steel Mechanical Tubing.
- B. ASTM C635 - Metal Suspension Systems for Acoustical Tile and Lay-in Panel Ceilings.
- C. ASTM C636 - Installation of Metal Ceiling Suspension Systems for Acoustical Tile and Lay-in Panels.
- D. ASTM C641 - Zinc-Coated (Galvanized) Carbon Steel Wire.
- E. ASTM E580 - Application of Ceiling Suspension Systems from Acoustic Tile and Lay-in Panels in Areas Requiring Seismic Restraint.
- F. ASTM E1264 - Classification of Acoustical Ceiling Products.
- G. CCR - California Code of Regulations, Title 24, Part 2, Chapter 25A.
- H. CBC - California Building Code.
- I. UL - Underwriters' Laboratories Building Material Directory.

#### **1.3 QUALITY ASSURANCE**

- A. Manufacturer: Company specializing in manufacture of ceiling suspension system and ceiling panels with **five years minimum experience**.
- B. Installer: Company with five years minimum documented experience, approved by manufacturer.

#### **1.4 REGULATORY REQUIREMENTS**

- A. Conform to CCR Title 24, Part 2, for suspension system requirements.

- B. Conform to applicable UL and CBC combustibility requirements for materials.

## 1.5 SUBMITTALS

- A. Submit under provisions of Division 01.
- B. Provide Product Data on metal grid system components and acoustic units.
- C. Provide product acceptance approval verification issued by DSA for metal grid system.
- D. Submit two 6-inch squares Samples illustrating material and finish of acoustic units.
- E. Submit two 12-inch long Samples of suspension system main runner, cross runner, and edge trim.

## 1.6 SEQUENCING/SCHEDULING

- A. Do not install acoustical ceilings until building is enclosed, sufficient heat is provided, dust generating activities have terminated, and overhead Work is completed, tested, and approved.
- B. Schedule installation of acoustic units after interior wet Work is dry.

## 1.7 EXTRA STOCK

- A. Provide extra quantity of acoustic units to Owner under provisions of Division 01
- B. Provide quantity equal to 2 percent of units installed.

# **PART 2 - PRODUCTS**

## 2.1 ACCEPTABLE MANUFACTURERS - PANELS

- A. Armstrong
- B. Or accepted Equal

## 2.2 ACCEPTABLE MANUFACTURERS - SUSPENSION SYSTEM

- A. Refer to Construction Documents.
- B. Acoustical Panels – “Fine Fissured”.
  - 1. Surface Texture: Smooth
  - 2. Composition: Mineral Fiber
  - 3. Color: White
  - 4. Size: 24" X 48" X 3/4in.

5. Edge Profile: Square Lay-In for interface with Prelude XL 15/16" Exposed Tee.
6. Noise Reduction Coefficient (NRC): ASTM C 423; Classified with UL label on product carton, N/A.
7. Ceiling Attenuation Class (CAC): ASTM C 1414; Classified with UL label on product carton, 40
8. Emissions Testing: Section 01350 Protocol, < 13.5 ppb of formaldehyde when used under typical conditions required by ASHRAE Standard 62.1-2004, "Ventilation for Acceptable Indoor Air Quality"
9. Flame Spread: ASTM E 1264; Fire Resistive
10. Light Reflectance (LR): ASTM E 1477; White Panel: Light Reflectance: 0.80.
11. Dimensional Stability: HumiGuard Plus - Temperature is between 32°F (0° C) and 120°F (49° C). It is not necessary for the area to be enclosed or for HVAC systems to be functioning. All wet work (plastering, concrete, etc) must be complete and dry.
12. Antimicrobial Protection: BioBlock Plus - Resistance against the growth of mold/mildew and gram positive and gram negative odor and stain causing bacteria.
13. Acceptable Product: Clean Room VL, 870 as manufactured by Armstrong World Industries.

## 2.3 SUSPENSION SYSTEM MATERIALS

- A. Grid: ASTM C635, heavy duty, non-fire-rated, exposed "T" with 15/16 inch exposed flange; components die-cut and interlocking. 2 feet x 4 feet for acoustic panels and 2 feet x 2 feet for metallic panels.
- B. Accessories: Stabilizer bars, clips, splices, and edge moldings required for suspended grid system.
- C. Grid Materials: Commercial quality cold-rolled steel with galvanized coating.
- D. Grid Finish: Refer to construction documents.
- E. Support Channels and Hangers: Galvanized steel; size and type to suit application, to rigidly secure acoustic ceiling system including integral mechanical and electrical components, as detailed on Drawings.
- F. Compression Strut: ASTM A513, telescoping design as detailed on Drawings, galvanized 3/4 inch diameter 14 gage rigid steel tubing with crimped end attached to roof framing and secured to 1/2 inch diameter 14 age rigid steel tubing with crimped end to main runners or equivalent pre-manufactured compression post supplied by ceiling grid manufacturer.
- G. Hanger Wire: ASTM C641, Class 1 coating (galvanized), soft temper, No. 12 gage.

## **PART 3 - EXECUTION**

### **3.1 INSPECTION**

- A. Verify that existing conditions are ready to receive Work.
- B. Verify that layout of hangers will not interfere with other Work.
- C. Beginning of installation means acceptance of existing conditions.

### **3.2 INSTALLATION - GRID SYSTEM**

- A. Install system in accordance with ASTM C636 and ASTM E580 as supplemented in this Section and with notes on the Drawings entitled Metal Suspension Systems for Lay In Panel Ceilings.
- B. Acoustical tile or lay-in panel ceilings in Seismic Design Categories D, E & F shall be designed and installed in accordance with ASTM C635, ASTM C636, and ASTM E580. Modified as in 13.5.6.2.2 per 2013 CBC 1615A.1.20.
- C. Install after major above ceiling Work is complete. Coordinate the location of hangers with other Work.
- D. Hang system independent of columns, ducts, pipes and conduit. Where carrying members are spliced, avoid visible displacement of face plane of adjacent members. Provide cross-struts at four-foot centers for acoustic panels and at two-foot centers for metal panels.
- E. Where ducts or other equipment prevent the regular spacing of hangers, reinforce the nearest effected hangers and related carrying channels to span the extra distance.
- F. Compression struts shall be installed at each main runner not exceeding 12 feet on center in both directions and not more than 8 inches from end of main runner. Insert main 3/4 inch tube over 1/2 inch tube with a minimum 6 inch lap. Secure crimped end of main 3/4 inch tube to structural framing with metal screws and 1/2 inch tube to main runner with metal screws. Secure tube sections together with 2 set screws. Install prefabricated compression post according to manufacturer's recommendations.
- G. Locate grid system on room axis according to reflected ceiling plan. Trim edge panels precisely to fit using table saw. Reject cut pieces which are deformed or damaged during cutting.
- H. Do not eccentrically load system, or produce rotation of runners.
- I. Install edge molding at intersection of ceiling and vertical surfaces, using longest practical lengths. Miter corners. Provide edge moldings at junctions with other interruptions.

### **3.3 INSTALLATION - PANELS**

- A. Field reveal cut edge of perimeter tiles to match factory reveal edge. Paint cut surface if necessary to match surface of tile.
- B. Fit acoustic units in place, free from damaged edges or other defects detrimental to appearance and function.
- C. Lay directional patterned units one way in room. Fit border neatly against abutting surfaces.
- D. Install acoustic units level, in uniform plane, and free from twist, warp and dents.

### 3.4 TOLERANCES

- A. Variation from Flat and Level Surface: 1/8 inch in 10 feet.
- B. Variation from Plumb of Grid Members Caused by Eccentric Loads: Two degrees maximum.

END OF SECTION

**SECTION 22 05 00  
PLUMBING PIPING SYSTEMS**

**PART 1 - GENERAL**

**1.01 WORK INCLUDED:**

- A. Types of plumbing piping systems specified in this section include the following:

Valves  
Gas Piping  
Condensate Piping  
Waste and Vent Water

**1.02 QUALITY ASSURANCE:**

- A. Manufacturer's Qualifications: Firms regularly engaged in manufacture of plumbing piping systems products, of types, materials, and sizes required, whose products have been in satisfactory use in similar service for not less than 5 years.
- B. Contractor's Qualifications: Firm with at least 5 years of successful installation experience on projects with piping systems work similar to that required for project.
- C. Requirements of Regulatory Agencies:
1. Plumbing Code Compliance: Comply with applicable portions of Uniform Plumbing Code pertaining to selection and installation of plumbing materials and products.
  2. Standards and Codes: Latest adopted edition by authority having jurisdiction.

Uniform Plumbing Code  
AWWA 9th Edition  
NFPA 99  
CA Code of Regulations, Title 17  
CA Code of Regulations, Title 24  
SMACNA Guidelines and Standards  
Fed OSHA Title 29, Cal OSHA Title 8 or CA Labor Code
  3. Utility Compliance: Fabricate and install natural gas systems in accordance with local gas utility company requirements.
  4. UMC Compliance: Fabricate and install natural gas systems in accordance with IAPMO "Uniform Mechanical Code."

### 1.03 QUALITY CONTROL:

- A. Workmanship: Comply with industry standards of the region except when more restrictive tolerances or specified requirements indicate more rigid standards or more precise workmanship. Provide suitably qualified personnel to produce work of specified quality. Secure products in place with positive anchorage devices designed and sized to withstand stresses, vibration and racking.

### 1.04 SUBMITTALS:

- A. Product Data: Submit manufacturer's technical product data and installation instructions for plumbing piping systems materials and products.
  - 1. All materials, equipment, devices, etc. to be installed on project shall be factory manufactured, no exceptions taken.
  - 2. All materials, equipment, etc. to be used for permanent installation purposes shall be new. No used materials, equipment, etc. shall be allowed.
  - 3. No item submitted on by the Contractor shall be of a lesser quality in materials or performance than what is in the project specifications.
- B. Record Drawings: At project closeout, submit As Built Drawings of installed piping systems, in accordance with requirements of Division 1.
- C. Maintenance Data: Submit maintenance data and parts lists for plumbing piping systems materials and products. Include this data, product data, shop drawings, and record drawings in maintenance manual; in accordance with requirements of Division 1.

## PART 2 - PRODUCTS

### 2.01 MATERIALS AND PRODUCTS:

- A. Provide piping materials and factory-fabricated piping products of sizes, types, pressure ratings, temperature ratings, and capacities as indicated. Provide materials and products complying with Uniform Plumbing Code.

### 2.02 BASIC PIPES AND PIPE FITTINGS:

- A. Provide pipes and pipe fittings complying with Division-23 Mechanical Materials and Methods section "Pipes and Pipe Fittings," in accordance with the following listing:

1. Condensate Piping:
  - a. Tube Size 1-1/2" inches and Smaller: Galvanized steel pipe (tremco coating) with long sweep elbows and cleanout tees at each change of direction
2. Gas Pipe above Ground to 6" Below Grade: Schedule 40 black steel with malleable iron screwed fittings above grade; welded below grade with Class 150 welding fittings. Connect to each item of gas-fired equipment with drip leg and valve. Provide flex connection in approved sizes where applicable.
3. Gas Piping Underground: PLEXCO PE2406 polyethylene gas distribution pipe ASTM D2513 and ASTM D2683 fittings with fusion welded joints. Pipe shall be labeled for NATURAL GAS in accordance with CPC.
4. At transition between polyethylene and steel piping below grade, provide Central Plastics Company, or equal, Double "O" seal transition fittings. Provide minimum of 30 inches of horizontal steel pipe at all connections to above ground piping. Steel piping shall be coated with plastic or wrapped with 2 layers of 10 mil. PVC tape.
5. Flexible Gas Connector: Brass Craft or equal. Stainless steel corrugated appliance connector, AGA certified (304 stainless steel). Nuts and fittings shall be blue zinc plated 12L14 or 10L10 steel, or stainless steel. Rated at ½ psi. Approved for use outdoors. Designed and manufactured in accordance with ANSI Z21.24, CGA6.10. Connect to each gas appliance with flexible gas connector. Size of connector to match equipment connection size.

## 2.03 PIPE AND FITTINGS INSIDE BUILDING:

- A. See General Requirements, Section 23 05 00, for dielectric fittings and pipe protection. Terminate 5'-0" outside the building line or where marked.
- B. Soil, Storm, Waste and Vent Pipe underground and to 6" above ground: Service weight cast iron soil pipe and fittings, asphaltic coated, conforming to Cast Iron Soil Pipe Institute Standard #301 ASTM A-888 or ASTM A-74 and so stamped. Joints shall be No-Hub conforming to Cast Iron Soil Pipe Institute Standard #310; Ty-Seal or equal with gaskets conforming to ASTM C 564 and ASTM A74. Suspended pipe with No-Hub joints shall have a sway brace at 20'-0" maximum spacing.
- C. Waste and Vent Pipe above ground from lavatories or sinks, rainwater leaders and overflows above the floor: Cast iron soil pipe and fittings with no hub joints conforming to the requirements of CISPI Standard 301, ASTM A-888 or ASTM A-74 for all pipe and fittings. Joints shall conform to CISPI 310 and shall be hubless couplings composed of stainless steel shield, clamp assembly and elastomeric sealing sleeve. DWV drainage tubing and fittings is acceptable when

approved. Condensate drains shall be galvanized steel (tremco coating), with long sweep elbows and cleanout tees at each change in direction. Connect condensate drains to air conditioning units with P-trap and run to an approved receptor and dry well. Provide vibration eliminators at A.C. units.

- D. Water Pipe (Hot and Cold Water): Type L copper tubing, hard temper, with wrought copper fittings. Capped or plugged outlets shall be Schedule 40 screwed brass. Provide full solder cup fittings.

#### 2.04 GAS REGULATORS:

- A. American Meter Company Series 1800 or equal. AGA listed. Regulator shall have orifice sized for specific CFH connected and pressure reduction required. Regulator shall vent to the atmosphere. Provide AGA listed shut off valve upstream of each regulator.

#### 2.05 BASIC VALVES:

- A. Provide valves complying with Division-23 Basic Mechanical Materials and Methods sections and in accordance with 23 05 23 Valves and Piping Specialties.

#### 2.06 CLEANOUTS:

- A. Cleanouts shall be "T" or "Y" branches or trap hubs of same material as pipe in which they are placed. Cleanouts in cast iron lines shall have cast iron bodies with brass plugs. Cleanouts in floors and sidewalks shall be Josam 56010 or 56030 for ceramic tile floors with nickel bronze covers. Cleanouts in vertical lines shall be Josam 58710. Furnish cleanouts at ends of branch lines, at the base of vertical lines, at changes in direction and where shown or required to facilitate cleaning, a maximum spacing of 50' inside buildings, 100' outside, also in waste drop from each sink and urinal. Cleanout to grade shall be set in 14" x 14" x 5" deep concrete pad; trowel smooth and edge; set flush with finished grade. Cleanouts to be full size of line up to a maximum of 4". Cleanouts shall clear all obstructions by 18" minimum. Furnish to Owner one wrench for each size and type of cleanout used. Permanently identify exterior cleanouts: SS for sanitary sewer, SD for storm drain.

#### 2.07 FIXTURES AND TRIM:

- A. Designations are American Standard unless noted. Kohler, Eljer, are acceptable if equal in utility, quality and appearance.
- B. P-traps for lavatories and sinks shall be 17-gauge chrome plated brass, adjustable. Provide offset P-traps for handicapped sinks in order to maintain ADA clearances.
- C. Concealed stops shall be 1/2" Speedway SSR44, lock shield valves. 3/4" stops

shall be Dick Bros. #3150-LK. Exposed stops and supplies shall be 1/2" Speedway #S3712A for LAVS, S3712DL for water closets with IPS inlet, lock shield, loose key.

- D. Insulate domestic water and waste piping below handicapped plumbing fixtures with molded fire resistant foam single piece removable insulation covers, Handi Lav-Guard or equal. Conform with ADA requirements.
- E. Install valve lever on handicap water closets on wide side of fixture.
- F. Operating handle or valve for handicapped fixtures shall operate with less than 5 pounds force.

### **PART 3 - EXECUTION**

#### **3.01 INSPECTION:**

- A. Examine areas and conditions under which plumbing piping systems are to be installed. Do not proceed with Work until unsatisfactory conditions have been corrected in manner acceptable to Contractor.

#### **3.02 INSTALLATION OF CONDENSATE PIPING:**

- A. Cleanouts: Install in piping as indicated and at each change in direction of piping greater than 45 degrees, at minimum intervals of 50 feet.
  - 1. Slope condensate at 1/4"/LF whenever possible. Slope at a minimum of 1/8"/LF.

#### **3.03 EQUIPMENT CONNECTIONS:**

- A. Mechanical Equipment Connections: Connect gas piping system to mechanical equipment as indicated, and provide with shutoff valve and union for each connection. Provide a minimum of 3" dirt leg downstream of shut off valve.
  - 1. All plumbing fixtures with hot water to be connected to a hot water return system.
- B. Connect to each gas appliance with a flexible gas connector (AGA listed) and a quarter turn shut off valve (AGA or CGA listed).

#### **3.04 SPARE PARTS:**

- A. Furnish to Owner, with receipt, one valve key for each key operated hydrant, bibb, or faucet installed.

### 3.05 PIPING CONNECTION:

- A. Minimum grade on drain, vent, and waste piping shall be 1/4" per foot unless noted, or later approved. Vent piping shall be graded to a soil or waste line.
- B. Connections from stacks or horizontal wastes to wall or floor finish for wastes from lavatories, urinals, sinks, and drinking fountains and connection between floor drains and traps shall be IPS 85% red brass pipe.

### 3.06 CLEANOUTS:

- A. Furnish cleanouts at ends of branch lines, at the base of vertical lines, at changes in direction and where shown or required to facilitate cleaning, a maximum spacing of 50 feet inside buildings, 100 feet outside, also in waste drop from each sink. Cleanout to grade shall be set in a 14" x 14" x 5" deep concrete pad, trowel smooth and edge, set flush with finished grade. Cleanouts to be full size of line up to a maximum of 6". Cleanouts shall clear all obstructions by 18" minimum. Furnish to Owner one wrench for each size and type of cleanout used. Permanently identify cleanouts: SS for sanitary sewer.

### 3.07 FIXTURES AND TRIM:

- A. Install all fixtures at locations shown on architectural drawings. Provide proper backing for hanging brackets and hold down screws 2 x 6 blocking secured with U.J.H. clips or carriers as specified. Grout voids between all fixtures and adjacent surfaces with clear Dow Silicon Sealant. Install hold down screws and wall hung lavatories.
- B. All exposed piping, bibbs, stops, faucets, traps, flush valves and other trim for all fixtures shall be chrome plated including piping inside sink cabinets. Provide Hudee rim for all counter type sinks and lavatories. Enameled ware shall be cast iron with acid resisting enamel.
- C. Provide 85% or IPS red brass pipe, securely anchored to building construction, for each connection to faucets, flush valves, stops, hose bibbs, etc. Each fixture except hose bibbs shall have a stop valve installed on water supply lines to permit repairs without shutting off water mains.
- D. Installation for handicap accessible fixtures shall conform to Chapter 16 California Plumbing Code, Section 1115 B California Building Code, and ADA requirements.
- E. Provide water branches at single plumbing fixtures with air chambers at 12" long and of same diameter pipe as branches. Where two or more fixtures are located in a row or batter, continue water supply header either full size of branch line with air chamber one pipe size larger than header and a minimum 24" long installed on end of header or place air chamber at each fixture, or provide water hammer arrestor.

- F. Provide ball valve and solenoid valve in branch air lines to each science lab, mount wall switch were indicated.
- G. Provide expansion joint in gas piping at building seismic joints.

### 3.08 DISINFECTION:

- A. Clean and disinfect all hot and cold water systems connected to domestic water systems in accordance with AWWA Standard C651 and as required by the local building and health department codes. This procedure shall be performed by a water treatment company that has a current Cal-EPA license to apply disinfectant chlorine in potable water.
- B. Preliminary Preparation: Provide a 1" service cock or valve connected to system at a point within 2'-0" of its junction with water supply line and inject disinfecting agent into system through this cock. When project is complete, with all fixtures connected and operable and ready for use and when, by test, system is proved to be free from leaks, it shall be thoroughly flushed by fully opening every outlet and operating every fixture until clear water flows from all of them.
- C. Disinfecting Agent: The chlorine shall be a registered product with Cal-EPA for use in California in potable water lines, such as Bacticide, Cal-EPA Registration No. 37982-20001.
- D. Disinfecting Procedure: Connect a hand operated pump, 100 psi rating, minimum to the 1" service cock or valve.
  - 1. With system completely full of water and supply valve open, adjust every faucet of system so that a trickle of water flows from each.
  - 2. Inject disinfectant until an orthotolidin test at each outlet shows a chlorine residual concentration of at least 50 parts per million (p.p.m.).
  - 3. Close all outlets and valves, including valve connecting to water supply line and 1" service cock on solution injection connection. Maintain condition for 24 hours and chlorine residual of 50 p.p.m. should be retained in system for this 24 hour period. If, after 24 hours, orthotolidin tests indicate that chlorine residual concentration has decreased below 50 p.p.m. then disinfection procedure must be repeated until an approved result is obtained.
  - 4. When the above procedure has been completed, flush out entire system with fresh water until an orthotolidin test at any outlet shows a residual of not more than 0.5 p.p.m.
  - 5. Warning signs shall be provided at all outlets while chlorinating the system.

END OF SECTION

**SECTION 23 09 00  
ENERGY MANAGEMENT SYSTEMS**

**PART 1 - GENERAL**

**1.01 DESCRIPTION OF WORK:**

- A. Refer to Basic Mechanical Requirements Section, for general mechanical requirements.
- B. Refer to Mechanical Division for installation of instrument wells, valve bodies, dampers, etc. in mechanical systems.
- C. Provide the following electrical work as work of this Section, complying with requirements of Electrical Division, and as outlined below:
  - 1. All control wiring between field-installed controls, indicating devices, and unit control panels.
  - 2. Interlock wiring between electrically interlocked devices, sensors, and between a hand or auto position of motor starters as indicated.
  - 3. Wiring associated with indicating and alarm panels (remote alarm panels) and connections to their associated field devices.
  - 4. Contractor shall provide and extend low voltage power source wiring required for operation of control devices provided.
  - 5. Wiring for fully complete and functional controls system and as specified.

**1.02 SUBMITTALS: IN ACCORDANCE WITH DIVISION 1**

- A. Product Data: Submit manufacturer's specifications for each control device furnished, including installation instructions and start-up instructions. Submit integrated wiring and electrical diagram to show complete system operation.
- B. All submittals must be received and approved by the Owner prior to the ordering and installation of any equipment by the Contractor.
  - 1. Provide the Owner with a Building Controls submittal with the following:
    - System Hardware
    - System Architecture
    - Complete System Wiring Schematic

- C. Submit shop drawings showing construction and mounting details for review prior to construction. In addition, submit the following for review prior to panel and/or system fabrication and installation:
  - 1. Field wiring diagrams showing wiring external to panel.
  - 2. Panel internal wiring diagrams also showing panel terminal connections for external wiring, properly coordinated and keyed to external wiring diagram.
  - 3. Designation of all switches, pilot lights, etc. and layout of instruments, switches, and nameplates of panel.

#### 1.03 COORDINATION:

- A. Automatic temperature control systems work shall be accomplished as outlined below:
  - 1. Control Valves furnished under this section shall be installed as specified in Mechanical Division.
  - 2. Control Dampers are provided under the applicable Mechanical Division air distribution or air handling equipment section.
  - 3. Water Pressure Taps, Thermal Wells, Flow Switches, Flow Meters, that will have wet surfaces furnished under this Section, shall be installed as specified in Mechanical Division.
  - 4. Controlled Equipment Power Wiring shall be furnished and installed under Electrical Division. Where control involves 120V control devices controlling 120V equipment, the Division 26 Electrical Contractor shall extend power wiring to the equipment and shall extend it from the equipment to the control device.

#### 1.04 INSTALLING CONTRACTOR QUALIFICATIONS:

- A. The Building Automation System Control System contractor must have been in business, and licensed as a contractor by the State of California, installing HVAC and building automation controls, and fire/life safety systems, for a minimum of ten (10) years preceding the bid opening.
- B. The Building Automation Control System contractor must have completed no less than one (1) control system installation, within twenty-four (24) months preceding the bid opening, pursuant to a single written contract, valued at no less than three hundred thousand (\$300,000) dollars.
- C. The Building Automation Control System contractor must demonstrate that, from the local office that will service the Owner with a four (4) hour emergency response requirement can logistically be provided.

- D. Controls contractor must have direct access to factory certified instructors to provide training upon request of the district.
- E. Controls contractor must have explicit district approval to interface with district wide server for integration of new controls system. Current approved personnel include: Martin Chance, Tom Brennan, Jeffery Winn and John Borges.
- F. The Building Automation Control System contractor must have been, for five (5) years preceding the bid opening, a factory branch office, or a factory authorized dealer for the product manufacturer type identified in subsection 2.01, A., under PART 2 – PRODUCTS, of this section. Factory authorized dealer means:
  - 1. Installing Contractor has a contract directly with the factory. A contract with a distributor is not acceptable.
  - 2. Installing Contractor has direct access to factory technical support and training.

## **PART 2 - PRODUCTS**

### **2.01 GENERAL:**

- A. Manufacturer: The Building Automation Control System shall be provided by the following:
  - 1. Controls are to be provided by Johnson Controls, Inc., branch office in Folsom, CA to match campus standard. Please Contact Zac Dillow @ 925-719-7785
  - 2. No other contractors are acceptable or will be considered
  - 3. The Building Automation Controls contractor must have been, for ten (10) years preceding the bid opening, a factory branch office. A contract with a distributor is not acceptable.
- B. All new controls material must be fully integrated and graphically represented on existing district building automation controls system on the districts servers. Only district authorized personnel may access this server for controls integration.
- C. All components used shall be serviceable, repairable, and replaceable by qualified temperature control technicians using non-proprietary parts, tools, and instruments.

## 2.02 SUPERVISORY CONTROLLER

### A. NETWORK CONTROL ENGINE (NCE)

#### 1. Network Control Engines

- a. The Network Control Engine (NCE) shall be a fully user-programmable, supervisory controller. The NCE shall monitor the network of distributed application-specific controllers, provide global strategy and direction, and communicate on a peer-to-peer basis with other Network Automation Engines.
- b. The Network Control Engine (NCE) shall be a fully user-programmable, digital controller that includes a minimum of 33 I/O points.
- c. Automation Network – The NCE shall reside on the automation network and shall support a subnet of 32 Field controllers.
  - i. The NCE shall allow temporary use of portable devices without interrupting the normal operation of permanently connected modems.
- d. The NCE shall employ a finite state programming to eliminate unnecessary conflicts between control functions at crossover points in their operational sequences. Suppliers using non-state based DDC shall provide separate control strategy diagrams for all controlled functions in their submittals.
- e. The NCE shall be factory programmed with a continuous adaptive tuning algorithm that senses changes in the physical environment and continually adjusts loop tuning parameters appropriately. Controllers that require manual tuning of loops or perform automatic tuning on command only, shall not be acceptable.
- f. The NCE shall be assembled in a plenum-rated plastic housing with flammability rated to UL94-5VB.
- g. The NCE shall support the following number and types of inputs and outputs:
  - i. Ten Universal Inputs - shall be configured to monitor any of the following:

- Analog Input, Voltage Mode
  - Analog Input, Current Mode
  - Analog Input, Resistive Mode
  - Binary Input, Dry Contact Maintained Mode
  - Binary Input, Pulse Counter Mode
- ii. Eight Binary Inputs - shall be configured to monitor either of the following:
    - Dry Contact Maintained Mode
    - Pulse Counter Mode
  - iii. Four Analog Outputs - shall be configured to output either of the following
    - Analog Output, Voltage Mode
    - Analog Output, Current Mode
  - iv. Seven Binary Outputs - shall output the following:
    - 24 VAC Triac
  - v. Four Configurable Outputs - shall be configured to output either of the following:
    - Analog Output, Voltage Mode
    - Binary Output, 24 VAC Triac Mode
- h. The NCE shall have the ability to monitor and control a network of sensors and actuators over a Sensor-Actuator Bus (SA Bus).
    - i. The SA Bus shall be a Master-Slave/Token-Passing (MS/TP) Bus supporting BACnet Standard protocol SSPC-135.
    - ii. The SA Bus shall support a minimum of 10 devices.
    - iii. The SA Bus shall operate at a maximum distance of 1,200 Ft. between the NCE and the furthest connected device.
  - i. The NCE shall have the capability to execute complex control sequences involving direct wired I/O points as well as input and output devices communicating over the Field Trunk or the SA Bus.
  - j. The NCE shall support, but not be limited to, the following applications:
    - Selection and sequencing of up to eight chillers of different sizes
    - Selection and sequencing of up to eight (each) primary and secondary chilled water pumps of varying pumping capacities

- k. The NCE shall support BACnet Standard MS/TP Bus Protocol ASHRAE SSPC-135 on the controller network.
- The NCE shall be BACnet Testing Labs (BTL) certified and carry the BTL Label.
  - The NAE shall be tested and certified as a BACnet Building Controller (B-BC).
  - A BACnet Protocol Implementation Conformance Statement shall be provided for the NCE.
  - The Conformance Statements shall be submitted 10 days prior to bidding.
  - The NCE shall support a minimum of 32 control devices.

B. NETWORK AUTOMATION ENGINE (NAE) – BY JCI

1. The NAE shall perform the function of monitoring all system variables, both from real hardware points, software variables, and controller parameters such as set points.
2. NAE's shall be entirely solid state devices. No rigid disk drives will be permitted in the equipment rooms.
3. The NAE's shall manage and direct all information traffic on the Tier 1 network, between the Tier 1 and Tier2 networks, and to servers.
4. Any NAE on the Tier 1 network shall be equipped with all software necessary to drive the complete user interface including graphics on a browser connected to the NAE via the network or directly via a local port on the node.
5. The operating system of the NAE shall support multi-user access. At minimum four users shall be able to access the same NAE simultaneously.
6. Communication between NAE's shall be per-to-peer via 10/100 Ethernet using the BACnet protocol.
7. The NAE shall be capable of direct connection to multiple field busses using different protocols simultaneously as indicated below. Should the controller not support multiple field busses, install two supervisory controllers side by side.
  - a. An RS-485 serial field bus such as BACnet MSTP or the manufacturer's proprietary field bus – JCI N2.
  - b. A LON field bus for supervision and control of LON based controllers that conform to the Lon Talk standard.

8. The NAE will integrate data from both field busses into a common object structure. Data from both field busses will appear in common displays throughout the user interface in exactly the same format. It shall not be possible to determine which field buss the data originated on without reviewing the system configuration data.
9. The NAE shall be programmable and governed by the requirements of their applicable codes, approvals and regulations.
10. The NAE shall be designed, packaged, installed, programmed and commissioned in consideration of their specific service and prevailing operating conditions. They shall be proven standard product of their original manufacturer and not a custom product for this Project.
11. A failure at an NAE shall not cause failures or non-normal operation at any other system NAE other than the possible loss of active real-time information from the failed NAE.
12. Ancillary NAE equipment, including interfaces and power supplies, shall not be operated at more than 80% of their rated service capacity.
13. The NAE shall comply with FCC Part 15 subpart J class A emission requirements.
14. Each NAE shall be equipped with the necessary un-interruptible power such that it will not cease operation during minor power outages, including those that occur upon transfer to emergency generator or other local power source not provided by the utility.

#### C. MOBILE ACCESS PORTAL GATEWAY

1. Provide one MAP gateway per NCE on project to act as direct interface to NCE. MAP gateway to be permanently mounted in NCE enclosure
2. General: The Mobile Access Portal (MAP) Gateway shall provide a complementary extension to the DDC system user interface requirements previously described in these specifications. The MAP Gateway shall provide an HTML5 browser interface between mobile devices and DDC controllers without the requirement for operational engines or servers. A task specific mobile application shall not be required to use the MAP Gateway.
3. The MAP Gateway shall be a hardware/software device which consists of a combination WiFi Access Point hotspot and user

interface web server, with BACnet MS/TP RS-485 connectivity, and optional Ethernet IP connectivity.

4. The MAP Gateway can be used tether free using its built in WiFi Access Point or it can be connected to an existing building network through the MAP Gateway Ethernet IP port. This feature may also be used to provide remote connectivity for accessing building controls through the site's IT infrastructure.
5. The MAP Gateway shall serve up HTML5 web pages to allow authorized users to view and/or override controller inputs, outputs, setpoints, schedules, trends, and to view and acknowledge alarms via a browser interface.
6. The MAP Gateway shall not require the user to purchase or install any software or applications on the user's smart phone, tablet, PC, or smart device.
7. MAP Functionality: The MAP Gateway shall be capable of serving pre-configured Web Pages to an HTML5 enabled browser. Authorized persons can interact with space and control application set points, alarms, schedules, and trends using a PC, iMac, notebook, smart phone, tablet, or mobile device with WiFi connectivity.
8. The MAP Gateway shall include the following pre-configured user interface web pages linked to real-time data in the field controllers:
  - a. Device List Page:
  - b. Device Home Page:
  - c. Device Alarm Page:
  - d. Point View/ Edit Page:
  - e. Audit Log:
  - f. Tailored Summary:
  - g. Live Trend:
  - h. Airflow Balancing:
9. The MAP Gateway shall include an RS-485 Port configured as BACnet MS/TP Master. Communications with devices and field controllers shall be possible via the following modes; all of these connections will provide access to all controllers on the MS/TP field controller bus:

10. The MAP Gateway power may be supplied via the SAB (sensor/actuator bus), the FCB (field controller bus), or a micro USB port.
11. USB connection: The MAP Gateway shall include a USB Port to provide access to MAP web pages through the USB port for stationary UI configurations or USB connected equipment
12. Multi-Client access: The MAP Gateway shall provide multi-client connectivity for up to three (3) simultaneous users, and shall provide three (3) password protected User Roles with automatic LOGOUT after 30 minutes of inactivity.
13. Security: In order to provide greater security for the enterprise-wide BMS, the Mobile Access Portal (MAP) Gateway shall provide a user interface for interacting with the BMS without connecting to the enterprise-wide BMS. The Wi-Fi Port shall provide WPA2 Security with AES 128 Bit Encryption
14. The MAP Gateway shall be designed to work as a portable device or it may be permanently mounted on site.
15. Stationary: The MAP Gateway shall include a Stationary Mounting Cradle to install the device in a panel. RJ-12 Cable, and an auto-switching 90-230 VAC Power Supply.
16. Provide Johnson Controls MAP Gateway or approved equal

## 2.03 NETWORKING/COMMUNICATIONS:

- A. The design of the Building Automation Control System shall network operator workstations and Standalone DDC Panels as shown on the attached system configuration drawing. Inherent in the system's design shall be the ability to expand or modify the network(s) either via the local area network, or auto-dial telephone line modem connections, or via a combination of the two networking schemes.
  1. Local Area Network
    - a. Workstation/DDC Panel Support: Operator workstations and DDC panels shall directly reside on a local area network such that communications may be executed directly between controllers, directly between workstations, and between controllers and workstations on a peer-to-peer basis.
    - b. Dynamic Data Access: All operator devices, either network resident or connected via dial-up modems, shall have the ability to access all point status and application report data, or execute control functions for any and all other devices via the local area

network. Access to data shall be based upon logical identification of building equipment. Access to system data shall not be restricted by the hardware configuration of the Building Automation Control System. The hardware configuration of the Building Automation Control System network shall be totally transparent to the user when accessing data or developing control programs.

- c. General Network Design: Network design shall include the following provisions:
  - 1) High-speed data transfer rates for alarm reporting, quick report generation from multiple controllers and upload/download efficiency between network devices. The minimum baud rate shall be one (1) Megabaud.
  - 2) Support of any combination of controllers and operator workstations directly connected to the local area network. A minimum of fifty (50) devices shall be supported on a single local area network.
  - 3) Detection and accommodation of single or multiple failures of either workstations, DDC panels or the network media. The network shall include provisions for automatically reconfiguring itself to allow all operational equipment to perform their designated functions as effectively as possible in the event of single or multiple failures.
  - 4) Message and alarm buffering to prevent information from being lost.
  - 5) Error detection, correction, and retransmission to guarantee data integrity.
  - 6) Default device definition to prevent loss of alarms or data, and ensure alarms are reported as quickly as possible in the event an operator device does not respond.
  - 7) Commonly available, multiple sourced, networking components and protocols shall be used to allow the Building Automation Control System to coexist with other networking applications such as office automation. MAP, ETHERNET, IBM Token Ring and ARCNET are acceptable technologies.
  - 8) Use of an industry standard IEEE 802.x protocol. Communications must be of a deterministic nature to assure calculable performance under worst-case network loading.

- 9) Synchronization of the real-time clocks in all DDC panels shall be provided.

#### 2.04 APPLICATION SPECIFIC CONTROLLERS - HVAC APPLICATIONS:

- A. Each Standalone DDC Controller shall be able to extend its performance and capacity through the use of remote Application Specific Controllers (ASCs).
- B. Each ASC shall operate as a standalone controller capable of performing its specified control responsibilities independently of other controllers in the network. Each ASC shall be a microprocessor-based, multi-tasking, real-time digital control processor.
- C. Each ASC shall have sufficient memory to support its own operating system and data base including:
  1. Control Processes
  2. Energy Management Applications
  3. Operator I/O (Portable Service Terminal)
- D. The operator interface to any ASC point data or programs shall be through any network-resident PC workstation, or any PC or portable operator's terminal connected to any DDC panel in the network.
- E. Application Specific Controllers shall directly support the temporary use of a portable service terminal. The capabilities of the portable service terminal shall include but not be limited to the following:
  1. Display temperatures
  2. Display status
  3. Display setpoints
  4. Display control parameters
  5. Override binary output control
  6. Override analog setpoints
  7. Modification of gain and offset constants
- F. Powerfail Protection: All system setpoints, proportional bands, control algorithms, and any other programmable parameters shall be stored such that a power failure of any duration does not necessitate reprogramming the controller.

G. Application Description:

1. Field Equipment Controller (**FEC**) – BY JCI
  - a. When indoors - the FEC shall operate as a standard from 32 to 122 degrees Fahrenheit ambient air temperature and 10 to 90% relative humidity.
  - b. When outdoors mounted either in unit cabinet or mounted in a steel enclosure – the FEC shall operate from -40 to 158 degrees Fahrenheit ambient air temperature and 10 to 90% relative humidity.
  - c. The Field Equipment Controller (FEC) shall be a fully user-programmable, digital controller that communicates via BACnet MS/TP protocol.
  - d. The FEC shall employ a finite state control engine to eliminate unnecessary conflicts between control functions at crossover points in their operational sequences. Suppliers using non-state based DDC shall provide separate control strategy diagrams for all controlled functions in their submittals.
  - e. Controllers shall be factory programmed with a continuous adaptive tuning algorithm that senses changes in the physical environment and continually adjusts loop tuning parameters appropriately. Controllers that require manual tuning of loops or perform automatic tuning on command only shall not be acceptable.
  - f. The FEC shall be assembled in a plenum-rated plastic housing with flammability rated to UL94-5VB.
  - g. The FEC shall include a removable base to allow pre-wiring without the controller.
  - h. The FEC shall include troubleshooting LED indicators to identify the following conditions:
    - 1) Power On
    - 2) Power Off
    - 3) Download or Startup in progress, not ready for normal operation
    - 4) No Faults
    - 5) Device Fault
    - 6) Field Controller Bus - Normal Data Transmission
    - 7) Field Controller Bus - No Data Transmission
    - 8) Field Controller Bus - No Communication
    - 9) Sensor-Actuator Bus - Normal Data Transmission

- 10) Sensor-Actuator Bus - No Data Transmission
- 11) Sensor-Actuator Bus - No Communication
- i. The FEC shall accommodate the direct wiring of analog and binary I/O field points.
- j. The FEC shall support the following types of inputs and outputs:
  - 1) Universal Inputs - shall be configured to monitor any of the following:
    - a) Analog Input, Voltage Mode
    - b) Analog Input, Current Mode
    - c) Analog Input, Resistive Mode
    - d) Binary Input, Dry Contact Maintained Mode
    - e) Binary Input, Pulse Counter Mode
  - 2) Binary Inputs - shall be configured to monitor either of the following:
    - a) Dry Contact Maintained Mode
    - b) Pulse Counter Mode
  - 3) Analog Outputs - shall be configured to output either of the following
    - a) Analog Output, Voltage Mode
    - b) Analog Output, current Mode
  - 4) Binary Outputs - shall output the following:
    - a) 24 VAC Triac
  - 5) Configurable Outputs - shall be capable of the following:
    - a) Analog Output, Voltage Mode
    - b) Binary Output Mode
- k. The FEC shall have the ability to reside on a Field Controller Bus (FC Bus).
  - 1) The FC Bus shall be a Master-Slave/Token-Passing (MS/TP) Bus supporting BACnet Standard protocol SSPC-135, Clause 9.
  - 2) The FC Bus shall support communications between the FECs and the NAE.
  - 3) The FC Bus shall also support Input/Output Module (IOM) communications with the FEC and with the NAE.
  - 4) The FC Bus shall support a minimum of 100 IOMs and FEC in any combination.
  - 5) The FC Bus shall operate at a maximum distance of 15,000 Ft. between the FEC and the furthest connected device.
- l. The FEC shall have the ability to monitor and control a network of sensors and actuators over a Sensor-Actuator Bus (SA Bus).
  - 1) The SA Bus shall be a Master-Slave/Token-Passing (MS/TP) Bus supporting BACnet Standard protocol SSPC-135, Clause 9.

- 2) The SA Bus shall support a minimum of 10 devices per trunk.
  - 3) The SA Bus shall operate at a maximum distance of 1,200 Ft. between the FEC and the furthest connected device.
- m. The FEC shall have the capability to execute complex control sequences involving direct wired I/O points as well as input and output devices communicating over the FC Bus or the SA Bus.
  - n. The FEC shall support, but not be limited to, the following:
    - 1) Hot water, chilled water/central plant applications
    - 2) Built-up air handling units for special applications
  - o. Terminal units
    - 1) Special programs as required for systems control

#### H. Field Devices

1. Input/Output Module (**IOM**) – BY JCI
  - a. The IOM shall operate as a standard from 32 to 122 degrees Fahrenheit ambient air temperature and 10 to 90% relative humidity
  - b. The Input/Output Module (IOM) provides additional inputs and outputs for use in the FEC.
  - c. The IOM shall communicate with the FEC over either the FC Bus or the SA Bus using BACnet Standard protocol SSPC-135, Clause 9.
  - d. The IOM shall be assembled in a plenum-rated plastic housing with flammability rated to UL94-5VB.
  - e. The IOM shall have a minimum of 4 points to a maximum of 17 points.
  - f. The IOM shall support the following types of inputs and outputs:
    - 1) Universal Inputs - shall be configured to monitor any of the following:
      - a) Analog Input, Voltage Mode
      - b) Analog Input, Current Mode
      - c) Analog Input, Resistive Mode
      - d) Binary Input, Dry Contact Maintained Mode
      - e) Binary Input, Pulse Counter Mode
    - 2) Binary Inputs - shall be configured to monitor either of the following:
      - a) Dry Contact Maintained Mode

- b) Pulse Counter Mode
- 3) Analog Outputs - shall be configured to output either of the following
  - a) Analog Output, Voltage Mode
  - b) Analog Output, current Mode
- 4) Binary Outputs - shall output the following:
  - a) 24 VAC Triac
- 5) Configurable Outputs - shall be capable of the following:
  - a) Analog Output, Voltage Mode
  - b) Binary Output Mode
- g. The IOM shall include troubleshooting LED indicators to identify the following conditions:
  - 1) Power On
  - 2) Power Off
  - 3) Download or Startup in progress, not ready for normal operation
  - 4) No Faults
  - 5) Device Fault
  - 6) Normal Data Transmission
  - 7) No Data Transmission
  - 8) No Communication

## 2. Network Sensors (NS)

- a. The Network Sensors (NS) shall have the ability to monitor the following variables as required by the systems sequence of operations:
  - 1) Zone Temperature
  - 2) Zone Humidity
  - 3) Zone Setpoint
- b. The NS shall transmit the zone information back to the controller on the Sensor-Actuator Bus (SA Bus) using BACnet Standard protocol SSPC-135, Clause 9.
- c. The Network Sensors shall include the following items:
  - 1) An LED to indicate the status of the Override feature.
  - 2) A button to initiate a timed override command
- d. The NS shall be available with either screw terminals or phone jack.
- e. The NS shall be available in either surface mount or wall mount styles.

## 2.05 TEMPERATURE CONTROL MATERIAL:

### A. PANEL DEVICES

PART #	DESCRIPTION	MFTR
DCP-1.5-W	1.5 AMP POWER SUPPLY	KELE
DPT2640-005D	PRESSURE SENS, DP, 0-5"WC	SETRA
RH2B-UAC24-L	DPDT, 10A, HC=24 VAC, W/LED	IDEC
SH2B-05	DPDT RELAY BASE FOR RH2B	IDEC
RH4B-UAC24V	4PDT, 10A, HC=24 VAC	IDEC
SH4B-05	4PDT RELAY BASE FOR RH4B	IDEC
PXPLX01S	DP TRANSDUCER, AIR, 0-1"	VERIS
1900-5MR	HIGH STATIC PRESS. SWITCH	DWYER
BAM2	TB END STOP	KELE
FEM6	TB END STOP SECTION	KELE
M4/6	TERMINAL BLOCK	KELE
RC610B	TB BLANK MARKING STRIPS	KELE
Y65A13-0	120VAC/24VAC, FOOT, 40VA	JCI
Y65A21-0	120VAC/24VAC, PLATE, 40VA	JCI

### B. TRANSDUCERS

PART #	DESCRIPTION	MFTR
A-306	OUTDOOR AIR STATIC	KELE
DPT-2015-1	DIFF PRESS TRANSMITTER	JCI
DPT2090-250G	PRESS SENS, GAGE, 250 PSI, VDC	SETRA
DPT2640-0R1B	PRESS SENS, DP, -0.1-0.1"WC, VDC	SETRA
DPT2640-2R5D	PRESS SENS, DP, 0-2.5"WC, VDC	SETRA
FTG18A-600R	REMOTE MTD PROBE	JCI
PWLX03S	DIFF PRESS, WATER, 0-25PSI	VERIS

### C. SENSORS

PART #	DESCRIPTION	MFTR
TE-6000-1	SENSOR, T-NI, 1.0%, STRAP-ON	JCI
TE-6001-3	KIT, MTG BOX FOR WZ-1000 WELL	JCI
TE-6313P-1	SENSOR, T-NI 0.1%, 3IN OAT	JCI
TE-6316P-1	SENSOR, T-NI, 0.1%, 17FT AVG	JCI
TE-6311V-2	DUCT PROBE TEMP. SEN. 1K	JCI
TE-67NP-0N00	SENSOR, RM, 1K, NI, PHONE JACK	JCI
TE-67NT-0N00	TEMP SENSOR 1K NICKEL	JCI
NS-BTP7002-0	ZONE TEMP SENSOR/SETPT	JCI
NS-BTP7003-0	ADDRESSABLE ZONE TEMP	JCI
NS-BCN7004-0	CO2 SENSOR	JCI
A/1KHT-2W-RP	REMOTE PROBE, -40-842, PT, 1K	JCI
A11A-1C	PLN, MLT, SP=35-45 F, STG=1	JCI
TEC-2601-4	1 HEAT/1 COOL BACnet STAT	JCI
LX-24	CEILING MOUNT OCC SENSOR	KELE
ST-S63-XH	S.S ZONE TEMP WITH OCC OVR	KELE

D. **FIELD DEVICES**

<b>PART #</b>	<b>DESCRIPTION</b>	<b>MFTR</b>
H922	CURRENT SENSOR, SPLIT	VERIS
ST-S63-XM	STAINLESS STEEL ZONE TEMP	KELE
TS-400-24-W	DIGITAL TIME SWITCH	KELE
TS-470	END SWITCH, NO	KELE
WZ-1000-5	WELL, BRASS, 2-3/8 IN, 1/2 IN NPT	JCI
M9104-AGS-2N	ELEC, INCR, NSR, TQ=35	JCI
M9220-BGA-3	DAMPER ACTUATOR 20 NM SR	JCI
MS-FEC2611-0ET	OUTDOOR FEC	JCI
MS-FEC2611	INDOOR FEC	JCI
MS-NAE4510-2	MEDIUM CAPACITY NAE	JCI
MS-NAE5510-2	HIGH CAPACITY NAE	JCI

E. **VALVES**

<b>PART #</b>	<b>DESCRIPTION</b>	<b>MFTR</b>
VG1000	BALL VALVE (1/2"-4")	JCI
VG2000	GLOBE VALVE (2 1/2" – 6")	JCI
VG7000	GLOBE VALVE (1/2" – 2")	JCI
VFC	BUTTERFLY VALVE (2" – 20")	JCI

Control Valves: Minimum pressure drop at rated flow shall be 2 psig.


- F. Motorized Control Dampers: Shall be parallel blade for two-position control and opposed blade for proportional control applications. Dampers shall have an enamel finish or be galvanized, with nylon bearings. Blade edge and tip seals shall be included for all dampers. Blade shall be double piece 22 gauge minimum and 8" wide maximum and frame shall be welded channel iron.

- G. Temperature control panels (TCP): Shall be of NEMA code gauge steel with locking doors for mounting all devices as shown. They shall meet all applicable requirements of Title 24, California Code of Regulations. All controllers, relays, switches, etc. for equipment located in mechanical equipment rooms shall be mounted in a TCP as shown on the drawings. Temperature settings, adjustments and calibration shall be done at the TCP. Any required UCMC Campus Data networks connection for this panel shall be installed inside the panel. All electric devices within a control panel shall be factory pre-piped and wired. Provide engraved laminated plastic nameplates identifying all devices mounted on the face of the control panels. A complete set of related "as-builts" control drawings shall be furnished in each control panel.

## 2.06 GRAPHIC INTERFACE

- A. The following are examples of the district wide standard for the graphical interface of the controls system. The new controls system must be graphically represented according to the following templates


1. District Map View

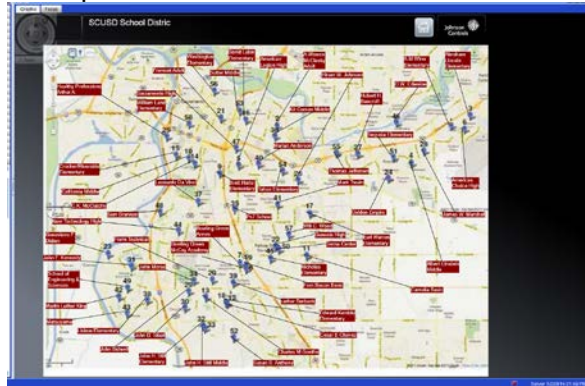


2. School Overview



3. Zone Overview

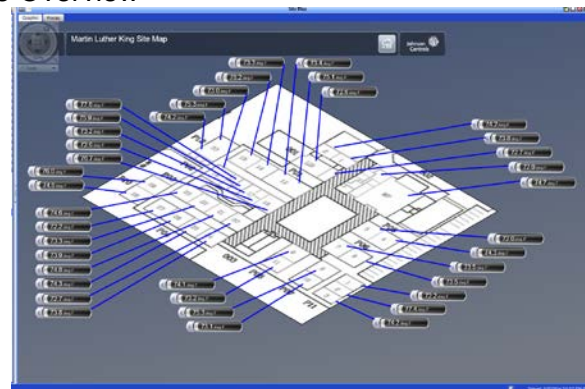

#### 4. Equipment Overview

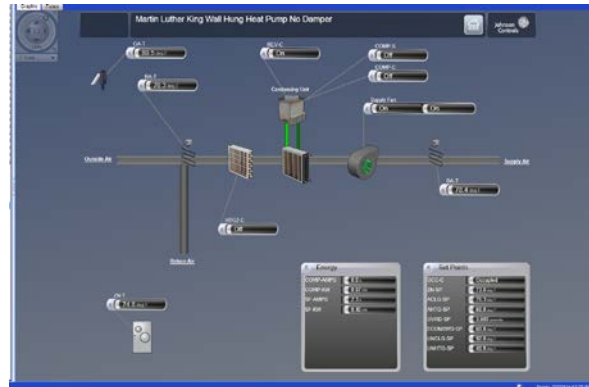

### 2.07 CONSULTATIVE SUPPORT

- A. For this project, the manufacturer shall provide at a minimum 8 hours of consultative support services to review and provide recommendations and enhancements to the system, which may include:
1. Review of critical programming loops and adjustments as necessary
  2. Adjustments to improve building system operation, reduce energy consumption and/or improve environmental control
  3. Implementation or enhancement of functionality in the system

### 2.08 MISCELLANEOUS DEVICES

- A. Moisture Sensors:
1. Moisture sensors shall be used to detect water in elevator sumps and chilled water fan coil unit overflow drain pans and where otherwise indicated on the Drawings using George Risk Industries Model GRI 2650, Veris MX Series, or equal.
  2. The sensor shall be floor mounted operating at 24 VAC with SPDT relay for the output signal with automatic reset.

## **PART 3 - EXECUTION**

### **3.01 GENERAL:**

- A. Furnish all labor, materials, equipment, and service necessary for a complete and operating Direct Digital Control Building Automation Control System, as shown on the drawings and described herein.
- B. All labor, material, equipment, and software necessary to meet the functional intent of the Building Automation Control System as specified herein and as shown on the drawings shall be included.
- C. Drawings are diagrammatic only. Equipment and labor not specifically referred to herein, or on the plans, that are required to meet the functional intent of the Building Automation Control System, shall be provided without additional cost to Sac City Unified School District.
- D. Equipment furnished by Electrical and/or Mechanical Contractor that is normally wired before installation shall be furnished completely wired. Wiring normally performed in field shall be furnished and installed by the Building Automation Control System contractor.
- E. Control equipment having electrical connections only, which are furnished under this work, shall be installed and connected by the Building Automation Control System contractor. Electrical devices requiring wet side piping connections shall be installed by the Mechanical Contractor.
- F. Clearly identify and label equipment and controls, such as starters, switches, relays, as to function and position with permanently engraved plastic nameplates.
- G. Wiring of control equipment in accordance with wiring diagrams and functional operation of the control system shall be the responsibility of the Building Automation Control System contractor.
- H. Final Adjustment of Equipment: After completion of installation, adjust temperature sensors, control valves, actuators, motors, and similar equipment provided under the scope of work of this section. Cooperate with the air balance contractor as required.
- I. Perform final adjustment by specially trained personnel in direct employ by the manufacturer of the primary Building Automation Control System.
- J. Connect control valves with threaded connections with sufficient unions to permit valves to be readily removed from their installed locations for servicing, without disturbing adjacent piping. In no case shall this be less than three unions for three-way valves and one union for two-way valves.

- K. Wiring and raceways included with the BACS scope of works includes but is not limited to the following:
1. Power wiring for all controllers, sensors, relays and other equipment shall be taken from the local HVAC controls panels except equipment provided with dedicated supplies provided by Division 26.
  2. Controls wiring shall be routed from the local HVAC controls panels.
  3. Conduit shall be used for the following:
    - a. All exposed and concealed low voltage wiring in all areas below 8 feet above floor level.
    - b. All mechanical and equipment rooms, exterior locations and any other areas where physical protection and/or access is required as defined elsewhere in the contract documents.
    - c. All in-wall drops to equipment monitoring and/or control points including but not limited to medical equipment, kitchen service equipment, elevator sump and other moisture sensors, water flow meters, equipment mounted alarms, etc.
    - d. All areas where specifically indicated on the Drawings.
  4. J-Hooks and or designated LV raceway shall be used for the following:
    - a. All low voltage wiring above 8 feet above floor level in open and accessible areas where conduit is not required, to cable trays or other conduits.
    - b. All areas where specifically indicated on the Drawings.
  5. Conduit and J-Hook materials and installation requirements shall comply with the applicable sections of Division 26 unless specifically indicated otherwise on the Drawings.

### 3.02 WARRANTY:

- A. The Building Automation Control System contractor shall provide a one-year warranty covering the Building Automation Control System, and all associated components installed by the Building Automation Control System contractor. Any manufacturing or installation defects arising during this warranty period shall be corrected without cost to the Owner. The Building Automation Control System contractor shall respond to the job site within a four (4) hour period for any emergency relating to the control system and associated components installed by the Building Automation

Control System contractor. Warranty period shall commence after all operator instruction is completed and the entire system has been accepted by the Owner.

### 3.03 CARE AND CLEANING:

- A. Repair or replace broken, damaged, or otherwise defective parts, materials, and work. Leave entire work in condition satisfactory to Owner's Representative. At completion, carefully clean and adjust equipment, fixtures, and trim installed as part of this work. Leave systems and equipment in satisfactory operating condition.

### 3.04 OPERATION TEST/SYSTEM COMMISSIONING:

- A. Each piece of equipment shall be tested by the Building Automation Control System contractor to show that it will operate in accordance with designed requirements, and provide written documentation of this test. Control system commissioning shall consist of a point per point conformation and system operational demonstration conducted jointly by the Building Automation Control System contractor and the University's Representative.
- B. The mechanical contractor and BACS contractor/vendor will conduct two levels of Quality Assurance to verify that the required installation and performance of the Building Automation Control System as been met.
  - 1. Static Commissioning:
    - a. A point to point examination and documentation of the successful installation of the BACS system and its components in its entirety.
    - b. The start up of all HVAC equipment and associated systems will not commence until this work has been completed and the documentation received by the Owner.
  - 2. Dynamic Commissioning:
    - a. A point by point demonstration and documentation of the successful performance of the BACS system and its components in its entirety.
    - b. The verification demonstrations of all HVAC equipment and associated systems will not commence until this work has been completed and the documentation received by the Owner.
- C. All new controller programming shall be backed up into the districts existing database.

- D. As part of the operational test's the controls contractor shall demonstrate integration of new controls system into the existing server and BACS.
- E. In General the Commissioning process will comprise the following:
  - 1. Review of points list and documentation.
  - 2. Installation compliance with project plans and specifications.
  - 3. Point-to-point check.
  - 4. Control devices calibration and operation.
  - 5. System programming and documentation.
  - 6. System endurance test.
  - 7. Control loop trends.
  - 8. Reports and alarms.
  - 9. Analog input calibration.
  - 10. Analog output check and spring ranges.
  - 11. Digital input range set points.
  - 12. Digital output in autolog.
  - 13. Point by point performance verification.
  - 14. O & M training and documentation.
  - 15. Opposite season verification and documentation.
  - 16. Review and document system architecture.
- F. Prior to job closing, the controls contractor must provide and present drawings showing the physical location of the new Field Control bus routing around the campus. This will be reviewed by district HVAC personnel.

### 3.05 OPERATOR INSTRUCTION:

- A. During system commissioning and at such time acceptable performance of the Building Automation Control System hardware and software has been established, the Control Contractor shall schedule with the Owner's Representative and provide eight (8) hours of on site, or off site, operator instruction to the Owner's operating personnel. Operator instruction during normal working hours shall be performed by a competent representative familiar with the systems hardware, software, and accessories


END OF SECTION 23 09 00




5/22/2018 4:12:11 C:\Users\A\hamilton\Desktop\Revit\5077\_Hiram Johnson HVAC\5077\_Hiram Johnson HVAC\_sabanzo\_17.rvt




IF THIS SHEET IS NOT 30"x42", IT IS  
A REDUCED PRINT SCALE ACCORDINGLY

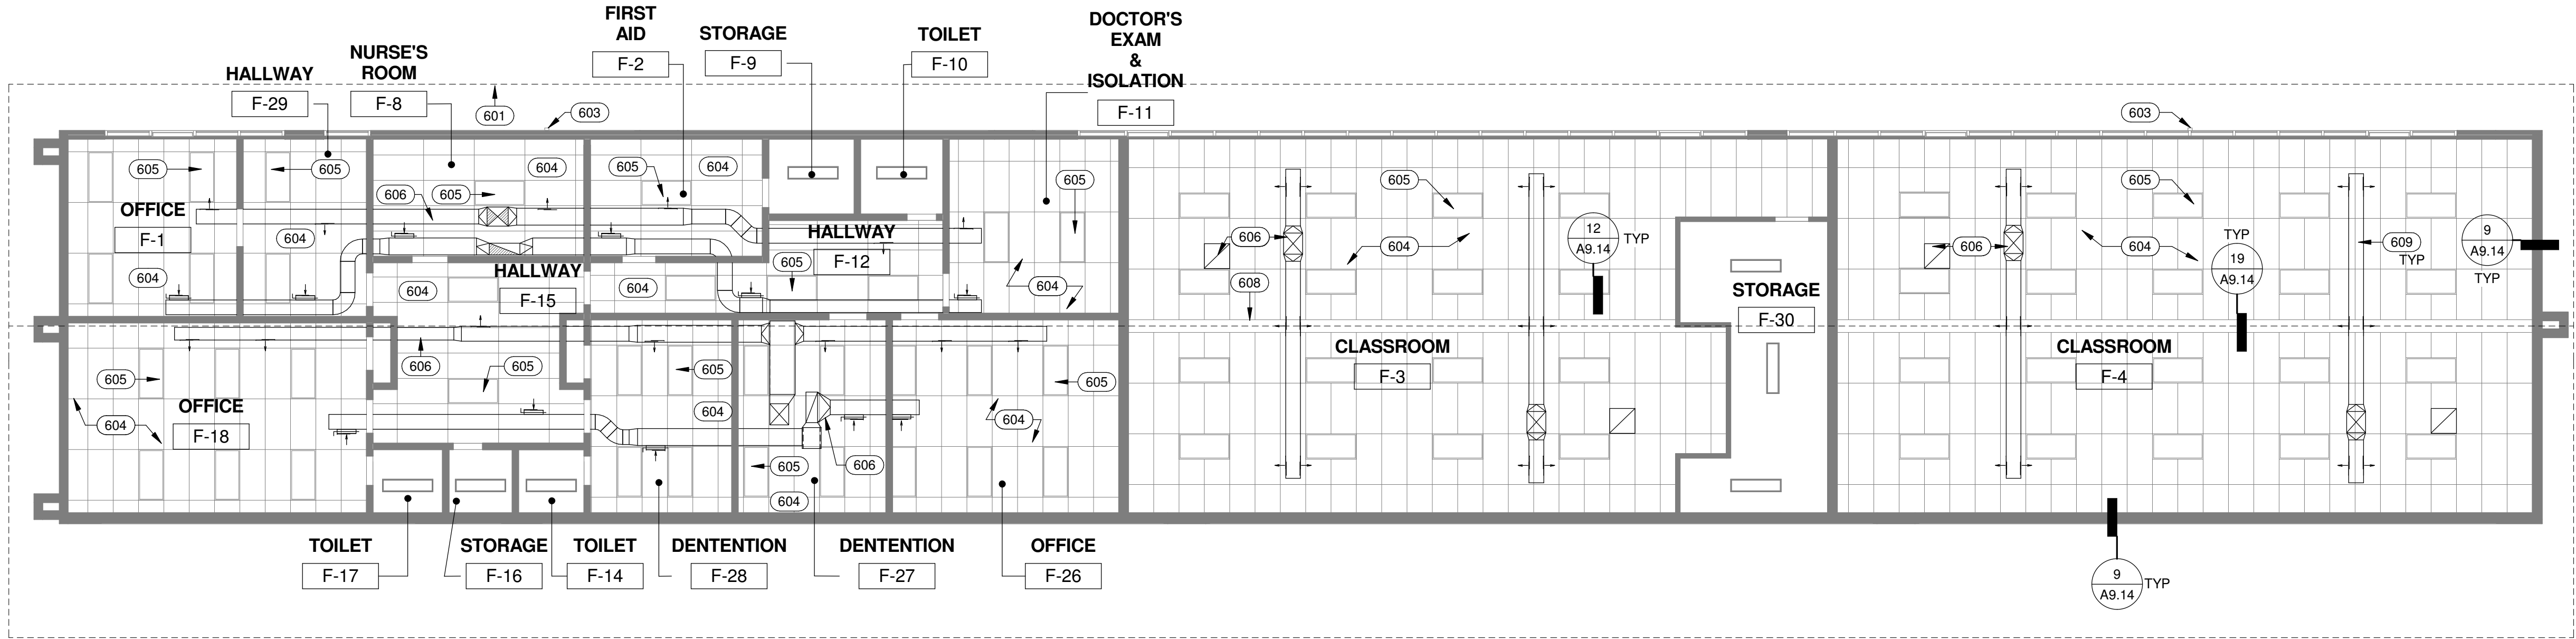


4 BUILDING F - WEST WING - REFLECTED CEILING PLAN  
1/8" = 1'-0"

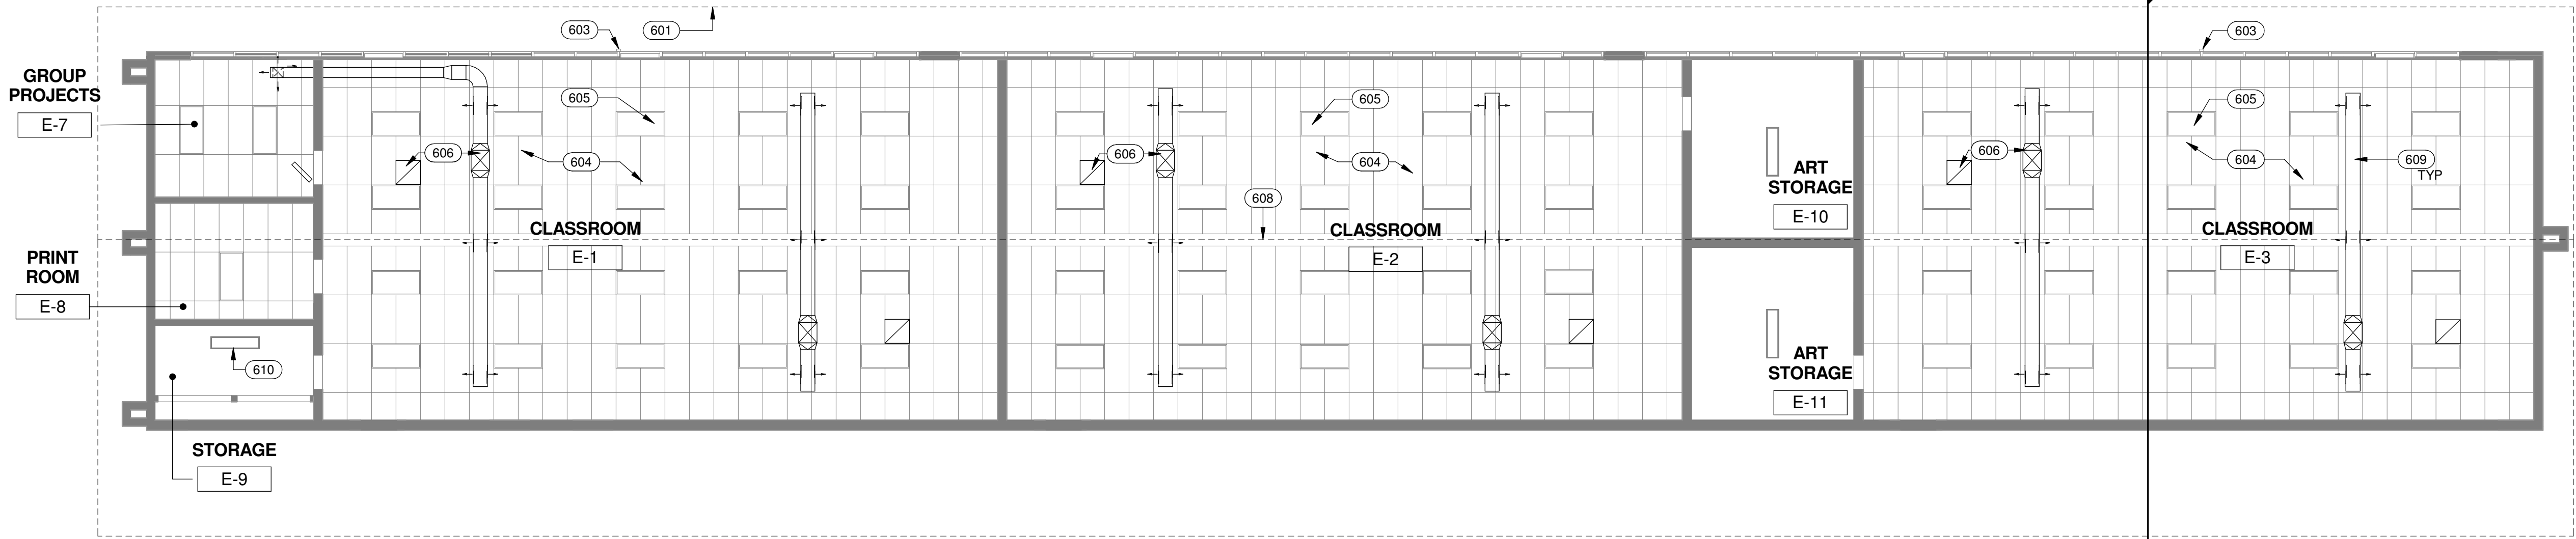

3 BUILDING E - WEST WING - REFLECTED CEILING PLAN  
1/8" = 1'-0"

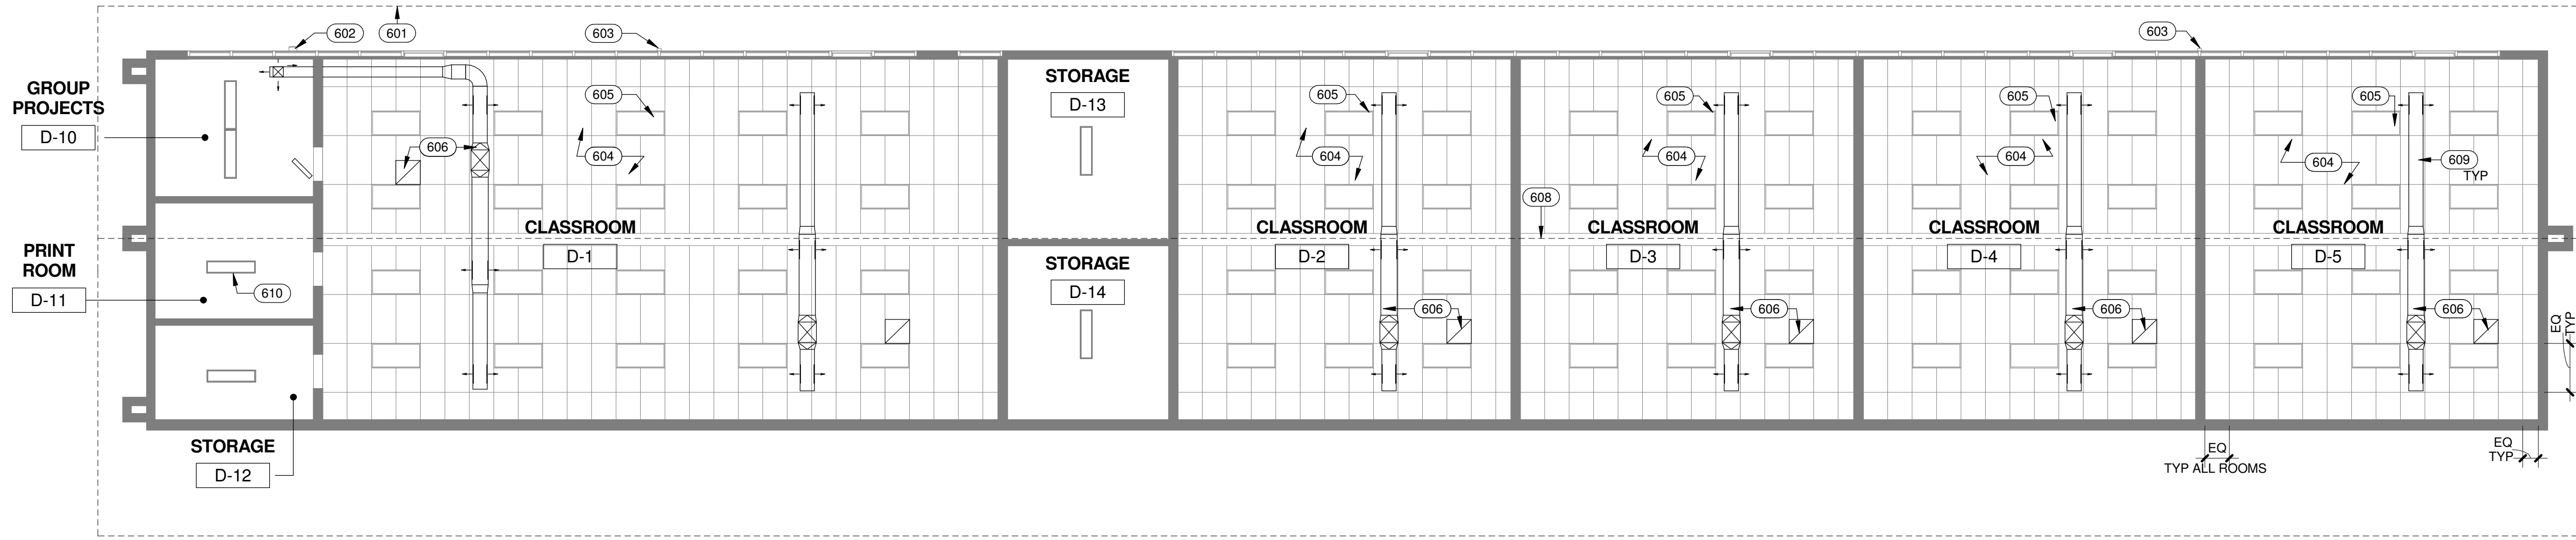

2 BUILDING D - WEST WING - REFLECTED CEILING PLAN  
1/8" = 1'-0"

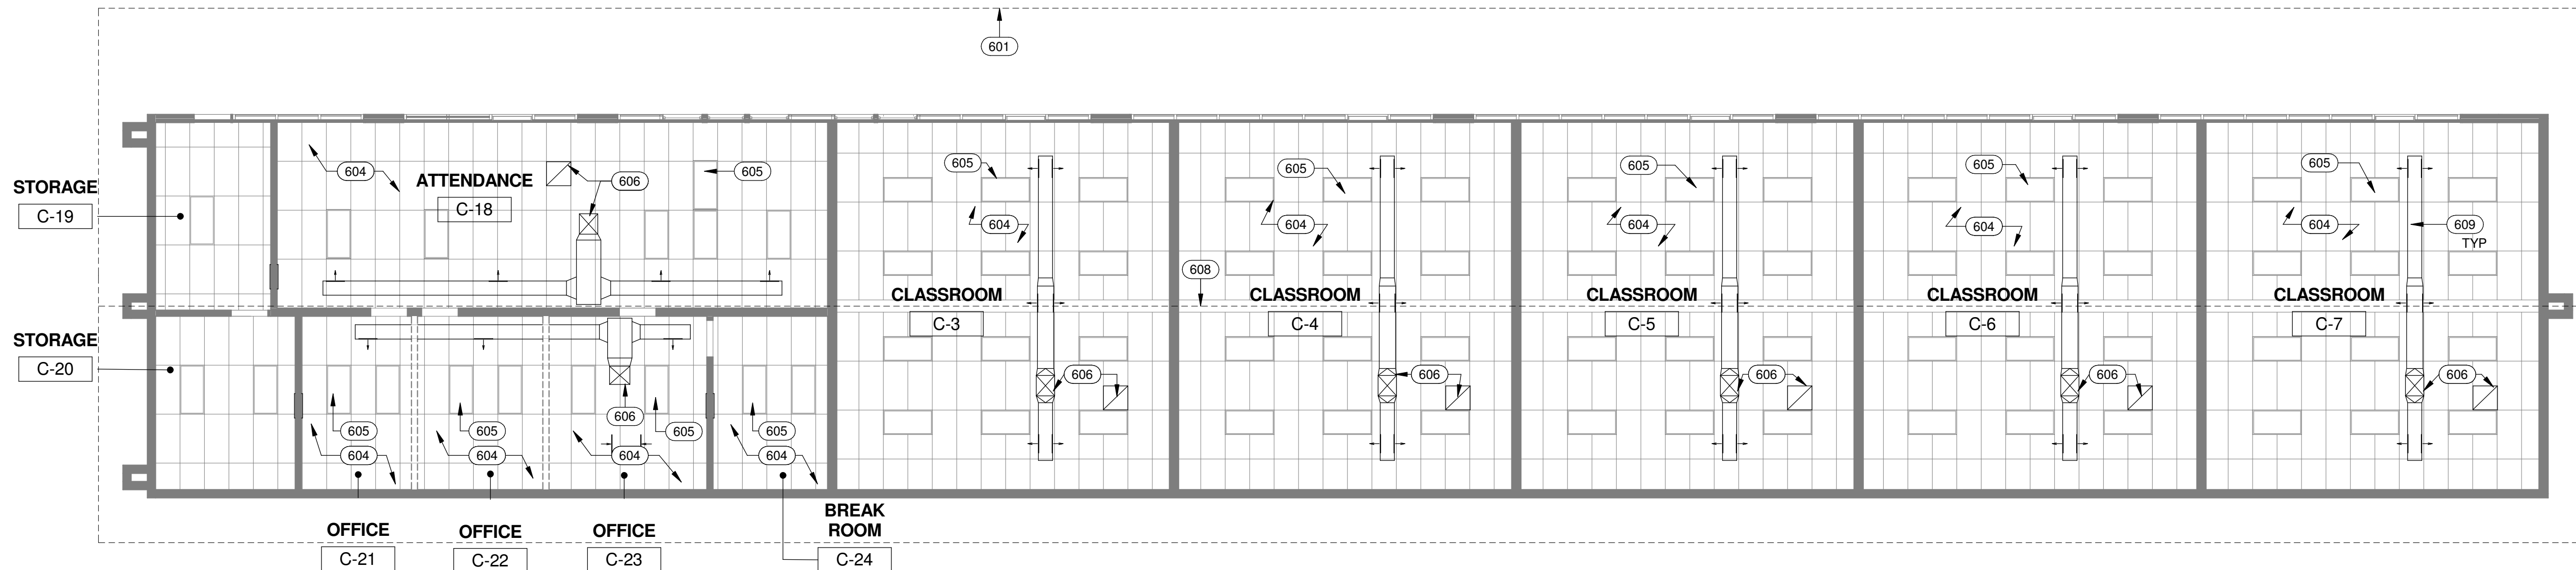

1 BUILDING C - WEST WING - REFLECTED CEILING PLAN  
1/8" = 1'-0"

## GENERAL NOTES

1. ALL NOTES ARE TYPICAL, UNON
2. SEE ELECTRICAL DRAWINGS FOR ADDITIONAL INFORMATION.
3. PATCH AND REPAIR WALLS AS AFFECTED BY NEW WORK.
4. SEE SHEET A9.14 FOR ADDITIONAL CEILING DETAILS AND NOTES.

## KEYNOTES

- 601 LINE OF ROOF OVERHANG, TYP
- 602 (E) SPEAKER TO REMAIN, TYP
- 603 (E) TYPE ALARM HORN TO REMAIN, TYP
- 604 (N) 2'x4' ACOUSTICAL CEILING TILES, SEE A9.14 FOR DETAILS
- 605 (N) 2'x4' LIGHTS, SED
- 606 (N) HVAC RETURN AND SUSPENDED DUCTWORK TYP, SMD
- 608 (E) RIDGE LINE, TYP
- 609 (N) SUSPENDED DUCTWORK TO BE PAINTED, COLOR AS SELECTED BY ARCHITECT
- 610 (E) 1'x4' LIGHTS TO REMAIN, TYP

## LEGEND

- (E) WALLS TO REMAIN
- PARTIAL HEIGHT (E) WALLS TO REMAIN
- (E) 1' x 4' LIGHTS TO REMAIN
- 2' x 4' LIGHTS, SED
- HVAC RETURN, SMD
- SUSPENDED DUCT, SMD



Revisions				
No.	Revisions	By	Date	Appr.
1	Addendum #2		5/22/18	

## BACKCHECK SET

ISSUE DATE: 4/17/18 BY: AA

## DSA APPROVAL

This document is the property of the Owner and is not to be used without his written permission.

Architect/Engineer Of Record:



**HIBER YAMAUCHI**  
Architects, Inc.  
4602 2nd Street, Suite 3  
Davis, CA 95618  
530.758.1270 tel | 530.758.4789 fax  
HY Architects Project number: 5077

Facility  
HIRAM JOHNSON HIGH SCHOOL  
6879 14th Ave, Sacramento, CA 95820

Project  
HVAC UPGRADE

Sheet Title  
REFLECTED CEILING PLANS -  
WEST WING

Client Project Number: Client Proj. #

Scale: As indicated


Drawn By: AA

Checked By: JM


Issue Date: 4/17/18

Revit Version: 2017


Sheet  
**A6.11**  
Sheet 2 of 200

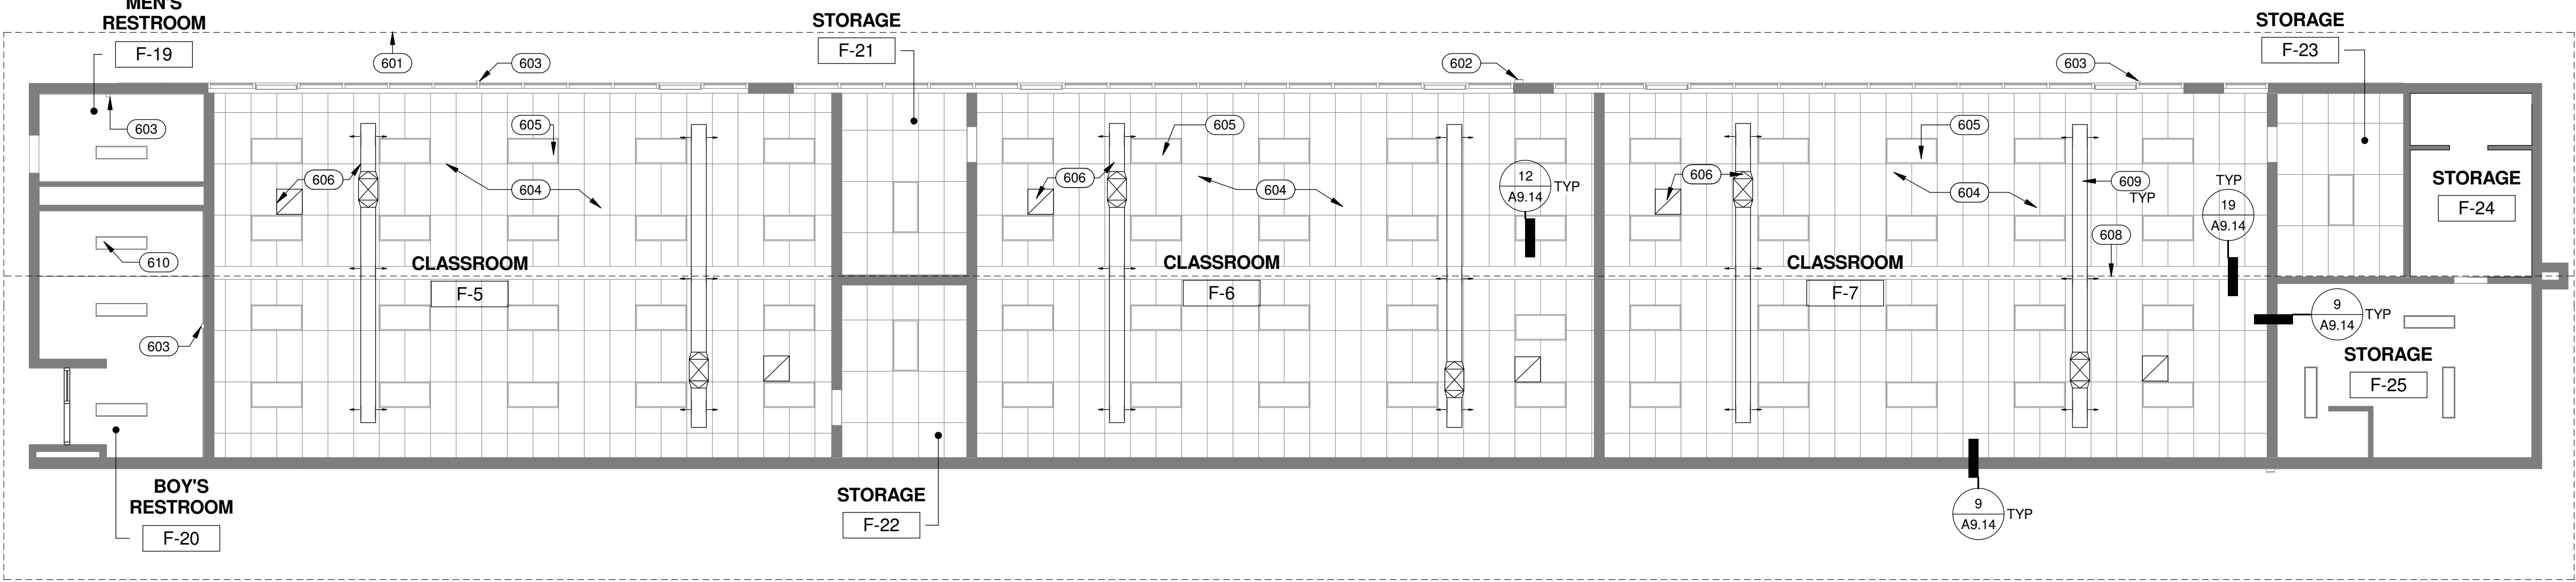


4 BUILDING F - EAST WING - REFLECTED CEILING PLAN  
1/8" = 1'-0"

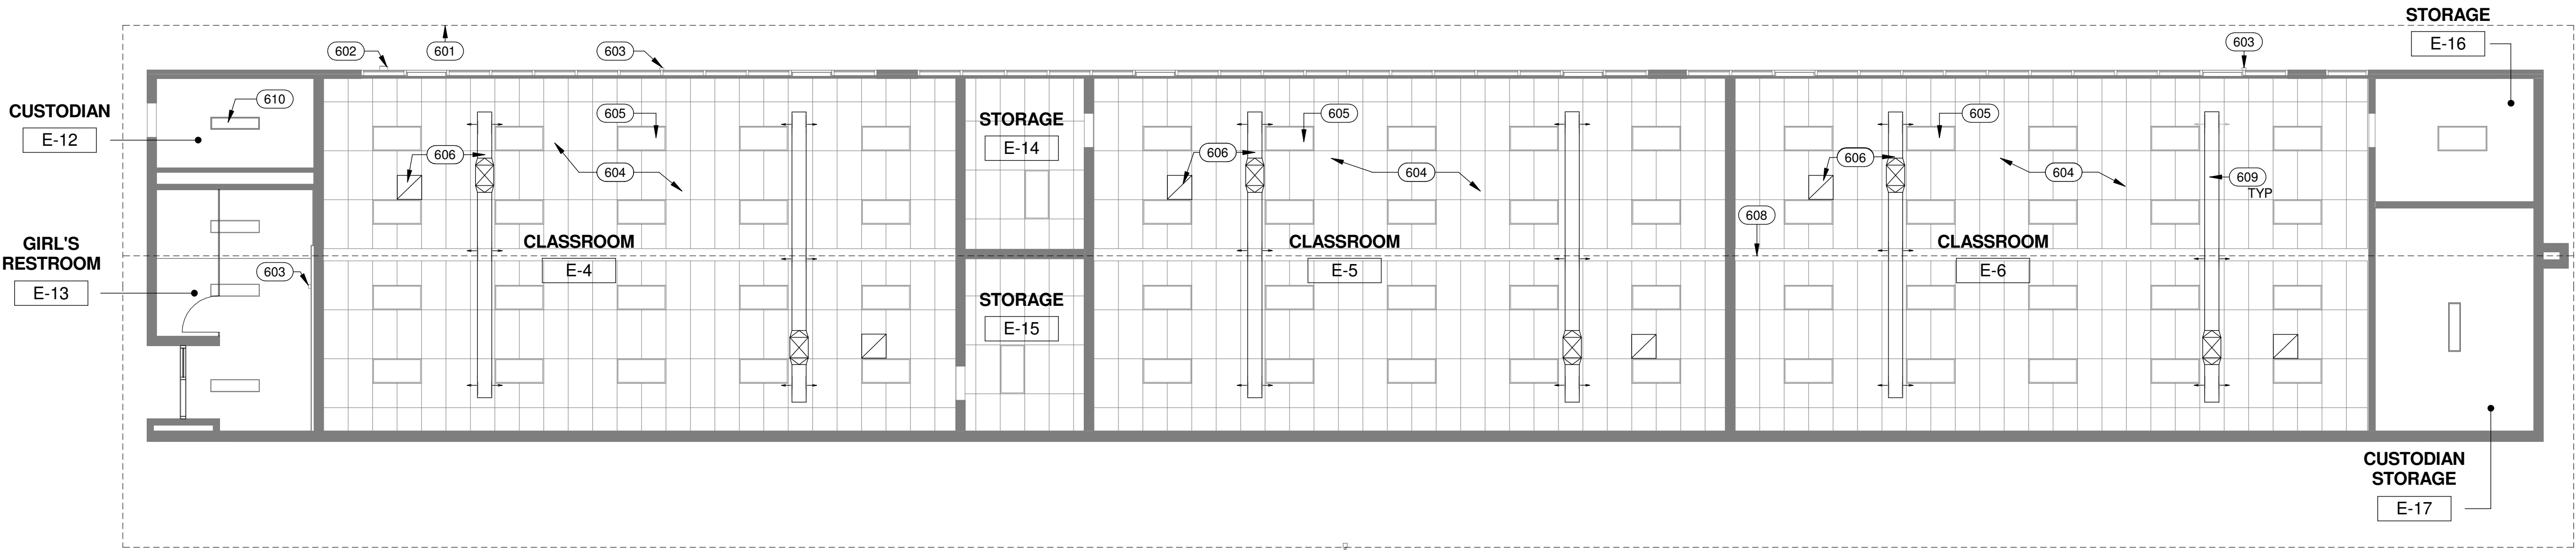

3 BUILDING E - EAST WING - REFLECTED CEILING PLAN  
1/8" = 1'-0"

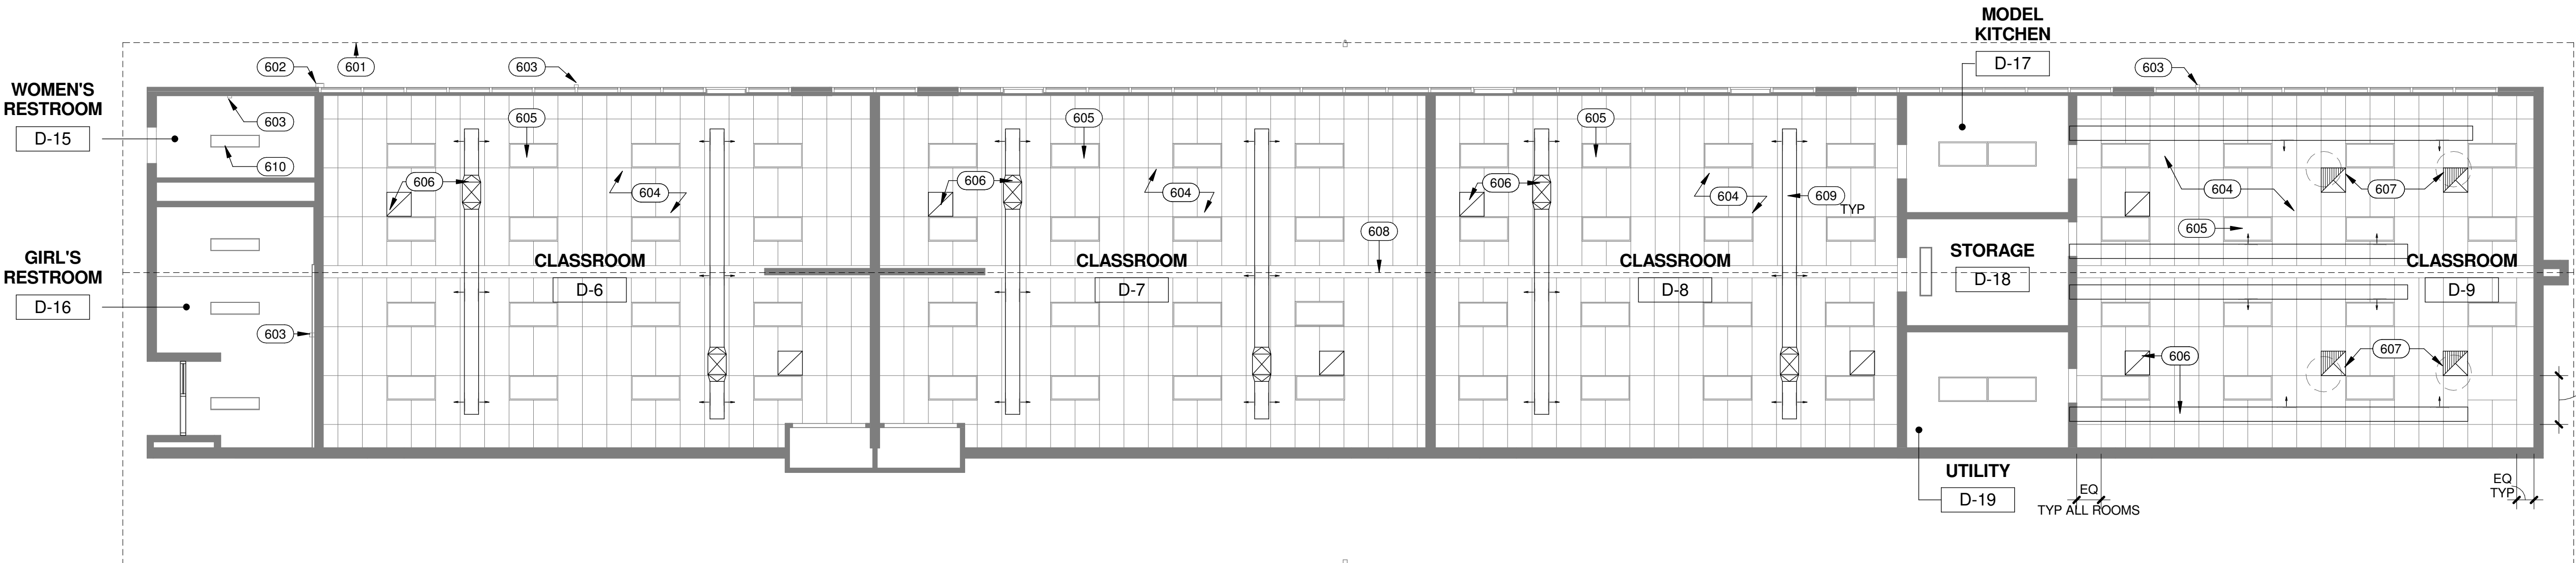

2 BUILDING D - EAST WING - REFLECTED CEILING PLAN  
1/8" = 1'-0"

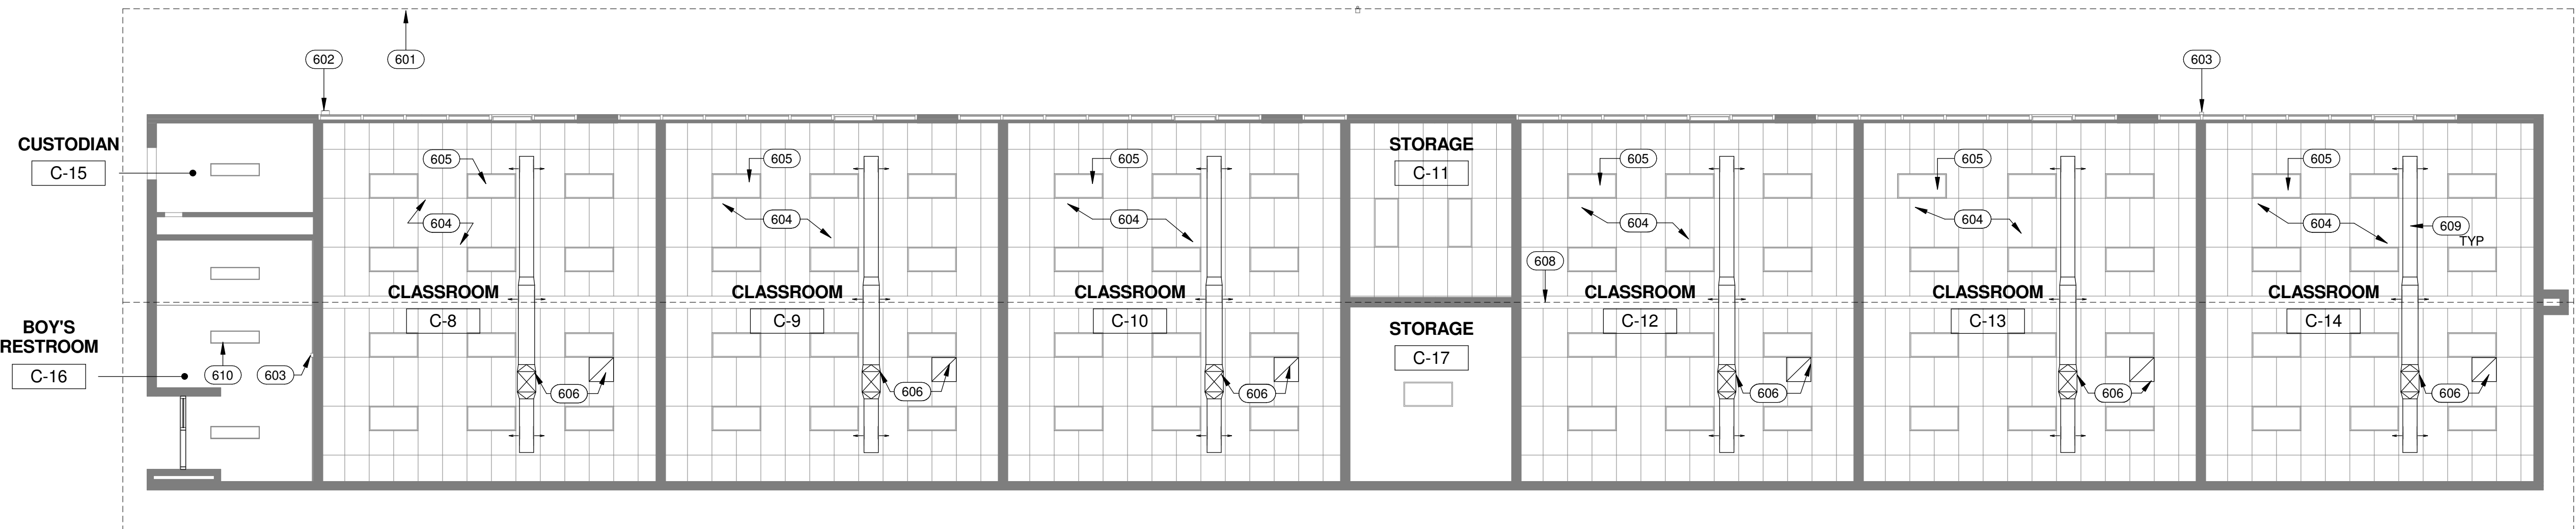

1 BUILDING C - EAST WING - REFLECTED CEILING PLAN  
1/8" = 1'-0"

## GENERAL NOTES

1. ALL NOTES ARE TYPICAL, UNLESS OTHERWISE NOTED.
2. SEE ELECTRICAL DRAWINGS FOR ADDITIONAL INFORMATION.
3. PATCH AND REPAIR WALLS AS AFFECTED BY NEW WORK.
4. SEE SHEET A9.14 FOR ADDITIONAL CEILING DETAILS AND NOTES.

## KEYNOTES

- 601 LINE OF ROOF OVERHANG, TYP
- 602 (E) SPEAKER TO REMAIN, TYP
- 603 (E) FIRE ALARM HORN TO REMAIN, TYP
- 604 (N) 2X4 ACOUSTICAL CEILING TILES, SEE A9.14 FOR DETAILS.
- 605 (N) 2X4 LIGHTS, SED
- 606 (N) HVAC RETURN AND SUSPENDED DUCTWORK TYP, SMD
- 607 (E) EXHAUST FANS TYP, SMD
- 608 (E) RIDGE LINE, TYP
- 609 (N) SUSPENDED DUCTWORK TO BE PAINTED, COLOR AS SELECTED BY ARCHITECT
- 610 (E) 1X4 LIGHTS TO REMAIN, TYP



Revisions				
No.	Revisions	By	Date	Appr.
1	Addendum #2		5/22/18	

## BACKCHECK SET

ISSUE DATE: 4/17/18 BY: AA

## DSA APPROVAL

This document is the property of the Owner and is not to be used without his written permission.  
Architect/Engineer Of Record:



## LEGEND

- (E) WALLS TO REMAIN
- PARTIAL HEIGHT (E) WALLS TO REMAIN
- (E) 1 x 4 LIGHTS TO REMAIN
- 2 x 4 LIGHTS, SED
- HVAC RETURN, SMD
- SUSPENDED DUCT, SMD



4602 2nd Street, Suite 3  
Davis, CA 95618  
530.758.1270 tel | 530.758.4789 fax  
HY Architects Project number: 5077  
Facility

HIRAM JOHNSON HIGH SCHOOL

6879 14th Ave, Sacramento, CA 95820

Project

HVAC UPGRADE

Sheet Title

REFLECTED CEILING PLANS - EAST WING

Client Project Number: Client Proj. #

Scale: As indicated

Drawn By: AA

Checked By: JM

Issue Date: 4/17/18

Revit Version: 2017

Sheet  
A6.12

Sheet 2 of 200



DIFFUSER, REGISTER, & GRILLE SCHEDULE	
<div>EXAMPLE OF CALLOUT:</div> <div><div>SIZE</div><div>TYPE</div><div>SIZE OF BRANCH DUCT TO DIFFUSER</div><div>BALANCE TO CFM INDICATED</div></div> <div>8 x 8 CD1 (8") - 240f</div>	
SYMBOL	DESCRIPTION
CD1	CEILING DIFFUSER - 1 "TITUS" MODEL MCD, STEEL CONSTRUCTION, FRAME TYPE 6 FOR SURFACE MOUNTING, FURNISH WITH AG-95 OPPOSED BLADE DAMPER AND OFF-WHITE FINISH. SIZE AND BLOW PATTERN AS INDICATED ON DRAWINGS.
SR1	SUPPLY REGISTER - 1 "TITUS" MODEL S300FL, 3/4" BLADE SPACING, RADIUS TYPE, ALUMINUM CONSTRUCTION, DOUBLE DEFLECTION. PROVIDE COMPLETE WITH TIGHT SEAL GASKETING AND ASD-AIR SCOOP DAMPER/EXTRACTOR. SIZE AS INDICATED ON PLANS. FINISH PER ARCHITECTURAL REQUIREMENT.
R1	RETURN REGISTER - 1 "TITUS" MODEL 50F, 1/2-5/8"x1" EGG-CRATE GRID, ALUMINUM CONSTRUCTION, FRAME TYPE 6 FOR SURFACE MOUNTING, OPPOSED BLADE DAMPER, OFF-WHITE PAINT, SIZE AS INDICATED ON DRAWINGS.
R2	SIDEWALL RETURN "TITUS" MODEL 23RL, STEEL CONSTRUCTION, OPPOSED BLADE DAMPER, OFF-WHITE PAINT, SIZE AS INDICATED ON DRAWINGS.

COMPLIANCE NOTES	
MECHANICAL AND PLUMBING EQUIPMENT SHALL CONFORM TO THE FOLLOWING AS STATED IN THE ENERGY EFFICIENCY STANDARDS, 2016.	
1.	BE CERTIFIED BY THE MANUFACTURER AS COMPLYING WITH THE EFFICIENCY REQUIREMENTS AS PRESCRIBED IN SECTIONS:  110.1 APPLIANCES REGULATED BY THE APPLIANCE EFFICIENCY STANDARDS: 110.2 HVAC EQUIPMENT EFFICIENCY AND PACKAGED CONTROLS: 110.3 SERVICE WATER HEATING EFFICIENCY AND CONTROLS: 110.4 POOL AND SPA HEATING EFFICIENCY AND CONTROLS: 110.5 RESTRICTIONS ON PILOT LIGHTS:  2. BE SPECIFIED AND INSTALLED IN ACCORDANCE WITH SECTIONS.  120.1 REQUIREMENTS FOR VENTILATION: 120.2 REQUIRED CONTROLS FOR HVAC SYSTEMS: 102.2 (H) DEMAND SHED CONTROLS. 120.2 (I) ECONOMIZER FAULT DETECTION & DIAGNOSTIC.  120.3 REQUIREMENTS FOR PIPE INSULATION: 120.4 REQUIREMENTS FOR DUCT INSULATION: 120.5 REQUIREMENTS FOR MECHANICAL SYSTEMS 120.8 BUILDING COMMISSIONING 120.9 REQUIREMENTS FOR COMMERCIAL BOILERS

APPLICABLE CODES	
CODES:  ALL WORK SHALL BE PERFORMED IN ACCORDANCE WITH THE APPLICABLE REGULATIONS, INCLUDING BUT NOT LIMITED TO THE FOLLOWING:  A) STATE OF CALIFORNIA CODE OF REGULATIONS (CCR) TITLE 24, BUILDING STANDARDS: 2016 EDITION OF THE CALIFORNIA BUILDING CODE. 2016 EDITION OF THE CALIFORNIA ELECTRICAL CODE. 2016 EDITION OF THE CALIFORNIA MECHANICAL CODE. 2016 EDITION OF THE CALIFORNIA PLUMBING CODE. 2016 EDITION OF THE CALIFORNIA ENERGY CODE.  B) NATIONAL FIRE PROTECTION ASSOCIATION (NFPA) LIFE SAFETY CODE, CR.	

MECHANICAL ABBREVIATIONS			
AAV	AUTOMATIC AIR VENT	MBH	BTU PER HOUR (THOUSAND)
ABV	ABOVE	MC	MECHANICAL CONTRACTOR
ABC, OH	ABOVE CEILING, OVERHEAD	MIN	MINIMUM
AC	AIR CONDITIONING	MPS	MEDIUM PRESSURE STEAM
AD	ACCESS DOOR	(N) (E)	NEW, EXISTING
ADA	AMERICANS W/ DISABILITIES ACT	N.C.	NORMALLY CLOSED
AE	AIR EXTRACTOR	NEG	NEGATIVE
AFF	ABOVE FINISHED FLOOR	NIC	NOT IN CONTRACT
AL	ACOUSTICALLY LINED	N.O.	NORMALLY OPEN
AHU	AIR HANDLING UNIT	OBJD	OPPOSED BLADE DAMPER
APD	AIR PRESSURE DROP	OC	ON CENTER
BHP	BRAKE HORSEPOWER	OP	OPERATING
BOD	BOTTOM OF DUCT	PH	PHASE
BR	BRANCH	POC	POINT OF CONNECTION
BTU	BRITISH THERMAL UNIT	PSI	POUNDS PER SQUARE INCH
BTUH	BTU PER HOUR	PT	PRESSURE TREATED
CAV	CONSTANT AIR VOLUME	PTDF	PRESSURE TREATED DOUGLAS FIR
CD	CONDENSATE DRAIN	P&TRV	PRESSURE & TEMPERATURE RELIEF VALVE
CFM, f	CUBIC FEET OF AIR PER MINUTE	RPBP	REDUCED PRESSURE BACKFLOW PREVENTER
CFS	CUBIC FEET PER SECOND	(R) (D)	RISE, DROP
CL	CENTERLINE	RD, OFL	ROOF DRAIN, OVERFLOW
CO	CLEANOUT	REF	ROOF EXHAUST FAN
CONC.	CONCRETE	REQ'D	REQUIRED
CONN.	CONNECT	RL	REFRIGERANT LIQUID
CR	CONDENSATE RETURN (STEAM)	RPM	REVOLUTIONS PER MINUTE
CS	CURRENT SENSOR	RS	REFRIGERANT SUCTION
CU	CONDENSING UNIT	SAD	SEE ARCHITECTURAL DRAWINGS
CU FT	CUBIC FEET	SED	SEE ELECTRICAL DRAWINGS
CU IN	CUBIC INCHES	SM	SHEET METAL
CVB	CONSTANT VOLUME BOX	SMS	SHEET METAL SCREWS
CW	COLD WATER	SOV	SHUT OFF VALVE
DB	DRY BULB	SS	STAINLESS STEEL
DF	DOUGLAS FIR	SSD	SEE STRUCTURAL DRAWING
DIA, ø	DIAMETER	STL	STEEL
DSP	DUCT STATIC PRESSURE SENSOR	TA, FA	TO ABOVE, FROM ABOVE
EA, OA, RA, SA	EXHAUST, OUTSIDE, RETURN & SUPPLY AIR	TB, FB	TO BELOW, FROM BELOW
E.C.	ELECTRICAL CONTRACTOR	TBR	TO BE REMOVED
ESP	EXTERNAL STATIC PRESSURE	TCC	TEMPERATURE CONTROL CONTRACTOR
EWT	ENTERING WATER TEMPERATURE	THK	THICK
FA	FACE AREA (SQUARE FEET)	TR	TO REMAIN
FC	FLEXIBLE CONNECTION	TSP	TOTAL STATIC PRESSURE
FLA	FULL LOAD AMPS	TV	TURNING VANES
FPI	FINS PER INCH	TYP	TYPICAL
PFM	FEET PER MINUTE	UG, UF	UNDERGROUND, UNDER FLOOR
GALV.	GALVANIZED	UON	UNLESS OTHERWISE NOTED UP THROUGH ROOF
GA	GAUGE	UTR	UNIT VENTILATOR
GC	GENERAL CONTRACTOR	VAC	VOLTS ALTERNATING CURRENT
GSM	GALVANIZED SHEET METAL	VFD	VARIABLE FREQUENCY DRIVE
HP	HORSE POWER	VIF	VERIFY IN FIELD
HWS	HOT WATER SUPPLY	WB	WET BULB
HWR	HOT WATER RETURN	WG	WATER GAUGE
HZ	FREQUENCY (HERTZ)	WOG	WATER OIL GAS PRESSURE RATING
LBS	POUNDS	WP	WATER PRESSURE
LRA	LOCKED ROTOR AMPS	WPD	WATER PRESSURE DROP
LWT	LEAVING WATER TEMPERATURE	WT, AT	WATERTIGHT, AIRTIGHT
MAV	MANUAL AIR VENT		
MAX	MAXIMUM		

MECHANICAL GENERAL NOTES	
MEP COMPONENT ANCHORAGE NOTES:  ALL MECHANICAL, PLUMBING, AND ELECTRICAL COMPONENTS SHALL BE ANCHORED AND INSTALLED PER THE DETAILS ON THE DSA APPROVED CONSTRUCTION DOCUMENTS, WHERE NO DETAIL IS INDICATED, THE FOLLOWING COMPONENTS SHALL BE ANCHORED OR BRACED TO MEET THE FORCE AND DISPLACEMENT REQUIREMENTS PRESCRIBED IN THE 2016 CBC, SECTIONS 1616A.1.8 THROUGH 1616A.1.28 AND ASCE 7-10 CHAPTER 13, 26 AND 30.  1. ALL PERMANENT EQUIPMENT AND COMPONENTS. 2. TEMPORARY OR MOVABLE EQUIPMENT THAT IS PERMANENTLY ATTACHED (E.G. HARD WIRED) TO THE BUILDING UTILITY SERVICES SUCH AS ELECTRICITY, GAS, OR WATER. 3. MOVABLE EQUIPMENT WHICH IS STATIONED IN ONE PLACE FOR MORE THEN 8 HOURS AND HEAVIER THAN 400 POUNDS ARE REQUIRED TO BE ANCHORED WITH TEMPORARY ATTACHMENTS.  THE ATTACHMENT OF THE FOLLOWING MECHANICAL AND ELECTRICAL COMPONENTS SHALL BE POSITIVELY ATTACHED TO THE STRUCTURE, BUT NEED NOT BE DETAILED ON THE PLANS. THESE COMPONENTS SHALL HAVE FLEXIBLE CONNECTIONS PROVIDED BETWEEN THE COMPONENT AND ASSOCIATED DUCTWORK, PIPING, AND CONDUIT. A. COMPONENTS WEIGHING LESS THAN 400 POUNDS AND HAVE A CENTER OF MASS LOCATED 4 FEET OR LESS ABOVE THE ADJACENT FLOOR OR ROOF LEVEL THAT DIRECTLY SUPPORT THE COMPONENT. B. COMPONENTS WEIGHING LESS THAN 20 POUNDS, OR IN THE CASE OF DISTRIBUTED SYSTEMS, LESS THAN 5 POUNDS PER FOOT, WHICH ARE SUSPENDED FROM A ROOF OR FLOOR OR HUNG FROM A WALL.  FOR THOSE ELEMENTS THAT DO NOT REQUIRE DETAILS ON THE APPROVED DRAWINGS, THE INSTALLATION SHALL BE SUBJECT TO THE APPROVAL OF THE STRUCTURAL ENGINEER OF RECORD AND THE DSA DISTRICT STRUCTURAL ENGINEER. THE PROJECT INSPECTOR WILL VERIFY THAT ALL COMPONENTS AND EQUIPMENT HAVE BEEN ANCHORED IN ACCORDANCE WITH ABOVE REQUIREMENTS.  PIPING, DUCTWORK, AND ELECTRICAL DISTRIBUTION SYSTEM BRACING NOTE:  PIPING, DUCTWORK, AND ELECTRICAL DISTRIBUTION SYSTEMS SHALL BE BRACED TO COMPLY WITH THE FORCES AND DISPLACEMENTS PRESCRIBED IN ASCE 7-10 SECTION 13.3 AS DEFINED IN ASCE 7-10 SECTION 13.6.5.6, 13.6.7, 13.6.8, AND 2016 CBC, SECTIONS 1616A.1.24, 1616A.1.25, AND 1616A.1.26.  THE METHOD OF SHOWING BRACING AND ATTACHMENTS TO THE STRUCTURE FOR THE IDENTIFIED DISTRIBUTION SYSTEM ARE AS NOTED BELOW. WHEN BRACING AND ATTACHMENTS ARE BASED ON A PREAPPROVED INSTALLATION GUIDE (E.G., SMACNA OR OSHAPD OPM), COPIES OF THE BRACING SYSTEM INSTALLATION GUIDE OR MANUAL SHALL BE AVAILABLE ON THE JOBSITE PRIOR TO THE START OF AND DURING THE HANGING AND BRACING OF THE DISTRIBUTION SYSTEMS. THE STRUCTURAL ENGINEER OF RECORD SHALL VERIFY THE ADEQUACY OF THE STRUCTURE TO SUPPORT THE HANGER AND BRACE LOADS.  MECHANICAL PIPING (MP), MECHANICAL DUCTS (MD), PLUMBING PIPING (PP), ELECTRICAL DISTRIBUTION SYSTEMS (E):  MP□MD□PP□E□ -OPTION 1: DETAILED ON THE APPROVED DRAWING WITH PROJECT SPECIFIC NOTES AND DETAILS.  MP[X]MD[X]PP□E□ -OPTION 2: SHALL COMPLY WITH THE APPLICABLE OSHPD RE-APPROVAL (OPM#) "MASON" OPM-0043-13 OR "B-LINE" OPM-0052-13  MP□MD□PP□ -OPTION 3: SHALL COMPLY WITH THE SMACNA SEISMIC RESTRAINT MANUAL, OSHPD EDITION (2009), INCLUDING ANY ADDENDA. FASTENERS AND OTHERS ATTACHMENTS NOT SPECIFICALLY IDENTIFIED IN THE SMACNA SEISMIC RESTRAINT MANUAL, OSHPD EDITION, ARE DETAILED ON THE APPROVED DRAWINGS WITH PROJECT SPECIFIC NOTES AND DETAILS. THE DETAILS SHALL ACCOUNT FOR THE APPLICABLE SEISMIC HAZARD LEVEL AND CONNECTIONS LEVEL FOR THE PROJECT AND CONDITIONS.	

MECHANICAL LEGEND	
	UNIT TYPE UNIT NUMBER  DETAIL NUMBER SHEET NUMBER ON WHICH DETAIL IS FOUND  SECTION NUMBER SHEET ON WHICH SECTION IS FOUND  ACOUSTICALLY LINED DUCT - DIMENSIONS ARE OUTSIDE  BRANCH TAKE-OFF WITH SPLITTER DAMPER & W/ THROAT SIZE AS INDICATED. TRANSITION TO DUCT SIZES SHOWN.  DUCT RISE (DROP) IN DIRECTION OF AIR FLOW  DUCT - WIDTH x DEPTH  LATERAL WITH CONICAL TRANSITION TO DUCT SIZES INDICATED  CONICAL TEE FROM RECTANGULAR TO ROUND BRANCH  45° ENTRY TEE, RECTANGULAR BRANCH, RECTANGULAR MAIN  45° WYE, CONICAL MAIN AND BRANCH WITH 45° ELBOW, BRANCH 90° TO MAIN  TEE WITH ADJUSTABLE EXTRACTOR. RECTANGULAR MAIN, RECTANGULAR BRANCH  RADIUS ELL. SEE SPECS.  SQUARE ELL WITH TURNING VANES  TRANSITION ROUND TO RECTANGULAR  VERTICAL DUCT RISE OR DROP  DUCTS, PIPES, OR EQUIPMENT TO BE REMOVED  DUCT DROP OR RISE THRU ROOF OR FLOOR  RETURN, OUTSIDE, OR EXHAUST AIR DUCT  SUPPLY DUCT  ACCESS DOOR  AUTOMATIC CONTROL DAMPER  MANUAL AIR DAMPER  VOLUME DAMPER WITH REMOTE BALANCING DEVICE  FIRE DAMPER  FIRE SMOKE DAMPER  SMOKE DETECTOR  DUCT STATIC PRESSURE SENSOR  THERMOSTAT  CHILLED WATER SUPPLY  CHILLED WATER RETURN  CONDENSER SUPPLY  CONDENSER RETURN  HOT WATER SUPPLY  HOT WATER RETURN  REFRIGERANT LIQUID  REFRIGERANT SUCTION  BALANCING VALVE  BALL VALVE  BUTTERFLY VALVE  CHECK VALVE  FLEXIBLE CONNECTION  FLOW SENSOR  GATE VALVE  PETE'S PLUG  SHUT OFF COCK  PRESSURE GAUGE  PRESSURE REDUCING VALVE  REDUCER  PRESSURE & TEMPERATURE RELIEF VALVE  SHUT OFF VALVE  SIGHT GLASS  STRAINER  STRAINER & DRAIN VALVE WITH HOSE FITTING  SOLENOID VALVE  THERMOMETER  TWO WAY CONTROL VALVE  THREE WAY CONTROL VALVE  UNION

MECHANICAL DEMOLITION NOTES	
DEMOLITION NOTE:  CONTRACTOR SHALL REMOVE AND RETURN TO THE OWNER ALL THE EXISTING ALERTON CONTROLLER(S) ON THE EXISTING EQUIPMENT (UNIT VENTILATOR, AHU, BOILER & CHILLER) THAT ARE NOTED TO BE REMOVED ON THE PROJECT.	



Revisions				
No.	Revisions	By	Date	Appr.

1	Addendum #2		5/22/18	
---	-------------	--	---------	--

#### DSA Submittal

ISSUE DATE: 4/17/2018 BY: AA

#### DSA APPROVAL

IDENTIFICATION STAMP DIVISION OF STATE ARCHITECT	
APPL 02-116505	
AC	FILE NO.
DATE	67439-353

TURLEY & ASSOCIATES MECHANICAL ENGINEERING GROUP, INC.	
2431 Capital Avenue Sacramento, CA 95811	(916) 525-1065 Fax: (916) 525-1075 Email: office@turleyandco.com
Project Engineer: JT	Job Number: 17312
Project Manager: NS	City Date: May 22, 2018 - 2:05pm
Project Engineer: JT	City Date: May 22, 2018 - 2:05pm

This document is the property of the Owner and is not to be used without his written permission.  
Architect/Engineer Of Record:



**HY HIBSER YAMAUCHI Architects, Inc.**  
4602 2nd Street, Suite 3  
Davis, CA 95618  
530.758.1270 tel | 530.758.4789 fax

HY Architects Project number: 5077

Facility  
HIRAM JOHNSON HIGH SCHOOL  
6879 14th Ave, Sacramento, CA 95820

Project  
HVAC UPGRADE

Sheet Title  
MECHANICAL LEGENDS,  
SCHEDULES AND NOTES

Client Project Number:		Client Proj. #	
Scale:	As indicated	Sheet	
Drawn By:	NS	M0.01	
Checked By:	JT		
Issue Date:	4/17/18		
Revit Version: 2017		Sheet	1 of 200

1/23/2018 9:58:27 AM C:\REVIT\5077\_Hiram Johnson HVAC\_Central\_17\_aaltonz.rvt Z:\a\Files\2017\17300 - 17348\17312 - Sac City USD Hiram Johnson Core Academic HVAC Upgrades\M0.02\_17312.dwg M0.02\_5/22/2018 3:37:50 PM NSHah



IF THIS SHEET IS NOT 30"x42", IT IS  
A REDUCED PRINT SCALE ACCORDINGLY



Revisions				
No.	Revisions	By	Date	Appr.
1	Addendum #2		5/22/18	














## OUTSIDE AIR BALANCE TABLE BLDG C

ROOM NAME	EQUIP ID	MIN. T-24 OSA CFM	ACTUAL OSA CFM
ATTENDANCE C-18		102	105
OFFICES		137	140
CLASSROOM C-3		306	310
CLASSROOM C-4		307	310
CLASSROOM C-5		307	310
CLASSROOM C-6		307	310
CLASSROOM C-7		306	310
CLASSROOM C-8		300	300
CLASSROOM C-9		300	300
CLASSROOM C-10		300	300
CLASSROOM C-12		300	300
CLASSROOM C-13		300	300
CLASSROOM C-14		296	300

## OUTSIDE AIR BALANCE TABLE BLDG D

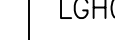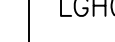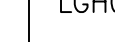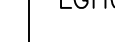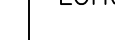ROOM NAME	EQUIP ID	MIN. T-24 OSA CFM	ACTUAL OSA CFM
CLASSROOM D-1		306	310
		306	310
CLASSROOM D-2		302	305
CLASSROOM D-3		302	305
CLASSROOM D-4		301	305
CLASSROOM D-5		302	305
CLASSROOM D-6		206	210
		272	275
CLASSROOM D-7		206	210
		272	275
CLASSROOM D-8		176	180
		233	235
CLASSROOM D-9		203	205
		203	205
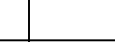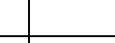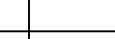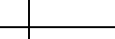
## PACKAGED ROOF TOP AC UNIT SCHEDULE BLDG "C"

SYMBOL	MANUFACTURER	MODEL	NOMINAL TONS	COOLING CAPACITY							FAN				HEATING CAPACITY			ELECTRICAL										OPERATING WEIGHT LBS.	REMARKS
				TOTAL MBH	SENSIBLE MBH	EDB °F	EWB °F	AMB °F	EER	SEER	CFM	ESP IN WC	BHP	HP	MBH INPUT	MBH OUTPUT	AFUE	"AC" UNIT ELECTRICAL					EXTERNAL POWER EXHAUST						
																		VOLTS	PHASE	HZ	MCA	MOCP	FLA	VOLTS	PHASE	FLA	HP		
	LENNOX	LGH048S4T	4	47.2	36.8	80	67	105	12.5	15.0	1600	0.5"	0.75	0.75	70	57	81	480	3	60	12	15	9.1	460	3	1.1	1/2	1370	1,2,3,4,5,6 & 7
	LENNOX	LGH048S4T	4	47.2	36.8	80	67	105	12.5	15.0	1500	0.5"	0.75	0.75	70	57	81	480	3	60	12	15	9.1	460	3	1.1	1/2	1370	1,2,3,4,5,6 & 7
	LENNOX	LGH060S4T	5	60	46.2	80	67	105	12.3	15.5	1900	0.75"	0.86	1	70	57	81	480	3	60	14	20	12.4	460	3	1.1	1/2	1370	1,2,3,4,5 & 7
	LENNOX	LGH060S4T	5	60	46.2	80	67	105	12.3	15.5	1900	0.75"	0.86	1	70	57	81	480	3	60	14	20	12.4	460	3	1.1	1/2	1370	1,2,3,4,5 & 7









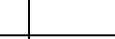
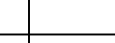



## OUTSIDE AIR BALANCE TABLE BLDG E

ROOM NAME	EQUIP ID	MIN. T-24 OSA CFM	ACTUAL OSA CFM
CLASSROOM E-1		306	310
		306	310
CLASSROOM E-2		263	265
		348	350
CLASSROOM E-3		261	265
		346	350
CLASSROOM E-4		241	245
		319	320
CLASSROOM E-5		241	245
		319	320
CLASSROOM E-6		241	245
		320	320

## OUTSIDE AIR BALANCE TABLE BLDG F

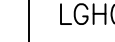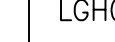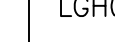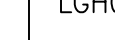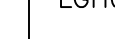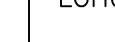ROOM NAME	EQUIP ID	MIN. T-24 OSA CFM	ACTUAL OSA CFM
OFFICES		146	150
OFFICES		184	185
CLASSROOM F-3		224	225
		297	300
CLASSROOM F-4		261	265
		346	350
CLASSROOM F-5		224	225
		297	300
CLASSROOM F-6		224	225
		297	300
CLASSROOM F-7		240	240
		319	320

## PACKAGED ROOF TOP AC UNIT SCHEDULE BLDG "D"

SYMBOL	MANUFACTURER	MODEL	NOMINAL TONS	COOLING CAPACITY								FAN				HEATING CAPACITY			ELECTRICAL										OPERATING WEIGHT LBS.	REMARKS
				TOTAL MBH	SENSIBLE MBH	EDB °F	EWB °F	AMB °F	EER	SEER	CFM	ESP IN WC	BHP	HP	MBH INPUT	MBH OUTPUT	AFUE	"AC" UNIT ELECTRICAL					EXTERNAL POWER EXHAUST							
																		VOLTS	PHASE	HZ	MCA	MOCP	FLA	VOLTS	PHASE	FLA	HP			
	LENNOX	LGH060S4T	5	60	46.2	80	67	105	12.3	15.5	1900	0.75"	0.86	1	70	57	81	480	3	60	14	20	12.4	460	3	1.1	1/2	1370	1,2,3,4,5 & 6	
	LENNOX	LGH060S4T	5	60	46.2	80	67	105	12.3	15.5	1900	0.75"	0.86	1	70	57	81	480	3	60	14	20	12.4	460	3	1.1	1/2	1370	1,2,3,4,5 & 6	
	LENNOX	LGH060S4T	5	60	46.2	80	67	105	12.3	15.5	1900	0.75"	0.86	1	70	57	81	480	3	60	14	20	12.4	460	3	1.1	1/2	1370	1,2,3,4,5 & 7	
	LENNOX	LGH060S4T	5	60	46.2	80	67	105	12.3	15.5	1900	0.75"	0.86	1	70	57	81	480	3	60	14	20	12.4	460	3	1.1	1/2	1370	1,2,3,4,5 & 7	
	LENNOX	LGH060S4T	5	60	46.2	80	67	105	12.3	15.5	1900	0.75"	0.86	1	70	57	81	480	3	60	14	20	12.4	460	3	1.1	1/2	1370	1,2,3,4,5 & 7	
	LENNOX	LGH060S4T	5	60	46.2	80	67	105	12.3	15.5	1900	0.75"	0.86	1	70	57	81	480	3	60	14	20	12.4	460	3	1.1	1/2	1370	1,2,3,4,5 & 7	
	LENNOX	LGH036S4T	3	33.9	27.1	80	67	105	11.6	15.0	1200	0.5"	0.75	0.75	70	57	81	480	3	60	11	15	7.0	460	3	1.1	1/2	1320	1,2,3,4,5,6 & 7	
	LENNOX	LGH048S4T	4	47.2	36.8	80	67	105	12.5	15.0	1600	0.5"	0.75	0.75	70	57	81	480	3	60	12	15	9.1	460	3	1.1	1/2	1370	1,2,3,4,5,6 & 7	
 	LENNOX	LGH048S4T	4	47.2	36.8	80	67	105	12.5	15.0	1600	0.5"	0.75	0.75	70	57	81	480	3	60	12	15	9.1	460	3	1.1	1/2	1370	1,2,3,4,5,6 & 7	

## PACKAGED ROOF TOP AC UNIT SCHEDULE BLDG "E"

SYMBOL	MANUFACTURER	MODEL	NOMINAL TONS	COOLING CAPACITY							FAN	
--------	--------------	-------	-----------------	------------------	--	--	--	--	--	--	-----	--

C:\REVIT\17300 - 17348\17312 - Sac City USD Hiram Johnson Core Academic HVAC Upgrades\M002\_17312.dwg, M0.03, 5/22/2018 3:37:51 PM, NShah

C:\REVIT\17300 - 17348\17312 - Sac City USD Hiram Johnson Core Academic HVAC Upgrades\M002\_17312.dwg, M0.03, 5/22/2018 3:37:51 PM, NShah

1/23/2018 9:58:27 AM



IF THIS SHEET IS NOT 30"x42", IT IS  
A REDUCED PRINT SCALE ACCORDINGLY



Revisions				
No.	Revisions	By	Date	Appr.
1	Addendum #2		5/22/18	

#### DSA Submittal


ISSUE DATE: 4/17/2018 BY: AA

#### DSA APPROVAL

IDENTIFICATION STAMP  
DIVISION OF STATE ARCHITECT  
APPL **02-116505**

AC        FLS        SS         
DATE       

FILE NO. 67439-353

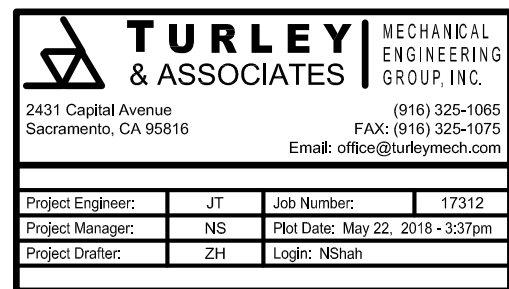

This document is the property of the Owner and is not to be used without his written permission.

Architect/Engineer Of Record: \_\_\_\_\_



**HY HIBSER YAMAUCHI**  
Architects, Inc.  
4602 2nd Street, Suite 3  
Davis, CA 95618  
530.758.1270 tel | 530.758.4789 fax

HY Architects Project number: 5077

Facility  
HIRAM JOHNSON HIGH SCHOOL  
6879 14th Ave, Sacramento, CA 95820

Project  
HVAC UPGRADE

Sheet Title  
MECHANICAL LEGENDS,  
SCHEDULES AND NOTES

Client Project Number: Client Proj. #

Scale: As indicated

Drawn By: NS










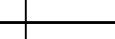

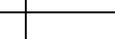
Checked By: JT

Issue Date: 4/17/18

Revit Version: 2017

Sheet  
1 of 200  
**M0.03**
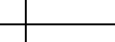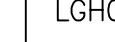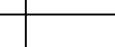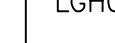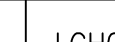
### PACKAGED ROOF TOP AC UNIT SCHEDULE BLDG "F"

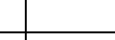SYMBOL	MANUFACTURER	MODEL	NOMINAL TONS	COOLING CAPACITY							FAN				HEATING CAPACITY			ELECTRICAL										OPERATING WEIGHT LBS.	REMARKS
				TOTAL MBH	SENSIBLE MBH	EDB °F	EWB °F	AMB °F	EER	SEER	CFM	ESP IN WC	BHP	HP	MBH INPUT	MBH OUTPUT	AFUE	"AC" UNIT ELECTRICAL					EXTERNAL POWER EXHAUST						
																		VOLTS	PHASE	HZ	MCA	MOCP	FLA	VOLTS	PHASE	FLA	HP		
	LENNOX	LGH060S4T	5	60	46.2	80	67	105	12.3	15.5	1900	0.75"	0.86	1	70	57	81	480	3	60	14	20	12.4	460	3	1.1	1/2	1370	1,2,3,4,5 & 7
	LENNOX	LGH060S4T	5	60	46.2	80	67	105	12.3	15.5	1900	0.75"	0.86	1	70	57	81	480	3	60	14	20	12.4	460	3	1.1	1/2	1370	1,2,3,4,5 & 7
	LENNOX	LGH036S4T	3	33.9	27.1	80	67	105	11.6	15.0	1200	0.5"	0.75	0.75	70	57	81	480	3	60	11	15	7.0	460	3	1.1	1/2	1320	1,2,3,4,5,6 & 7
	LENNOX	LGH048S4T	4	47.2	36.8	80	67	105	12.5	15.0	1600	0.5"	0.75	0.75	70	57	81	480	3	60	12	15	9.1	460	3	1.1	1/2	1370	1,2,3,4,5,6 & 7
	LENNOX	LGH036S4T	3	33.9	27.1	80	67	105	11.6	15.0	1200	0.5"	0.75	0.75	70	57	81	480	3	60	11	15	7.0	460	3	1.1	1/2	1320	1,2,3,4,5,6 & 7
	LENNOX	LGH048S4T	4	47.2	36.8	80	67	105	12.5	15.0	1600	0.5"	0.75	0.75	70	57	81	480	3	60	12	15	9.1	460	3	1.1	1/2	1370	1,2,3,4,5,6 & 7
#### NOTES:

- 1) PROVIDE ROOF CURB W/ SPRING ISOLATOR & SEISMIC CLIPS FOR UNIT ATTACHMENT (SEE A/M5.02 FOR CURB & CLIP QUANTITY)
  - 2) PROVIDE COMPLETE ECONOMIZER WITH MICROMETL PCD-FLHA-4V MODULATING POWER EXHAUST (W/VFD). POWER EXHAUST SHALL BE POWERED SEPARATELY FROM UNIT.  
MFR OF UNIT WILL PROVIDE THE PRESSURE TRANSDUCER FOR CONTROLLING POWER EXHAUST VFD. WHERE TWO UNIT SERVES ONE CLASSROOM (I.E. UNIT WITH A & B DESIGNATION) ONLY PROVIDE ONE PRESSURE TRANSDUCER FOR CONTROLLING BOTH UNITS POWER EXHAUST VFD IS REQUIRED
  - 3) MCA AND MOCP OF UNIT SHOWN ABOVE DOES NOT INCLUDE POWER EXHAUST MCA AND MOCP.
  - 4) T-24 COMPLIANT FDD
  - 5) BACNET COMPLIANT COMMUNICATION CARD
  - 6) SMOKE DETECTOR FOR AUTOMATIC SHUT DOWN UPON DETECTION OF COMBUSTION PRODUCT. INTERLOCK WITH FIRE ALARM SYSTEM
  - 7) PROVIDE MINIMUM OF 4" THICK MERV-8 DISPOSABLE FILTERS WITH FILTER KIT APPROVED BY UNIT MANUFACTURER (AFTER MARKET FILTER KIT ACCEPTABLE IF WARRANTY IS NOT VOID)
- GENERAL NOTES:  
YORK UNIT ACCEPTABLE EQUAL


### PACKAGED ROOF TOP AC UNIT SCHEDULE LITTLE THEATER

SYMBOL	MANUFACTURER	MODEL	NOMINAL TONS	COOLING CAPACITY							FAN				HEATING CAPACITY			ELECTRICAL						OPERATING WEIGHT LBS.	EXISTING UNIT OPERATING WEIGHT LBS.	REMARKS
				TOTAL MBH	SENSIBLE MBH	EDB °F	EWB °F	AMB °F	EER	IEER	CFM	ESP IN WC	BHP	HP	MBH INPUT	MBH OUTPUT	AFUE	"AC" UNIT ELECTRICAL								
																		VOLTS	PHASE	HZ	MCA	MOCP	FLA			
<div>AC 1</div>	AAON	RNA-016-C	16	172.06	153.28	90	67	105	12.3	14.2	4000	2.2"	3.04	7.5	270.0	218.7	0.81	460	3	60	47	50	44	3800	3800	1,2,3,4,5,6,7

#### NOTES:

- 1) PROVIDE ROOF CURB W/ CLIPS FOR UNIT ATTACHMENT
- 2) PROVIDE COMPLETE ECONOMIZER WITH POWER EXHAUST.
- 3) MCA AND MOCP OF UNIT SHOWN ABOVE DOES NOT INCLUDE POWER EXHAUST MCA AND MOCP.
- 4) T-24 COMPLIANT FDD
- 5) BACNET COMPLIANT COMMUNICATION CARD
- 6) SMOKE DETECTOR FOR AUTOMATIC SHUT DOWN UPON DETECTION OF COMBUSTION PRODUCT. INTERLOCK WITH FIRE ALARM SYSTEM
- 7) PROVIDE MINIMUM OF 4" THICK MERV-8 DISPOSABLE FILTERS

1/23/2018 9:58:27 AM C:\REVIT\15077\_Hiram Johnson HVAC\_Central\_17\_aaltonz.rvt

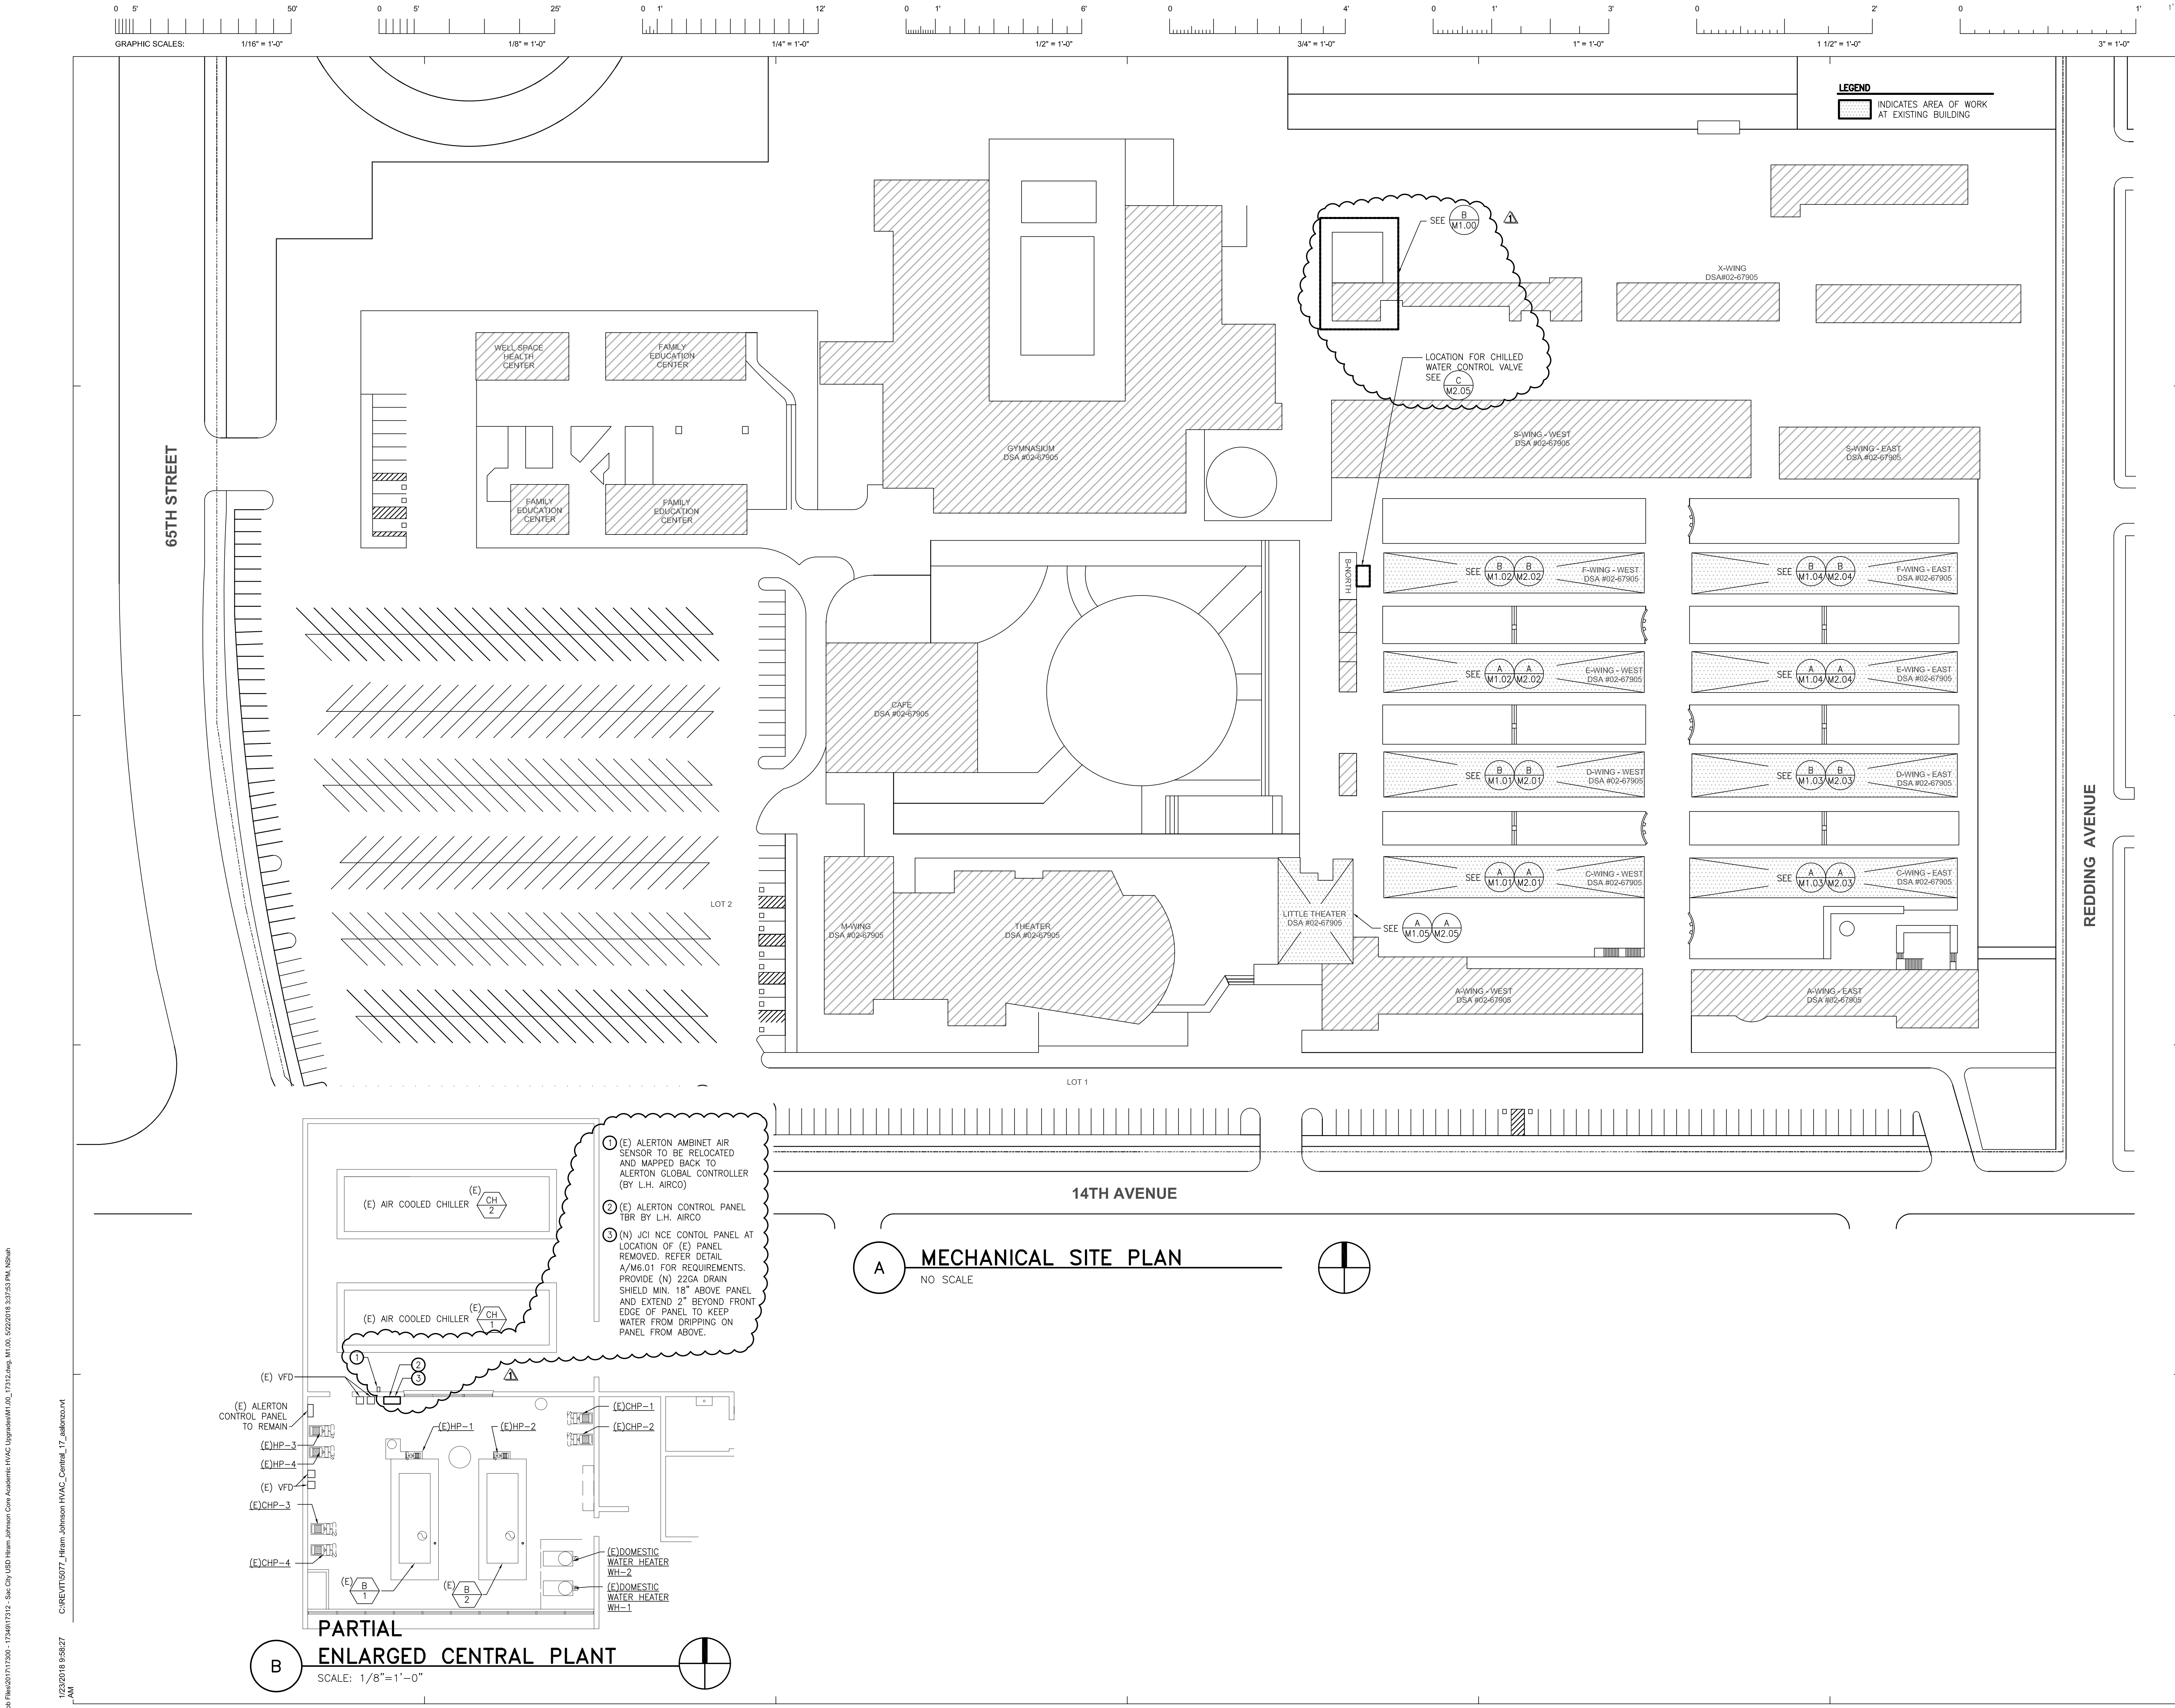

IF THIS SHEET IS NOT 30"x42", IT IS A REDUCED PRINT SCALE ACCORDINGLY



Revisions				
No.	Revisions	By	Date	Appr.
1	Addendum #2		5/22/18	

**DSA Submittal**

ISSUE DATE: 4/17/2018 BY: AA

**DSA APPROVAL**

IDENTIFICATION STAMP  
DIVISION OF STATE ARCHITECT  
APPL. 02-116505  
AC FLS SS  
DATE  
FILE NO. 67439-353

TURLEY & ASSOCIATES MECHANICAL ENGINEERING GROUP INC.			
2431 Capital Avenue Sacramento, CA 95818	(916) 325-1065 Fax: (916) 325-1075 Email: office@turleyandassociates.com		
Project Engineer: JT	Job Number: 17312		
Product Manager: NS	File Date: May 22, 2018 - 3:59pm		
Project Designer: ZH	Scale: Metric		

This document is the property of the Owner and is not to be used without his written permission.  
Architect/Engineer Of Record:



**HIBSER YAMAUCHI Architects, Inc.**  
4602 2nd Street, Suite 3  
Davis, CA 95618  
530.758.1270 tel | 530.758.4789 fax


HY Architects Project number: 5077

Facility  
**HIRAM JOHNSON HIGH SCHOOL**  
6879 14th Ave, Sacramento, CA 95820

Project  
**HVAC UPGRADE**

Sheet Title  
**MECHANICAL SITE**


Client Project Number:		Client Proj. #
Scale:	As indicated	Sheet
Drawn By:	NS	<b>M1.00</b>
Checked By:	JT	
Issue Date:	4/17/18	
Revit Version:	2017	Sheet 1 of 200

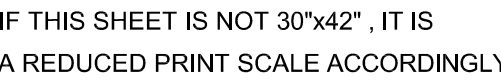

DSA Submittal	
ISSUE DATE: <u>4/17/2018</u>	BY: <u>AA</u>


**DSA APPROVAL**

IDENTIFICATION STAMP  
DIVISION OF STATE ARCHITECT  
APPL. **02-116505**  
AC \_\_\_\_\_ FLS \_\_\_\_\_ SS \_\_\_\_\_  
DATE \_\_\_\_\_  
FILE NO. **67439-353**

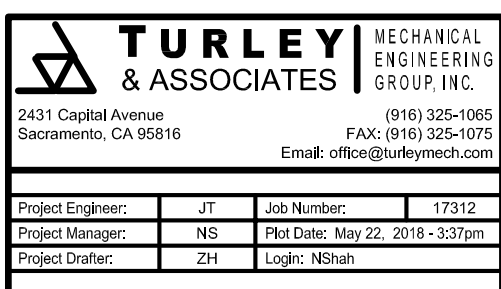

This document is the property of the Owner and is not to be used without his written permission.

Architect/Engineer Of Record: \_\_\_\_\_

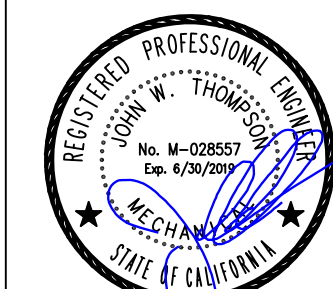

**HY** HIBSER YAMAUCHI  
Architects, Inc.  
4602 2nd Street, Suite 3  
Davis, CA 95618  
530.758.1270 tel / 530.758.4789 fax

HY Architects Project number: 5077

Facility	HIRAM JOHNSON HIGH SCHOOL 6879 14th Ave, Sacramento, CA 95820
----------	--

# Project


## HVAC UPGRADE

Sheet Title

MECHANICALNEW PLANS -  
LITTLE THEATER


Client Project Number:	Client Proj. #
------------------------	----------------

Scale: As indicated	Sheet
Drawn By: NS	<b>M2.05</b>
Checked By: JT	
Issue Date: 4/17/18	
Revit Version: 2017	
	Sheet 1 of 200

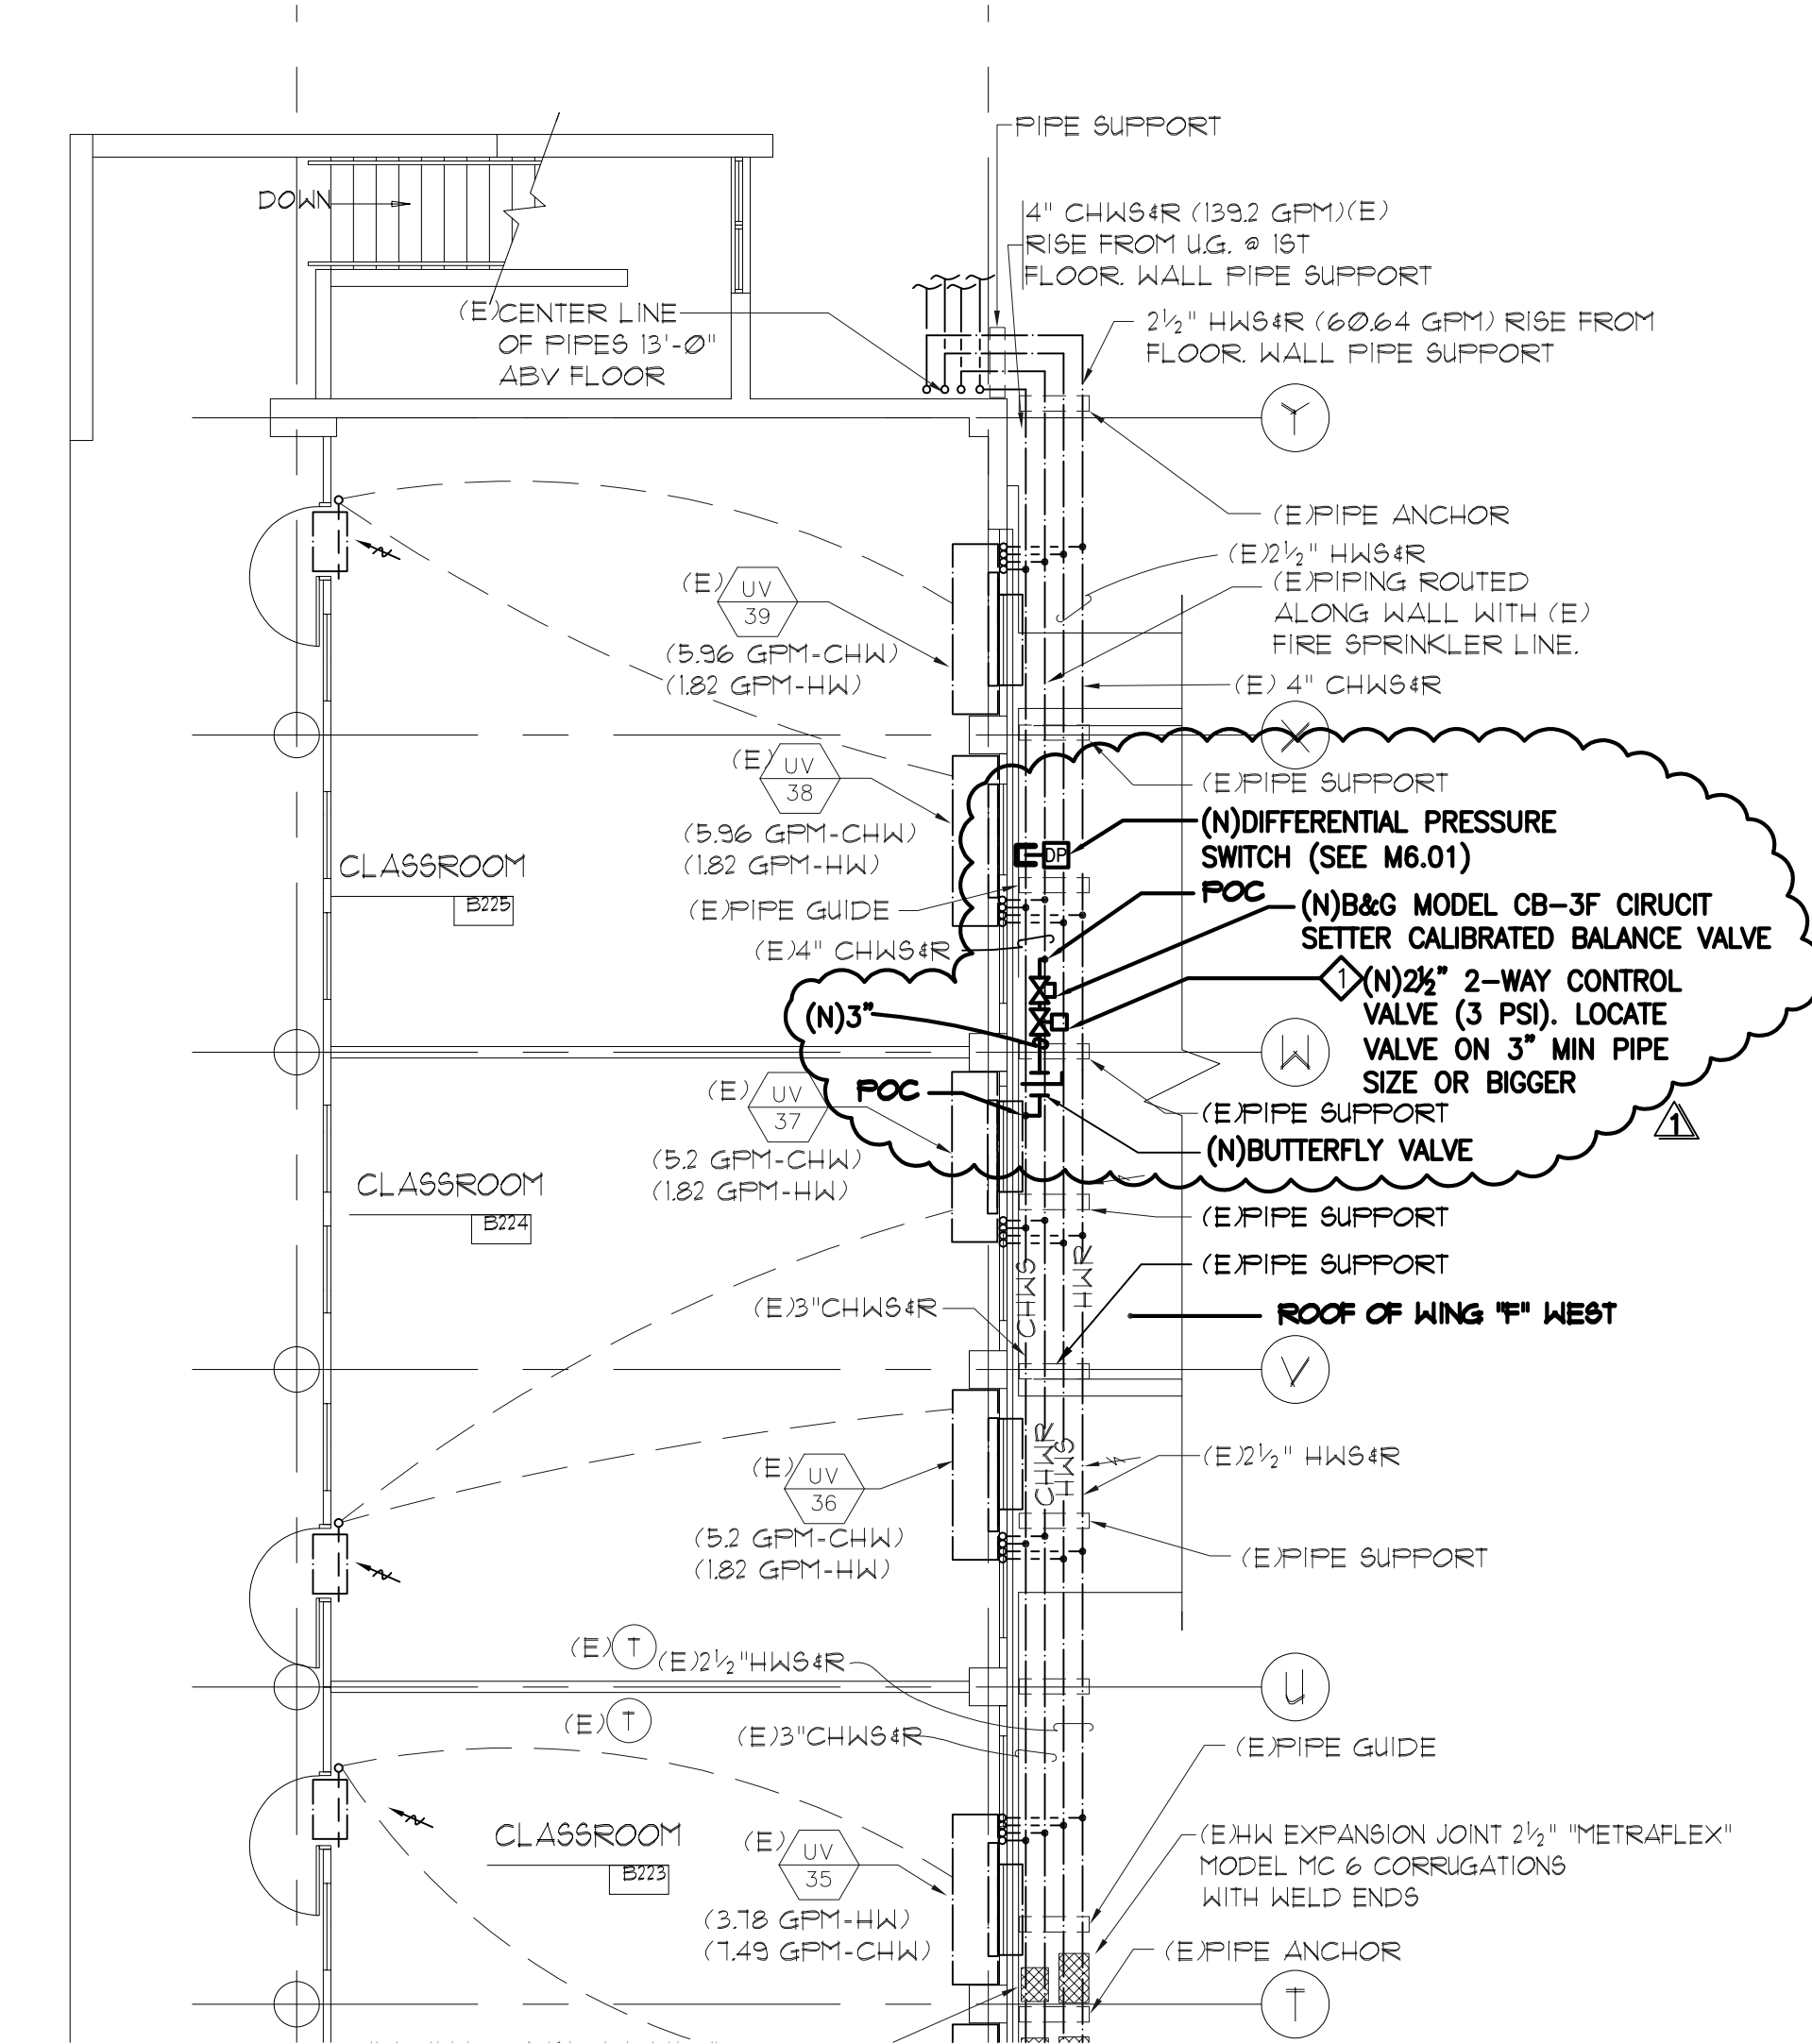


BUILDING B NORTH  
PARTIAL MECHANICAL PLAN

SCALE: 1/8"=1'-0"

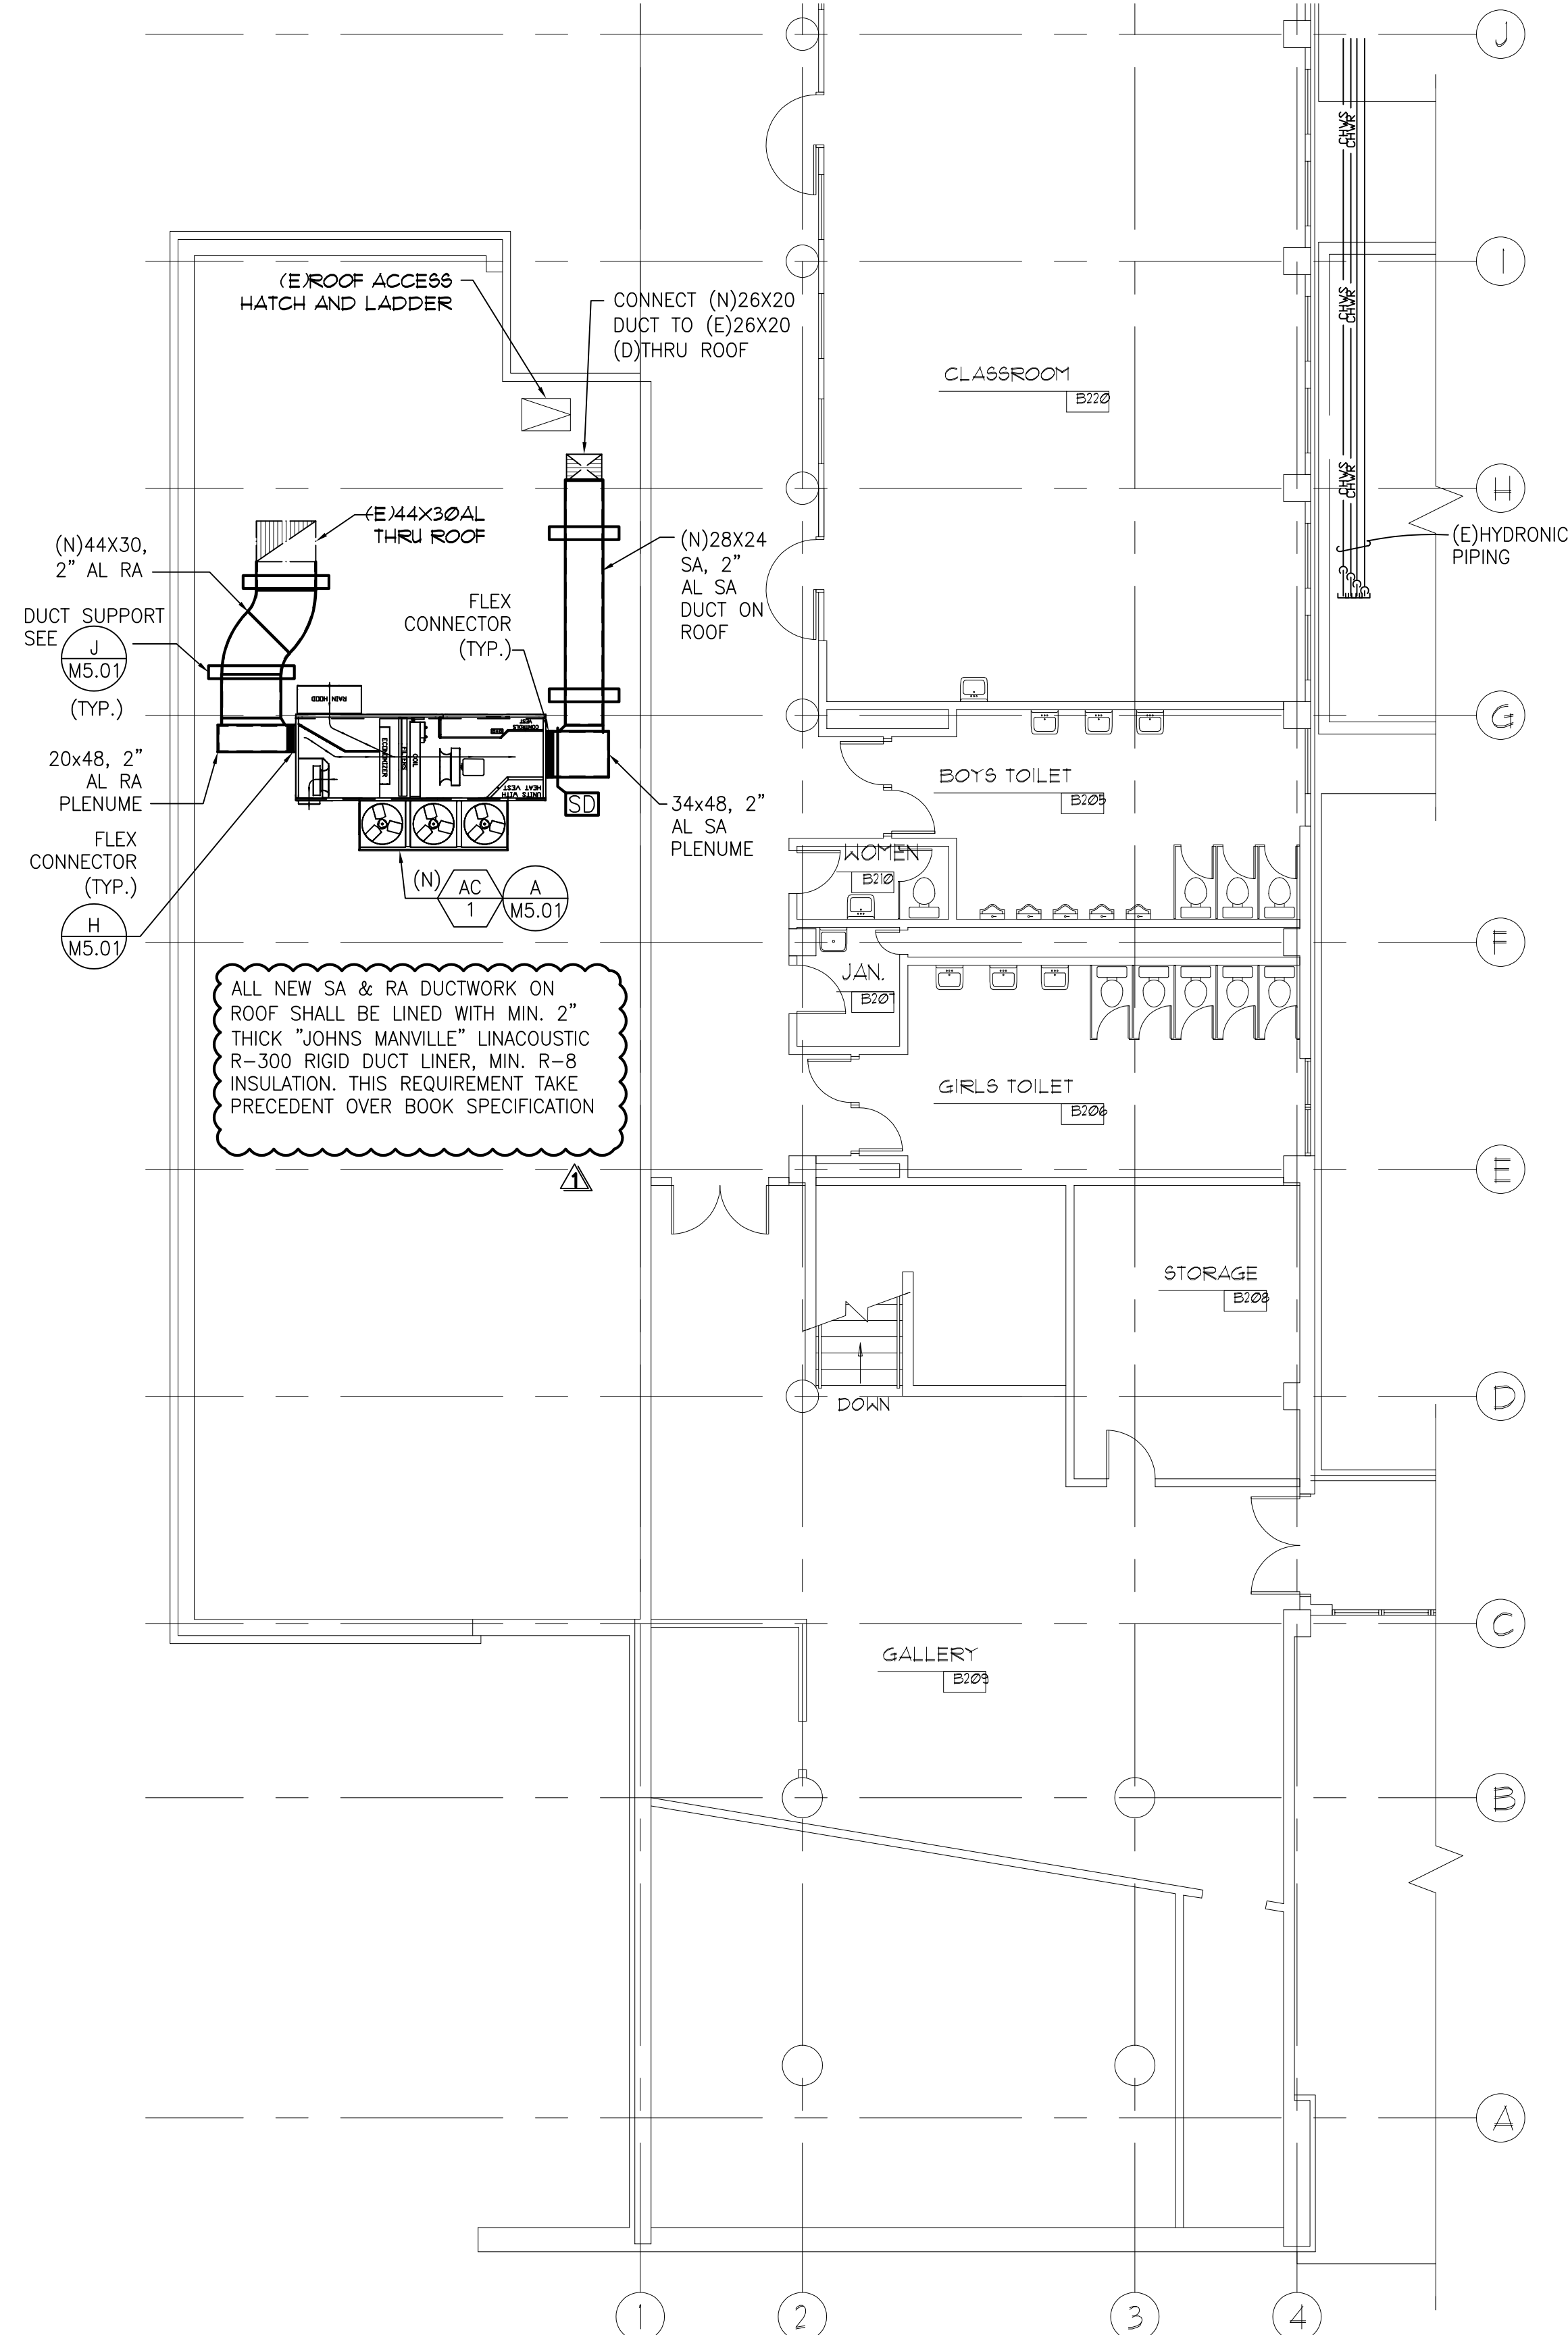


## LITTLE THEATER BUILDING MECHANICAL ROOF PLAN

SCALE: 1/8"=1'-0'

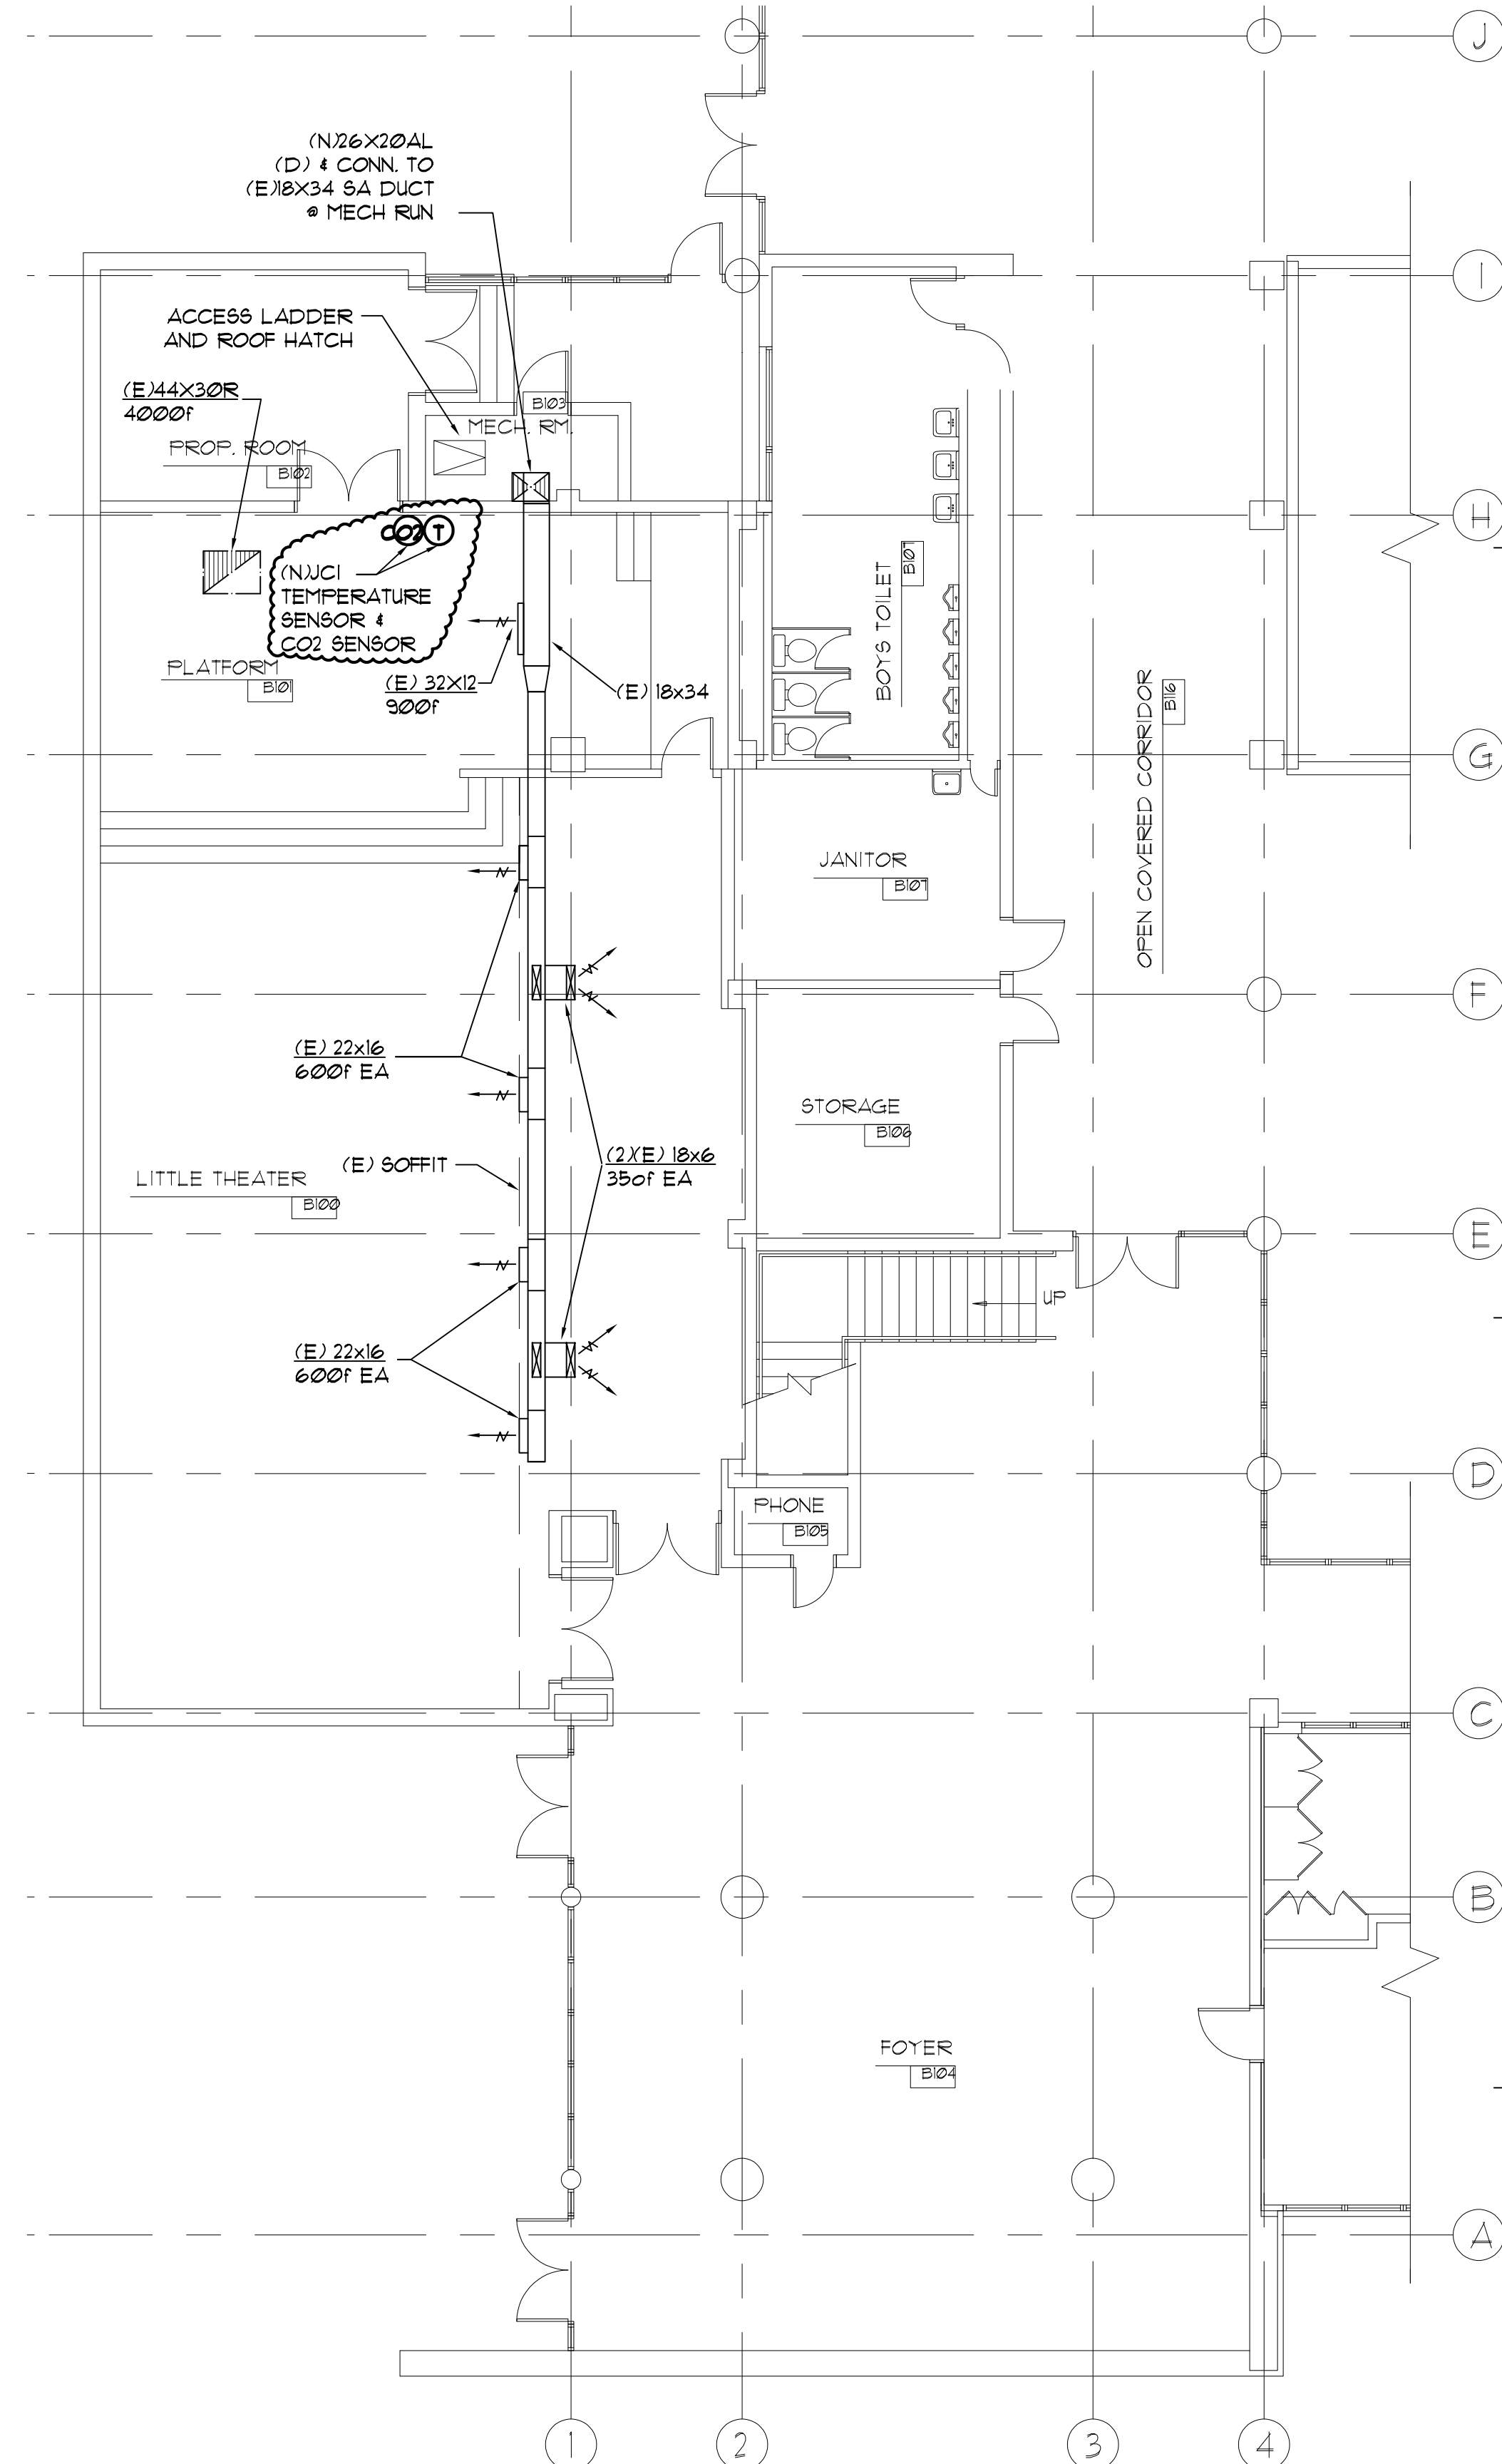

## LITTLE THEATER BUILDING MECHANICAL FLOOR PLAN


SCALE: 1/8"=1'-0"

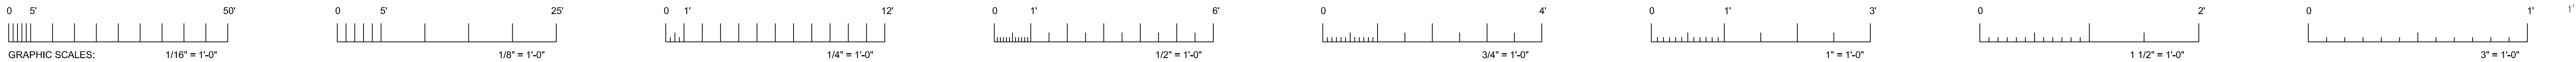

IF THIS SHEET IS NOT 30"x42", IT IS  
A REDUCED PRINT SCALE ACCORDINGLY



Revisions				
No.	Revisions	By	Date	Appr.
1	Addendum #2		5/22/18	

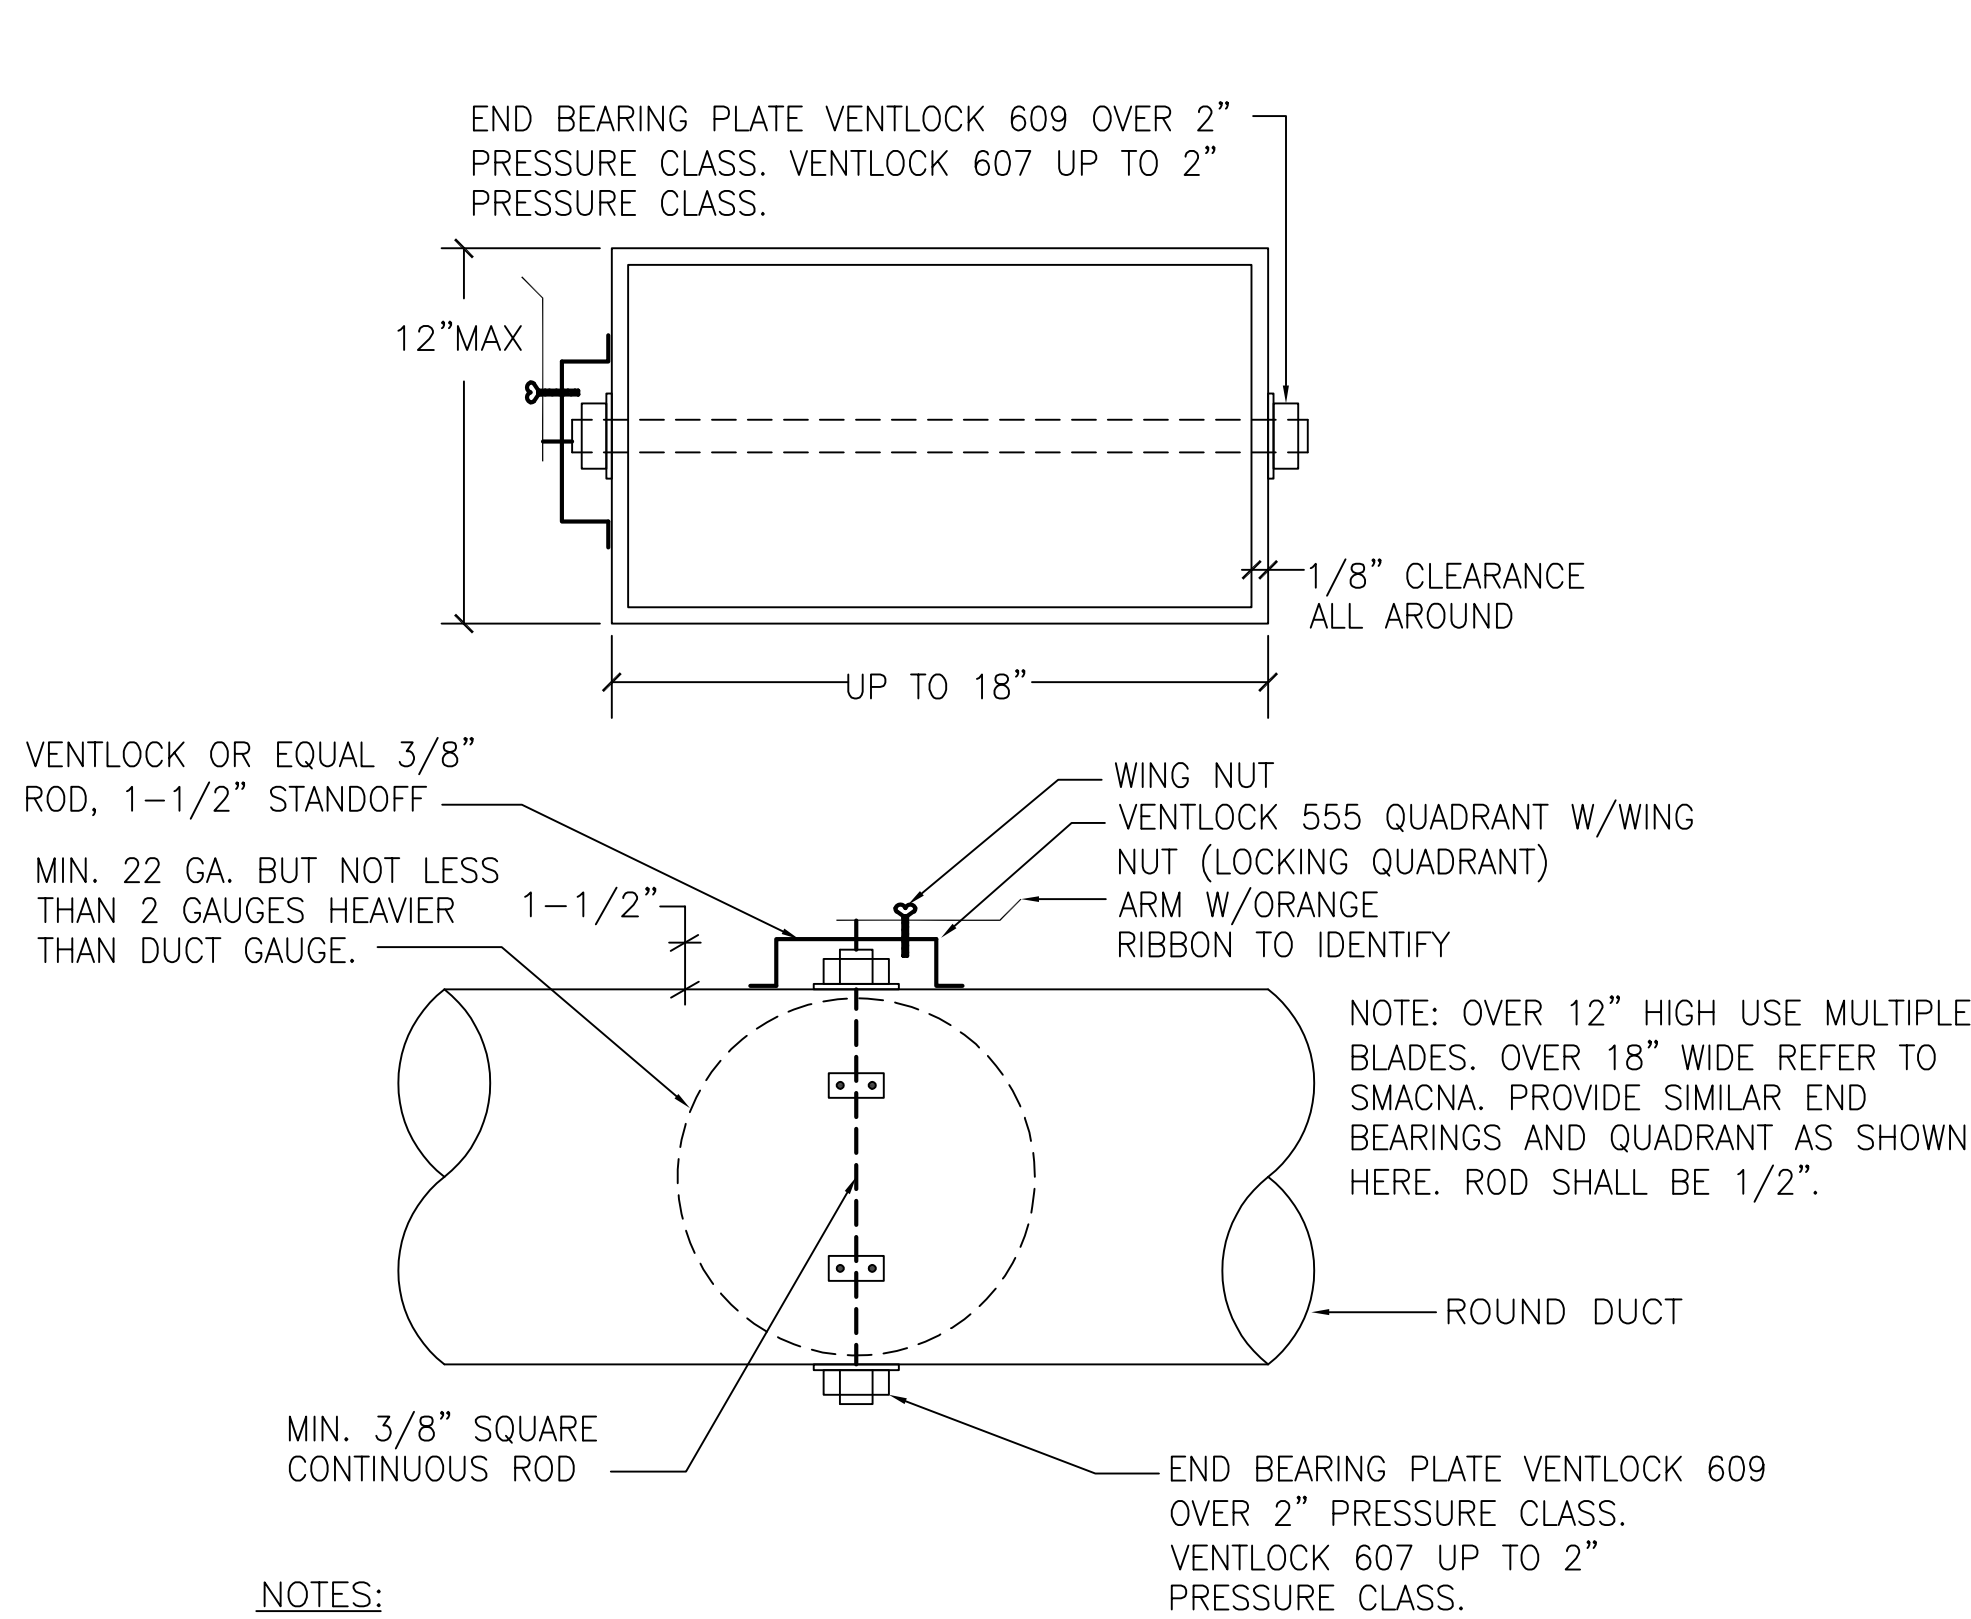


NOTES:

1. SEAL ALL JOINTS W/ A PERMANENT FLEXIBLE, HIGH PRESSURE DUCT SEALANT (UL 181 LISTED).
2. SYSTEM BUILT TO COMPLY W/ SMACNA LATEST REVISION. ITEMS LISTED ABOVE ARE MINIMUM REQUIREMENTS. PROVIDE ALL MATERIAL AND LABOR NECESSARY FOR COMPLETE WORKABLE SYSTEM.
3. SQUARE DAMPERS ARE ALSO REQUIRED AND SHALL MEET LATEST SMACNA STANDARDS. QUADRANTS SHALL HAVE STANDOFFS SIMILAR TO ONES SHOWN FOR ROUND DUCT.
4. ALL BALANCING DAMPER COMPONENTS SHALL BE GALVANIZED CONSTRUCTION


**G** TYPICAL BALANCE DAMPER DETAIL

SCALE: NO SCALE

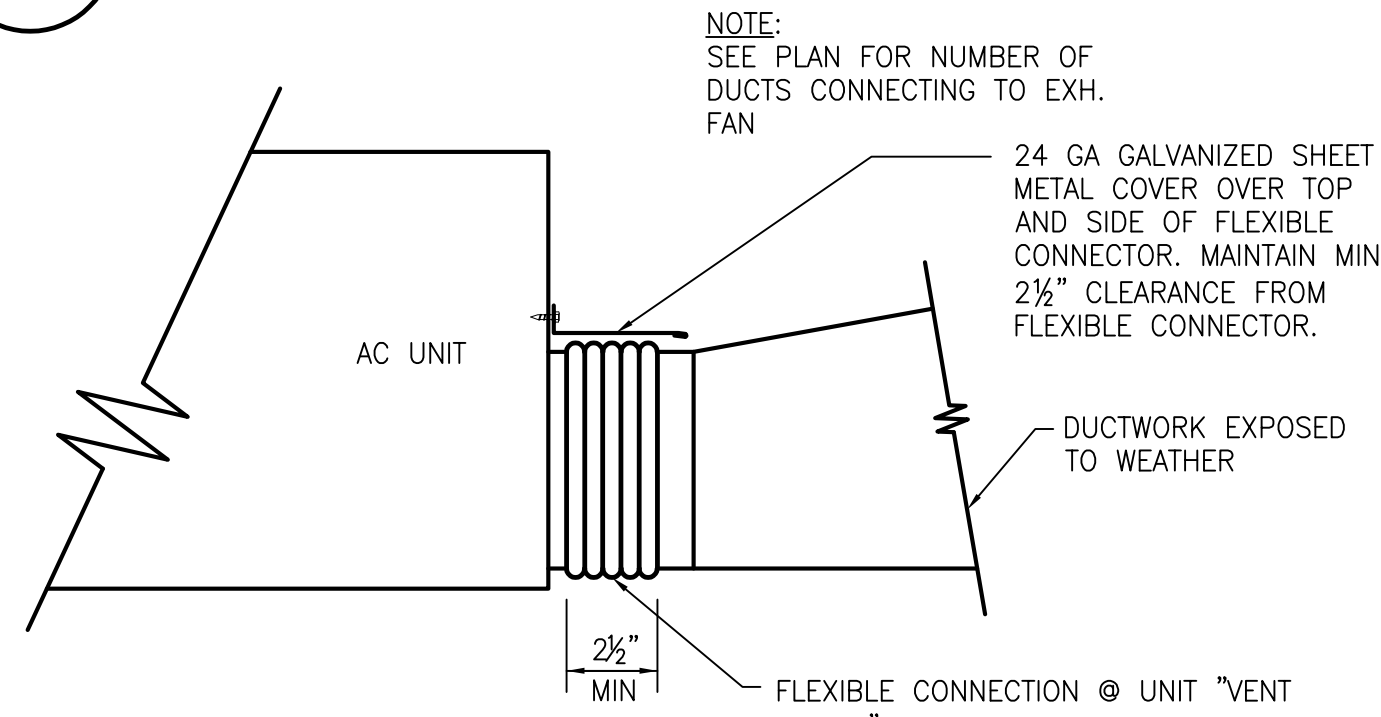


**H** SIDE DUCT FLEX CONNECTOR

NO SCALE

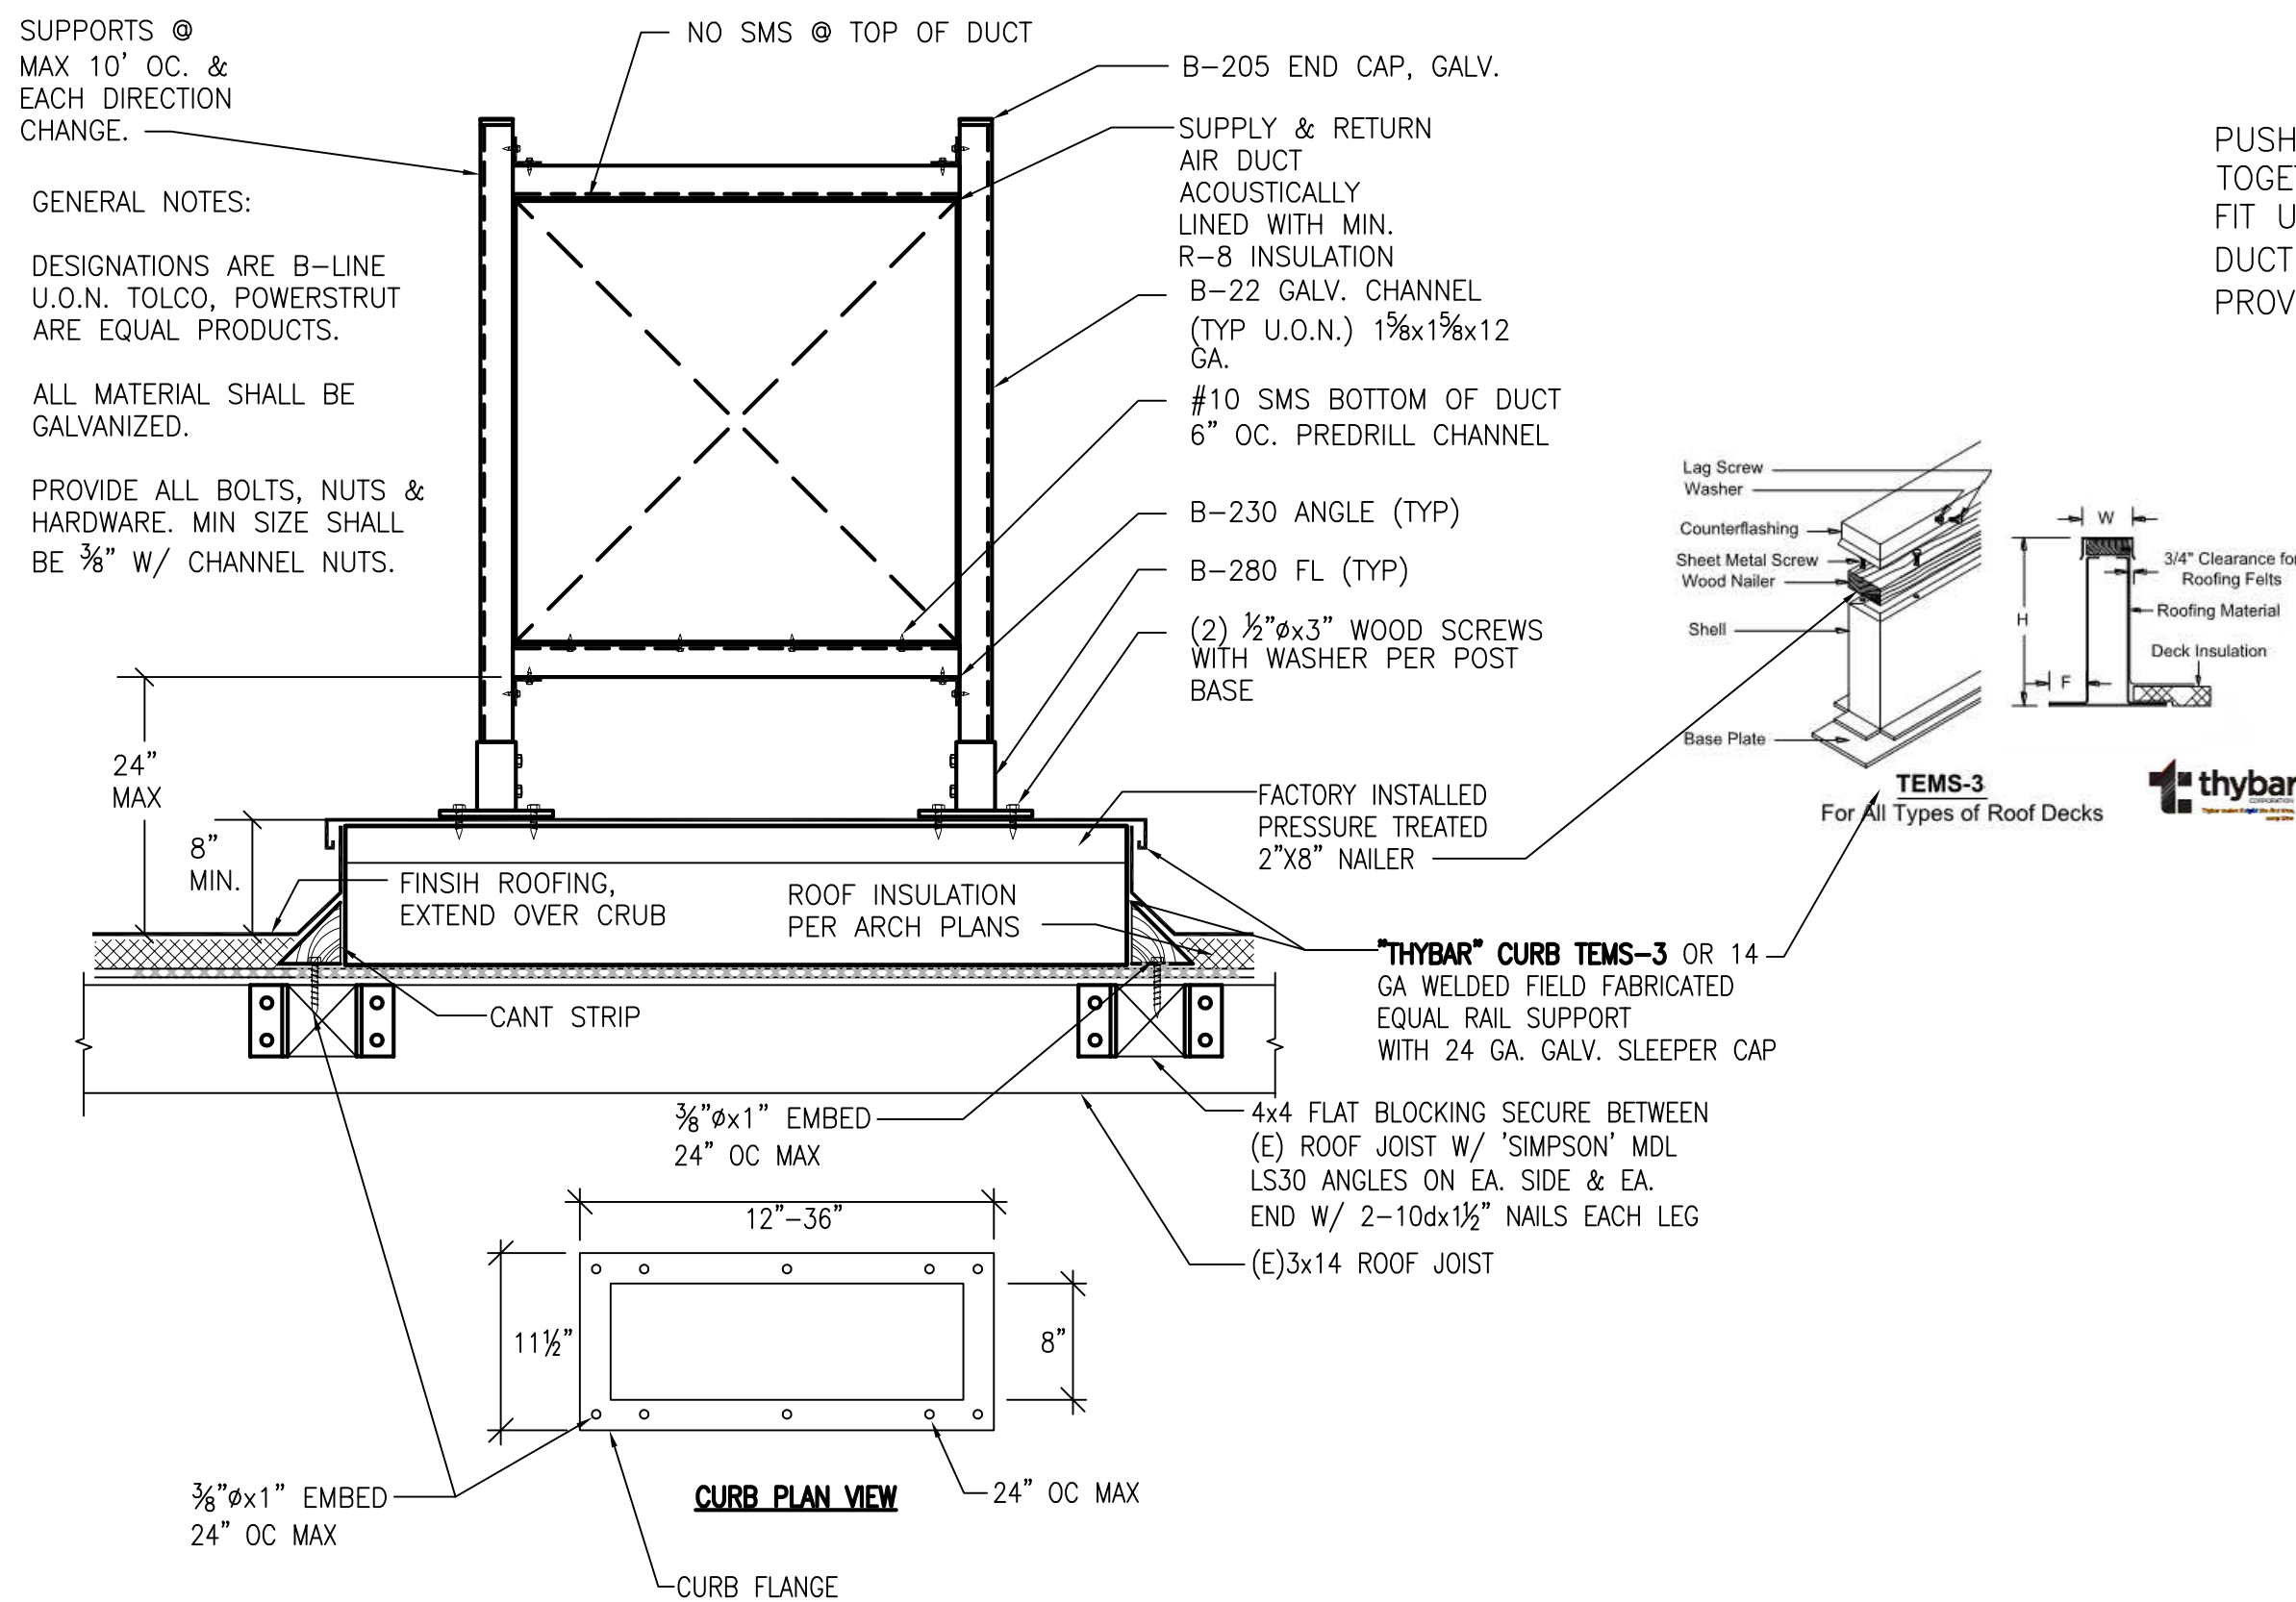


**J** DUCT SUPPORT DETAIL

NO SCALE

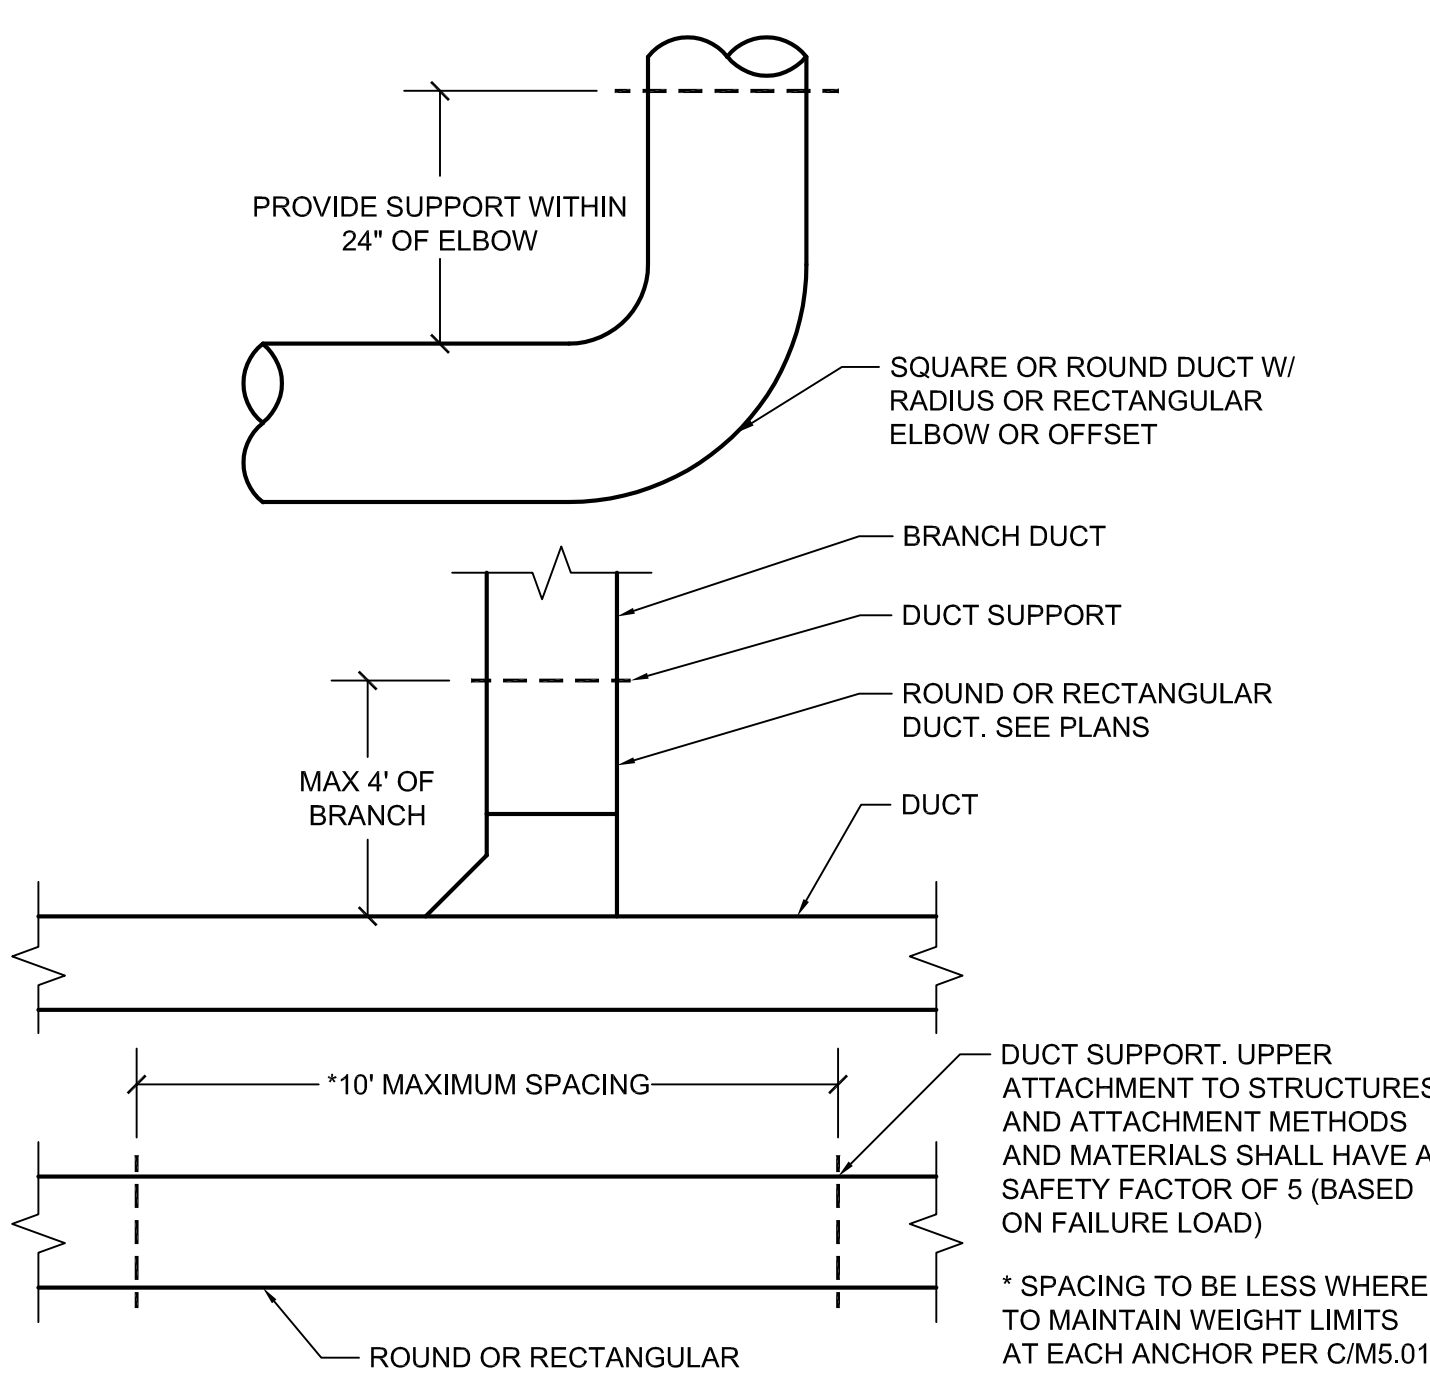

**D** DUCT SUPPORT LOCATION DETAIL

SCALE: NO SCALE

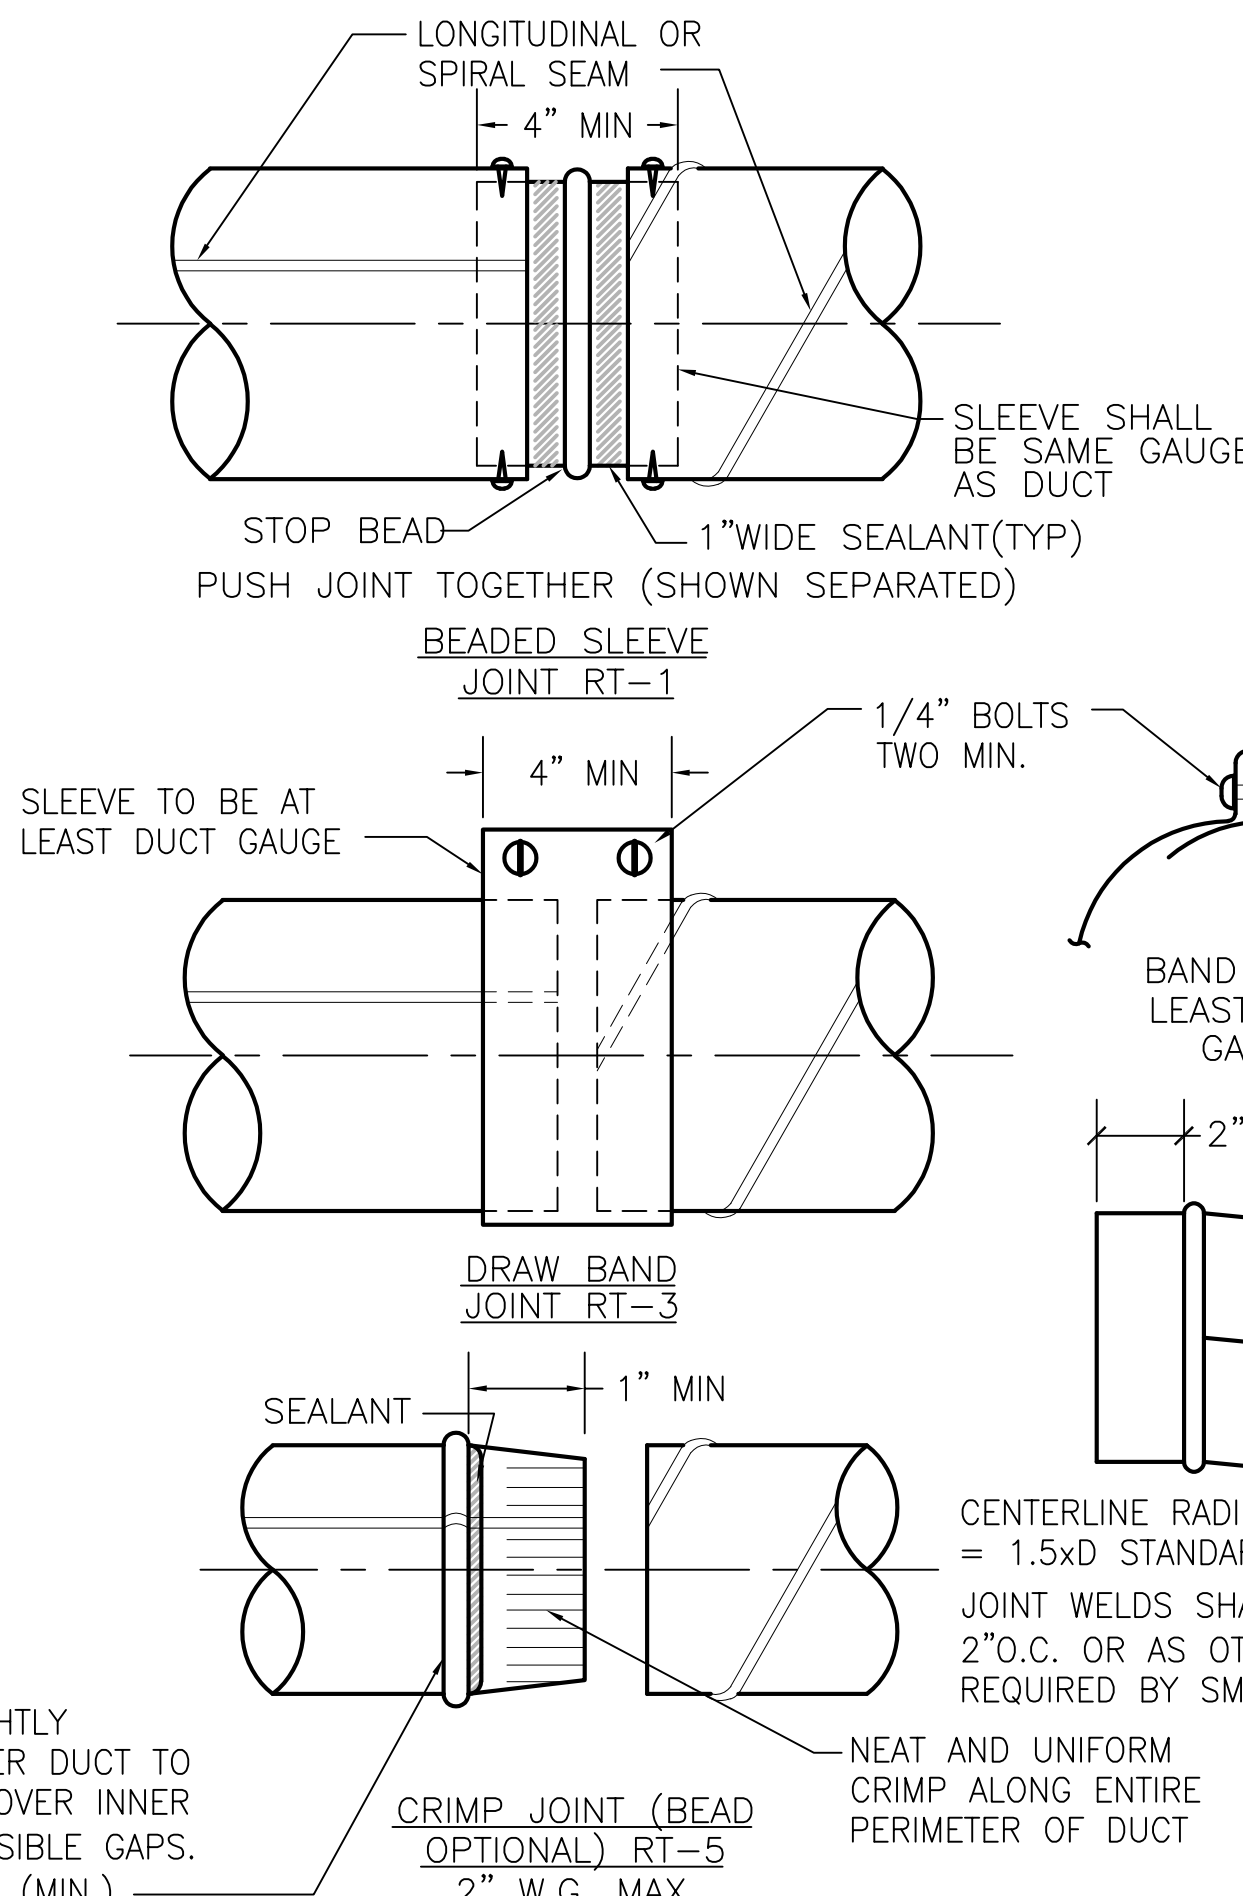


NOTES:

1. ON JOINTS RT-1 & RT-5, #10 SMS MUST BE USED AT UNIFORM INTERVALS OF AT LEAST 10" MAXIMUM ALONG THE CIRCUMFERENCE, PROVIDE THREE SCREWS MINIMUM ON 14" OR LESS DIAMETER.
2. APPLY SEALANT ("DUCTMATE" PROSEAL) TO OUTSIDE OF THE MALE FITTINGS (1" WIDE SPREAD). ASSEMBLE THE JOINT TOGETHER, THOROUGHLY COVER THE JOINT AND SCREW AS PER NOTE 1. BRUSH SEALANT OVER THE ASSEMBLED JOINT.


**E** TYPICAL ROUND DUCT DETAIL

SCALE: NO SCALE

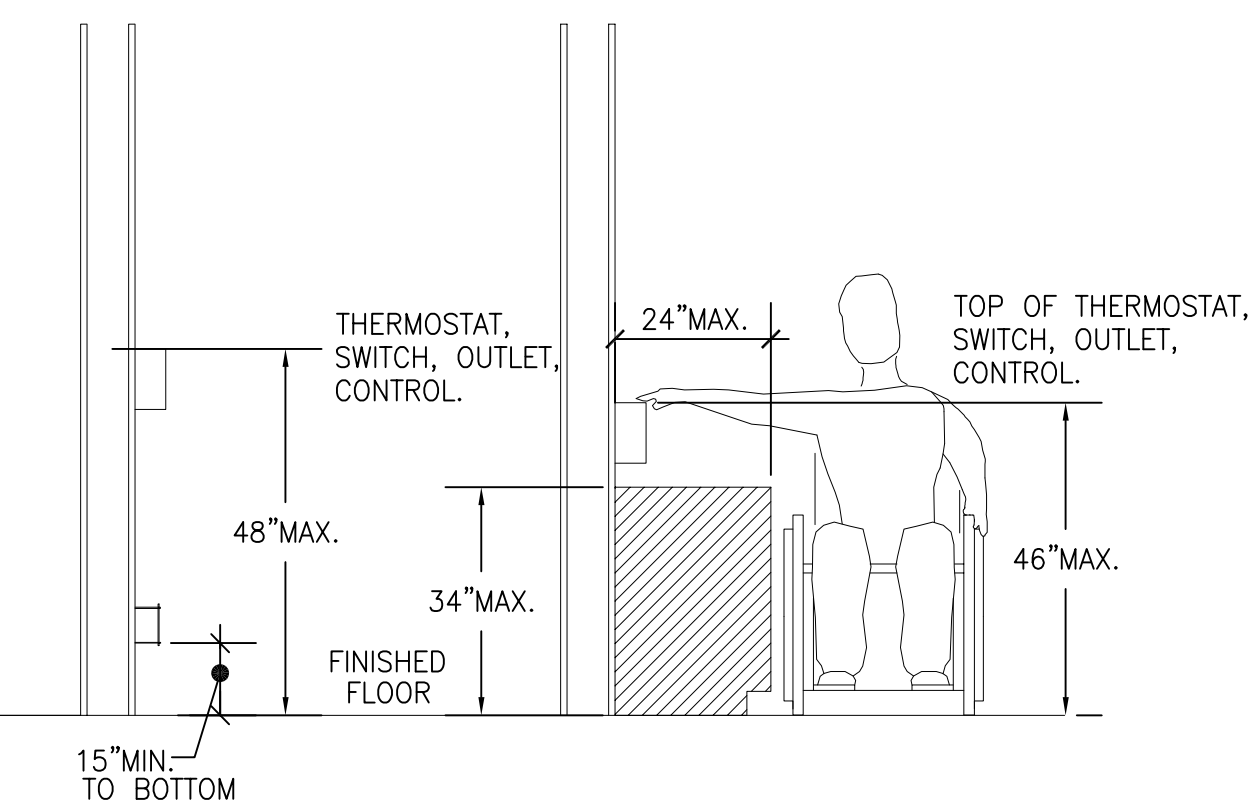


**F** THERMOSTAT MOUNTING DETAIL

SCALE: NO SCALE

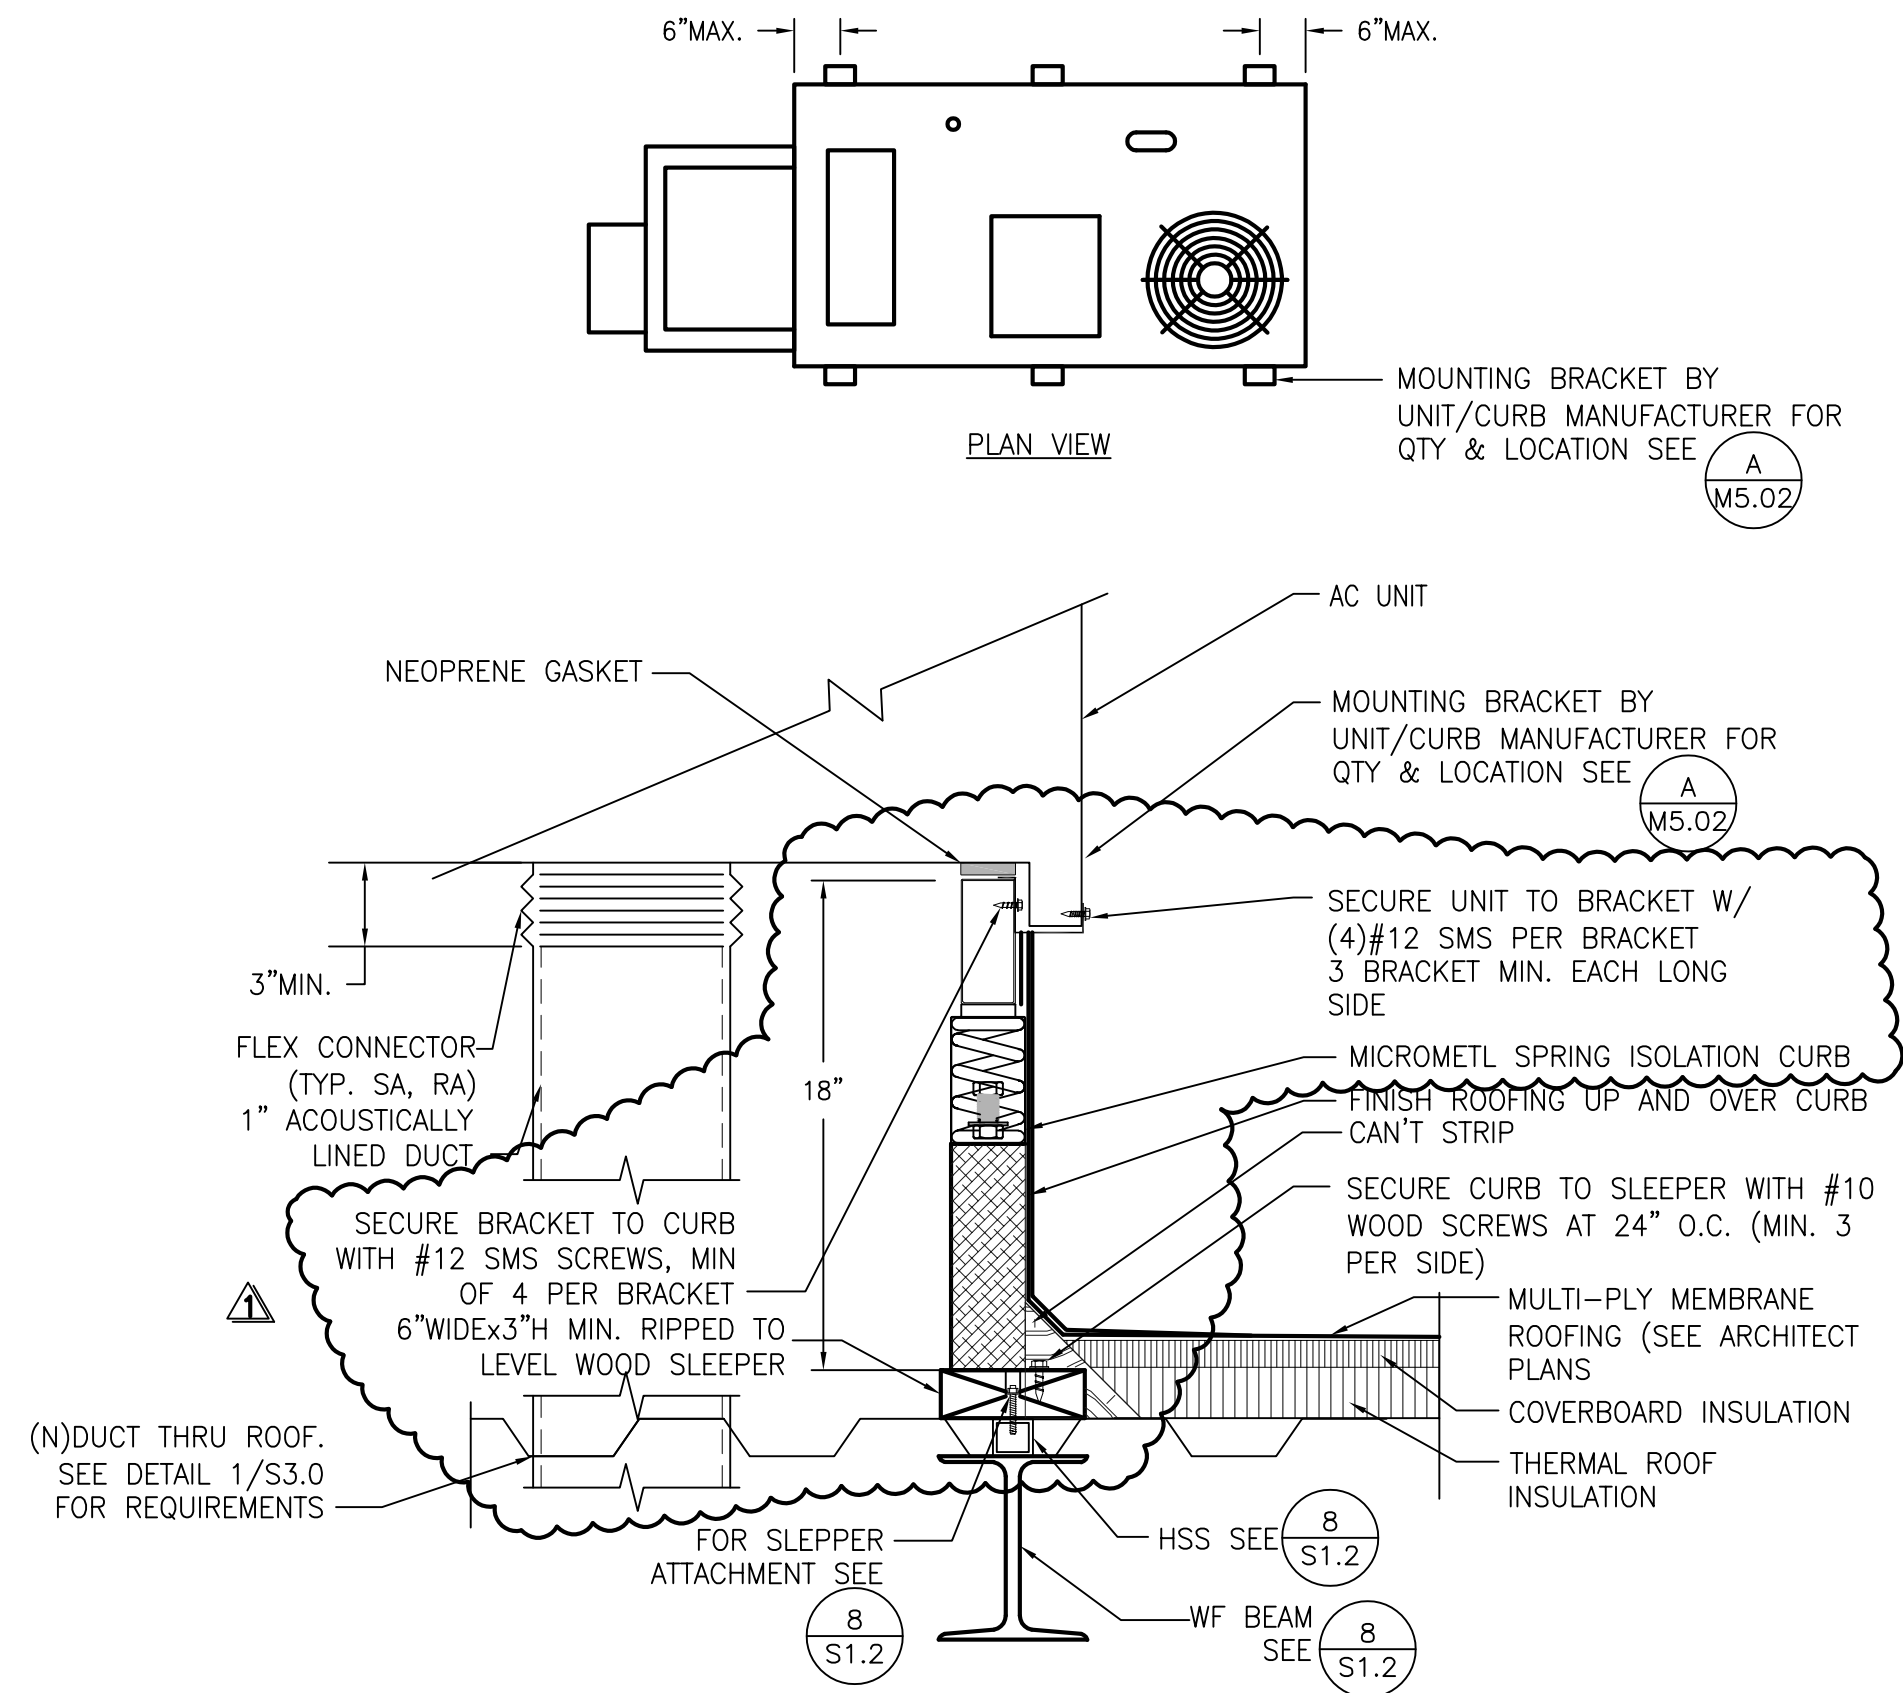

**A** AIR CONDITIONING UNIT MOUNTING DETAIL

SCALE: NO SCALE

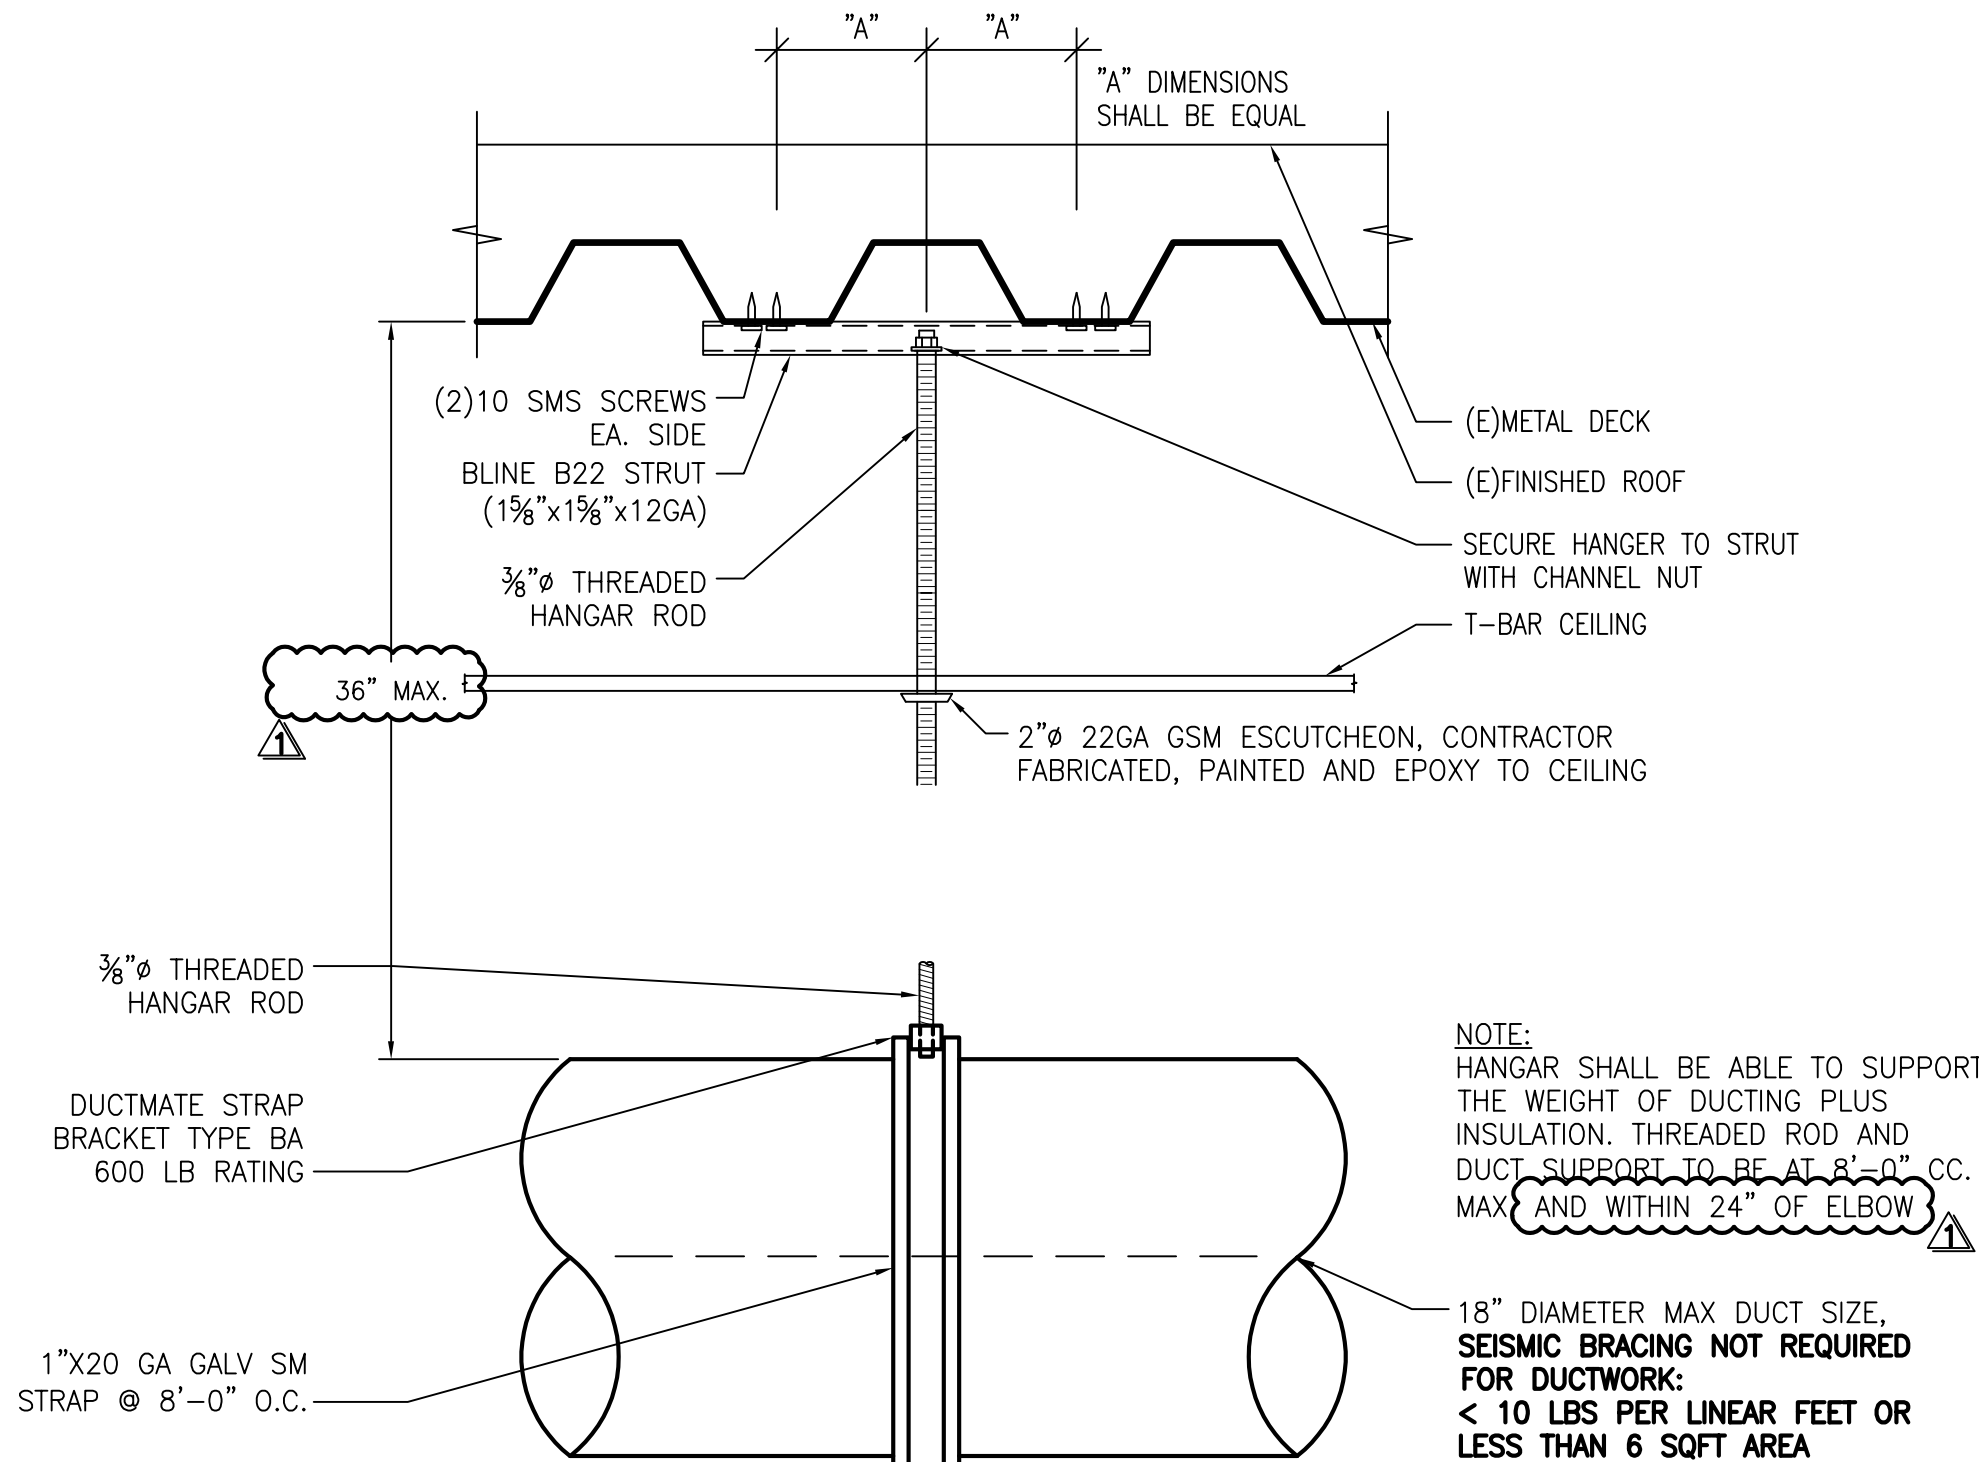

**C** DUCT HANGAR DETAIL

NO SCALE

TURLEY & ASSOCIATES	
2431 Coastal Avenue Davis, CA 95618	TECHNICAL ENGINEERING GROUP, INC. (916) 325-1065 FAX: (916) 325-1055 Email: office@turleyandassociates.com
Project Engineer: JT	Job Number: 17332
Project Manager: NS	File Date: May 22, 2018 - 1:59pm
Project Designer: JN	Scale: 1/8"=1'-0"

This document is the property of the Owner and is not to be used without his written permission.

Architect/Engineer of Record:



**HY HIBSER YAMAUCHI Architects, Inc.**

4602 2nd Street, Suite 3  
Davis, CA 95618

530.758.1270 tel | 530.758.4789 fax

HY Architects Project number: 5077

Facility  
HIRAM JOHNSON HIGH SCHOOL  
6879 14th Ave, Sacramento, CA 95820

Project  
HVAC UPGRADE

Sheet Title  
MECHANICAL DETAILS

Client Project Number: Client Proj. #

Scale: As indicated

Drawn By: NS

Checked By: JT

Issue Date: 4/17/18

Revit Version: 2017

**M5.01**

Sheet 1 of 200


C:\REVIT\5077\_Hiram Johnson HVAC\_Central\_17\_aaltonsoy.rvt

1/23/2018 9:58:27 AM

Z:\User Files\2017\17300 - 17348\17312 - Sac City USD Hiram Johnson Core Academic HVAC Upgrades\M5.01\_17312.dwg MS-DT: 5/22/2018 3:35:57 PM NSHah



IF THIS SHEET IS NOT 30"x42", IT IS  
A REDUCED PRINT SCALE ACCORDINGLY

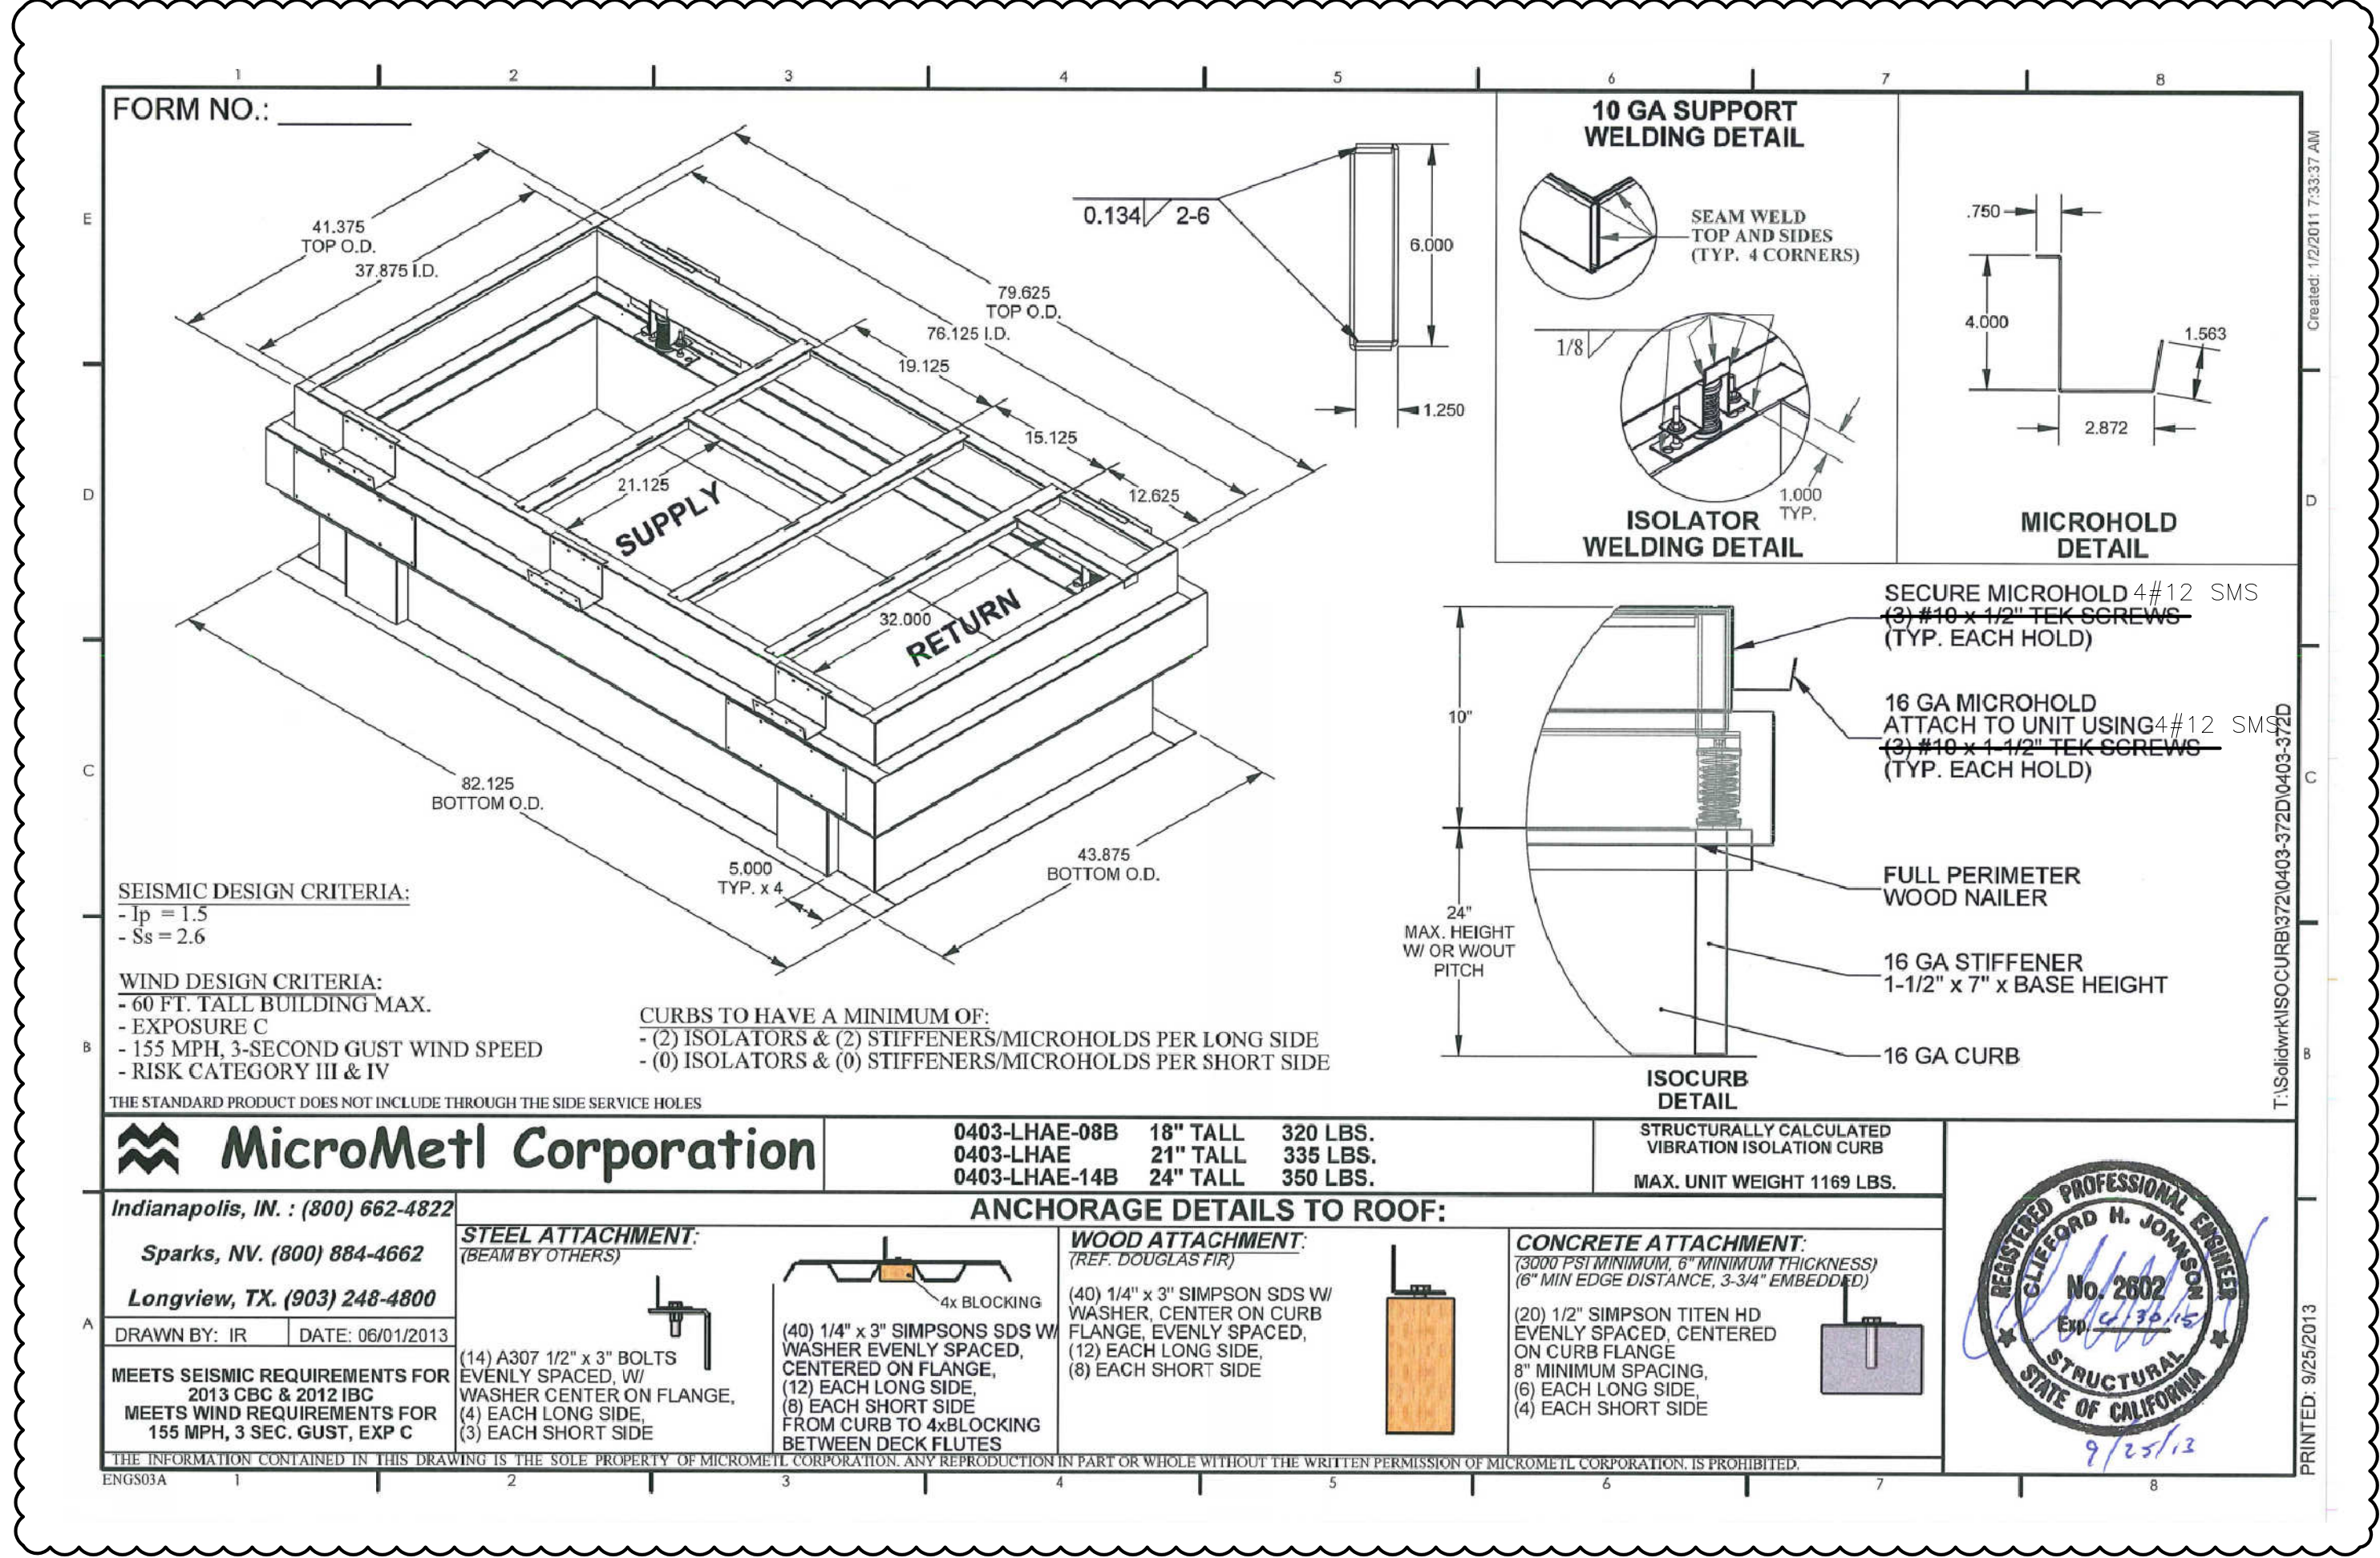


Revisions				
No.	Revisions	By	Date	Appr.
1	Addendum #2		5/22/18	

#### DSA Submittal

ISSUE DATE: 4/17/2018 BY: AA


#### DSA APPROVAL

IDENTIFICATION STAMP  
DIVISION OF STATE ARCHITECT  
APPL 02-116505  
AC \_\_\_\_\_ SS \_\_\_\_\_  
DATE \_\_\_\_\_  
FILE NO. 67439-353

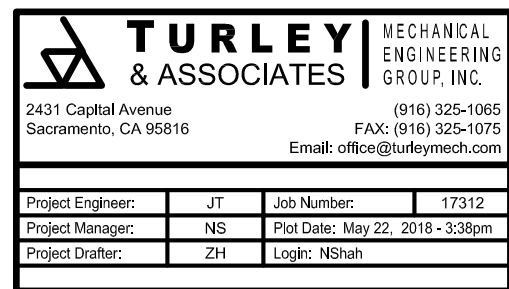

This document is the property of the Owner and is not to be used without his written permission.

Architect/Engineer Of Record:

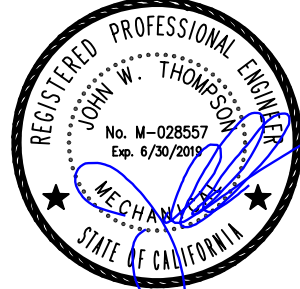

**HIBSER YAMAUCHI**  
**Architects, Inc.**  
4602 2nd Street, Suite 3  
Davis, CA 95618  
530.758.1270 tel | 530.758.4789 fax

HY Architects Project number: 5077

Facility  
HIRAM JOHNSON HIGH SCHOOL  
6879 14th Ave, Sacramento, CA 95820

Project  
HVAC UPGRADE

Sheet Title  
MECHANICAL DETAILS

Client Project Number: Client Proj. #

Scale: As indicated  
Drawn By: NS  
Checked By: JT  
Issue Date: 4/17/18  
Revit Version: 2017

Sheet 1 of 200

**M5.02**



IF THIS SHEET IS NOT 30"x42", IT IS  
A REDUCED PRINT SCALE ACCORDINGLY



Revisions				
No.	Revisions	By	Date	Appr.
1	Addendum #2		5/22/18	

## DSA Submittal

ISSUE DATE: 4/17/2018 BY: AA

## DSA APPROVAL

IDENTIFICATION STAMP DIVISION OF STATE ARCHITECT APPL 02-116505 AC _____ SS _____ DATE _____ FILE NO. 67439-353
--

TURLEY & ASSOCIATES MECHANICAL ENGINEERING GROUP INC.			
2431 Capital Avenue Sacramento, CA 95816	(916) 925-1065 Fax: (916) 925-1075 Email: office@turleyandassociates.com		
Project Engineer: JT	Job Number: 17312		
Project Manager: NS	Proj Date: May 22, 2018 - 1:05pm		
Project Designer: ZH	Scale: 1/8"=1'-0"		

This document is the property of the Owner and is not to be used without his written permission.

Architect/Engineer Of Record:



**HY HIBSER YAMAUCHI Architects, Inc.**  
4602 2nd Street, Suite 3  
Davis, CA 95618  
530.758.1270 tel | 530.758.4789 fax

HY Architects Project number: 5077

Facility  
**HIRAM JOHNSON HIGH SCHOOL**  
6879 14th Ave, Sacramento, CA 95820


Project  
**HVAC UPGRADE**

Sheet Title  
**MECHANICAL CONTROLS**

Client Project Number: Client Proj. #

Scale: As indicated	Sheet
Drawn By: NS	
Checked By: JT	
Issue Date: 4/17/18	
Revit Version: 2017	Sheet 1 of 200

**M6.01**

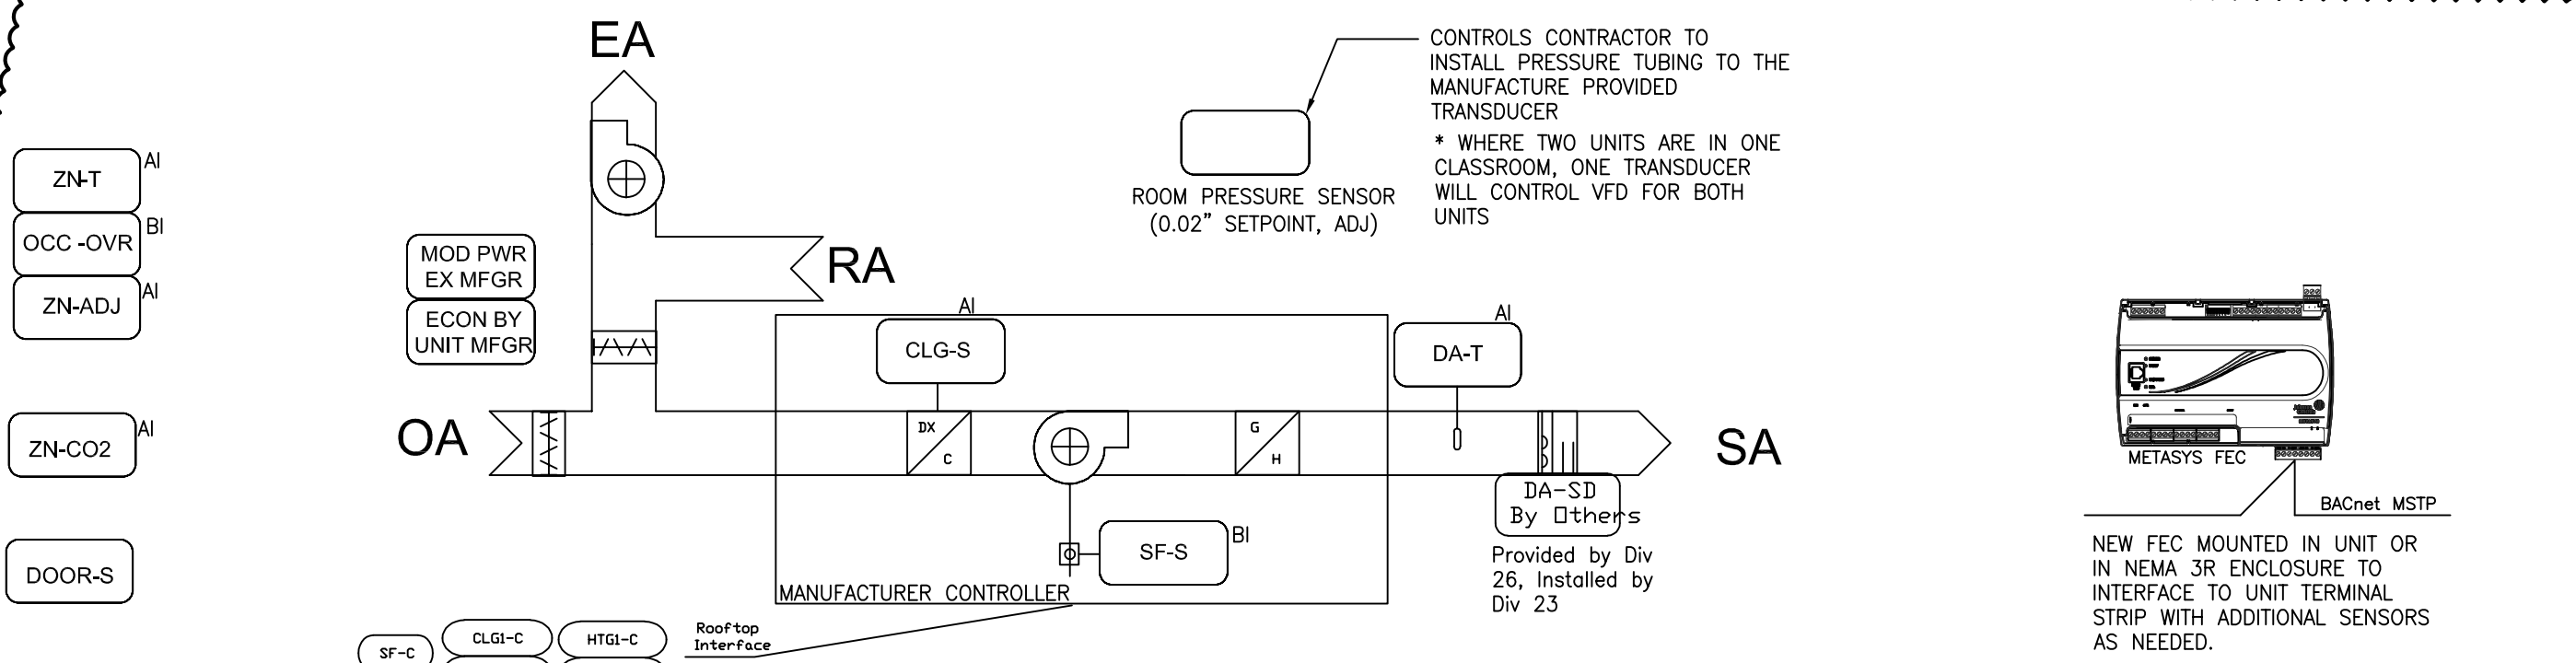

**SUPPLY FAN CONTROL:**  
THE SUPPLY FAN (SF-C) WILL BE STARTED BASED ON OCCUPANCY SCHEDULE. WHEN THE SUPPLY FAN STATUS (SF-S) INDICATES THE FAN STARTED, THE CONTROL SEQUENCE WILL BE ENABLED. UPON A LOSS OF AIRFLOW (SF-S), THE SUPPLY FAN WILL ATTEMPT TO AUTOMATICALLY RESTART UNTIL POSITIVE STATUS IS RECEIVED. WHERE REQUIRED BY T24 CODE, THE UNIT CONTROLLER WILL STAGE THE SPEED OF THE SUPPLY FAN WITH THE STAGE OF COOLING PER ASHRAE SINGLE ZONE VAV GUIDELINES.

**ECONOMIZER CONTROL:**  
WHEN THE OUTDOOR AIR (OA-T) IS COOLER THAN THE ECONOMIZER SETPOINT (ECONSWO-SP), THE ECONOMIZER WILL ACT AS THE INITIAL STAGE OF COOLING, WORKING IN SEQUENCE WITH THE COOLING COIL. THIS WILL BE ACCOMPLISHED VIA THE MANUFACTURE PROVIDED T24 COMPLIANT ECONOMIZER CONTROLLER.

**TEMPERATURE CONTROL:**  
THE UNIT WILL CONTROL TO MAINTAIN THE LOCALLY ADJUSTABLE ZONE TEMPERATURE SETPOINT (ZN-SP) (WC-ADJ) AS SENSED BY THE ZONE TEMPERATURE (ZN-T) SENSOR.

**OCCUPIED MODE:**

THE OCCUPANCY MODE WILL BE CONTROLLED VIA A NETWORK INPUT (OCC-SCHEDULE). THE OCCUPANCY MODE CAN ALSO BE OVERRIDDEN BY A NETWORK INPUT (OCC-OVERRIDE). A TEMPORARY OCCUPANCY BUTTON (ZN-TOCC) ON THE ZONE SENSOR WILL PLACE THE UNIT IN OCCUPIED MODE FOR AN ADJUSTABLE TIME.

**UNOCCUPIED MODE:**

THE UNIT WILL CYCLE TO MAINTAIN UNOCCUPIED ZONE SETPOINTS (CLGUNOCC-SP & HTGUNOCC-SP) DURING UNOCCUPIED PERIODS.

**COOLING COIL:**

THE COOLING COIL (CLGX-C) WILL BE STAGED IN SEQUENCE TO MAINTAIN THE TEMPERATURE SETPOINT INITIALLY SET AT 73 AND VARIABLE AT THE ZONE FROM 73-77.

**GAS HEATING COIL:**

THE HEAT FURNACE WILL BE STAGED IN SEQUENCE TO MAINTAIN THE TEMPERATURE SETPOINT INITIALLY SET AT 70 AND VARIABLE AT THE ZONE FROM 70-74.

**UNIT PROTECTION(WHERE SHOWN):**

DISCHARGE AIR SMOKE DETECTOR (DA-SD) - DISABLES THE FAN(S) VIA A HARD WIRED SHUTDOWN CIRCUIT. SMOKE DETECTOR PROVIDED BY DIV 26 - INTERLOCKED TO CONTROLLER BY DIV 23

**DEMAND CONTROL VENTILATION:**

THE BMS WILL ADDITIONALLY UTILIZE A ZONE CO2 SENSOR FOR DEMAND CONTROLLED VENTILATION - RESETING THE ECONOMIZER MINIMUM POSITION BASED ON THE ZONE CO2 LEVEL. DURING BALANCE THIS POSITION WILL BE DETERMINED TO DELIVER AT LEAST 0.15 CFM/FT^2 WHEN CO2 IS BELOW SET POINT.

**DOOR INTERLOCK (ALL AC UNITS):**

DURING OCCUPIED MODE IF THE BMS SENSES THE DOOR OPEN (DOOR-S) FOR A PERIOD OF 10 MIN (USER ADJUSTABLE) THE BMS DISABLE MECHANICAL COOLING AND HEATING. UPON DOOR CLOSURE FOR 2 MIN MECHANICAL COOLING AND HEATING WILL RESUME PER OCCUPIED SET POINTS.

**ZONE PRESSURE CONTROL:**

THE AC UNITS ARE EQUIPPED WITH A MODULATING POWER EXHAUST ECONOMIZER. THE MODULATING POWER EXHAUST ECONOMIZER WITH FACTORY PROVIDED CONTROLLER WILL MODULATE THE EXHAUST FAN TO MAINTAIN THE ZONE PRESSURE SETPOINT. THE CONTROLS CONTRACTOR IS TO RUN THE PRESSURE TUBING TO ENSURE FACTORY PROVIDED MODULATING POWER EXHAUST CONTROLLER IS READING ACCURATE VALUES.

**ALARMS**

THE BMS SYSTEM SHALL GENERATE AN ALARM IF:

-THE ZONE TEMPERATURE IS 6 DEGREES AWAY FROM SET POINT.

-THE FAN COMMAND DOES NOT MATCH ITS STATUS

-THE COOLING COMMAND DOES NOT MATCH ITS STATUS

ADDITIONAL POINTS MONITORED BY THE FMS:

SUPPLY FAN AMPERAGE (SF-S)


DISCHARGE AIR TEMPERATURE (DA-T)

COMPRESSOR AMPERAGE (COMP-S)

CLASSROOM D-9 EXHAUST SYSTEM: DURING OCCUPIED HOURS IF THE SPACE PRESSURE DROPS BELOW 0.00" THE PE VFD WILL BE TURNED OFF. IF THE SPACES PRESSURE DROPS BELOW 0.00" THE OUTSIDE AIR DAMPER ON THE AC UNIT (D-9A AND D-9B) WILL MODULATE OPEN TO MAINTAIN THE SPACE PRESSURE OF 0.01".

## PACKAGED ROOFTOP UNIT CONTROL DIAGRAM

NO SCALE

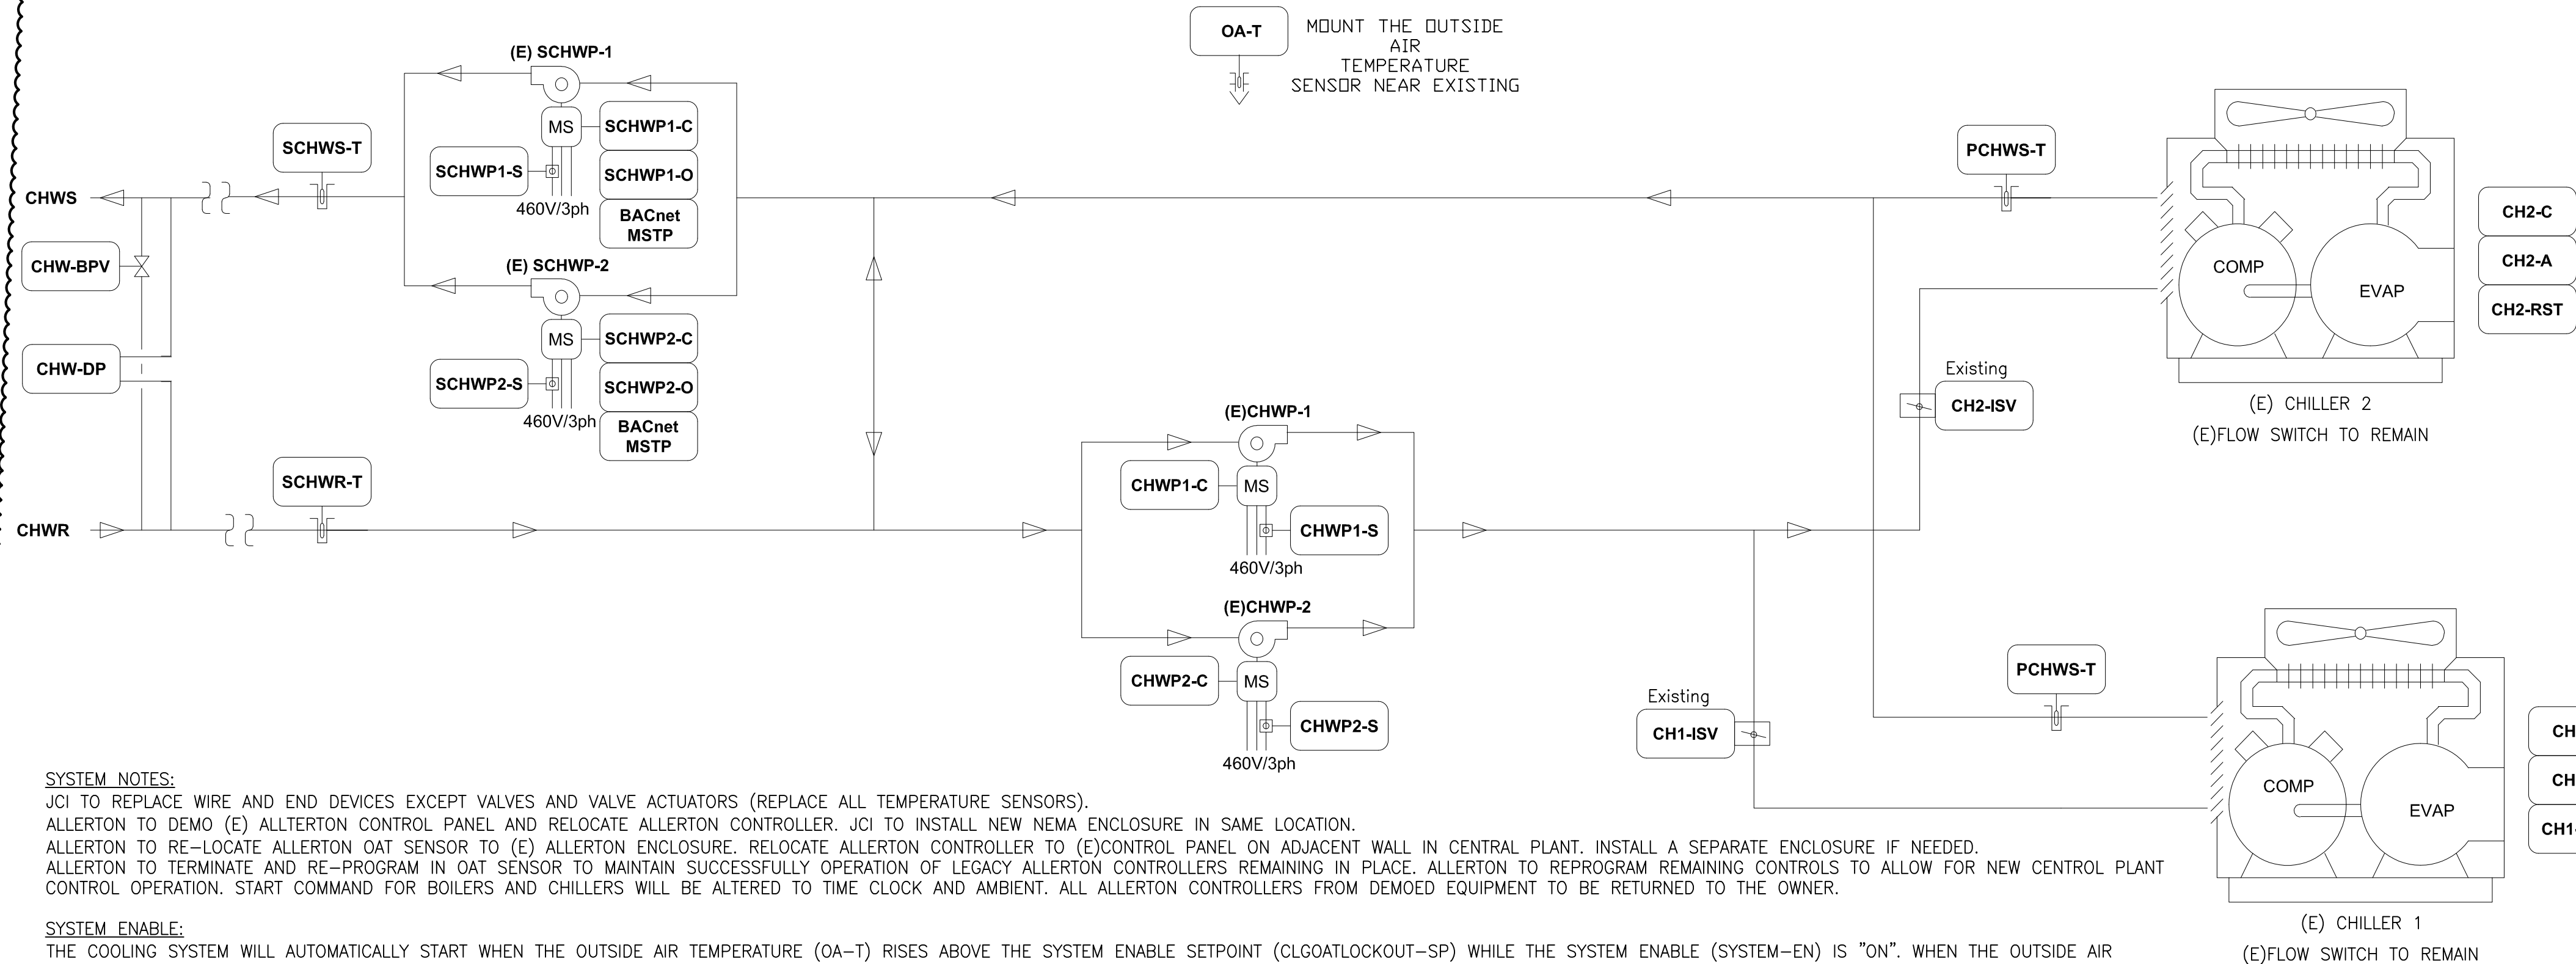

**SYSTEM NOTES:**

JCI TO REPLACE WIRE AND END DEVICES EXCEPT VALVES AND VALVE ACTUATORS (REPLACE ALL TEMPERATURE SENSORS).

ALLERTON TO DEMO (E) ALLERTON CONTROL PANEL AND RELOCATE ALLERTON CONTROLLER. JCI TO INSTALL NEW NEMA ENCLOSURE IN SAME LOCATION.

ALLERTON TO RE-LOCATE ALLERTON OAT SENSOR TO (E) ALLERTON ENCLOSURE. RELOCATE ALLERTON CONTROLLER TO (E)CONTROL PANEL ON ADJACENT WALL IF NEEDED.

ALLERTON TO TERMINATE AND RE-PROGRAM IN OAT SENSOR TO MAINTAIN SUCCESSFULLY OPERATION OF LEGACY ALLERTON CONTROLLERS REMAINING IN PLACE. ALLERTON TO REPROGRAM REMAINING CONTROLS TO ALLOW FOR NEW CENTROL PLANT CONTROL OPERATION. START COMMAND FOR BOILERS AND CHILLERS WILL BE ALTERED TO TIME CLOCK AND AMBIENT. ALL ALLERTON CONTROLLERS FROM DEMOED EQUIPMENT TO BE RETURNED TO THE OWNER.

**SYSTEM ENABLE:**

THE COOLING SYSTEM WILL AUTOMATICALLY START WHEN THE OUTSIDE AIR TEMPERATURE (OA-T) RISES ABOVE THE SYSTEM ENABLE SETPOINT (CLGOATLOCKOUT-SP) WHILE THE SYSTEM ENABLE (SYSTEM-EN) IS "ON". WHEN THE OUTSIDE AIR TEMPERATURE (OA-T) FALLS BELOW THIS SETPOINT (CLGOATLOCKOUT-SP) OR THE SYSTEM ENABLE (SYSTEM-EN) IS "OFF", THE COOLING SYSTEM WILL BE DISABLED.

**CHILLER CONTROL:**

THIS SYSTEM CONSISTS OF TWO CHILLERS. THE CHILLERS SHALL BE CONTROLLED VIA THEIR OWN INTERNAL CONTROLS TO MAINTAIN A CHILLED WATER SUPPLY TEMPERATURE. EACH CHILLER (CHX-EN) WILL BE STAGED ON AND OFF IN ORDER TO MAINTAIN THE DIFFERENTIAL SETPOINT (CHWDT-SP) BETWEEN THE SUPPLY (SCHWS-T) AND RETURN (SCHWR-T) TEMPERATURES. WHEN A CHILLER IS REQUIRED, THE CHILLER WITH THE LOWEST RUNTIME TOTAL SHALL BE ENABLED TO RUN. THE CHILLER ISOLATION VALVE (CHXCHWISO-C) WILL BE COMMANDED OPEN PRIOR TO STARTING THE PUMP AND KEPT OPEN LONG ENOUGH FOR THE PUMP TO COAST DOWN. THE CHILLER SETPOINT (CHX-RST) WILL BE CONTROLLED REMOTELY VIA THE FMS. THE SECOND CHILLER WILL BE ENABLED ONLY IF THE FIRST CHILLER IS UNABLE TO MAINTAIN SCHWS-T SETPOINT.

**CHILLED WATER PUMP CONTROL:**

WHEN ENABLED, A PUMP (PCHWPX-C) FOR EACH CHILLER WILL BE STARTED. AFTER THE CHILLER IS COMMANDED OFF, THE PUMP (PCHWPX-C) WILL CONTINUE TO RUN FOR A SHORT TIME TO ALLOW THE EQUIPMENT TO COAST DOWN. WHEN AN ADDITIONAL PUMP (PCHWPX-C) IS REQUIRED, THE PUMP (PCHWPX-C) WITH THE LOWEST RUNTIME TOTAL SHALL BE ENABLED TO RUN. IF THE PUMP STATUS (PCHWPX-S) DOES NOT MATCH THE COMMAND (PCHWPX-C), AN ALARM WILL BE GENERATED. AND THE PUMP WILL BE STOPPED. UPON LOSS OF STATUS (PCHWPX-S), THE PUMP (PCHWPX-C) WILL RESTART AFTER THE SYSTEM RESET (SYS-RESET) IS ACTIVATED. PRIMARY CHILLED WATER PUMP(S) ARE ENABLED FROM TIME CLOCK FUNCTION AND AMBIENT TEMPERATURE. PRIMARY LEAD PUMP TO BE ENABLED AT 65°F AMBIENT OCCUPIED PERIODS.

**SECONDARY LOOP PUMPING:**

THE LEAD SECONDARY PUMP (SCHWPX-C) WILL BE STARTED WHEN THE SYSTEM IS ENABLED. THE VARIABLE FREQUENCY DRIVE (SCHWPX-O) WILL BE MODULATED IN UNISON TO MAINTAIN LOOP PRESSURE (CHW-DP). ADDITIONAL PUMPS (SCHWPX-C) WILL BE STARTED AS REQUIRED TO MAINTAIN THE DIFFERENTIAL PRESSURE (CHW-DP) IN THE SECONDARY LOOP (8PSI ADJUSTABLE). A BYPASS VALVE (CHWBYPV-O) WILL BE MODULATED TO MAINTAIN DIFFERENTIAL PRESSURE SETPOINT (CHWDP-SP) IN THE SECONDARY WATER LOOP WHEN THE PUMP OUTPUT (SCHWPX-O) IS COMMANDED TO MINIMUM SPEED (20 Hz). WHEN AN ADDITIONAL PUMP (SCHWPX-C) IS REQUIRED, THE PUMP WITH THE LOWEST RUNTIME TOTAL SHALL BE ENABLED TO RUN. IF THE PUMP STATUS (SCHWPX-S) DOES NOT MATCH THE COMMAND (SCHWPX-C), AN ALARM WILL BE GENERATED AND THE PUMP WILL BE STOPPED. UPON LOSS OF STATUS (SCHWPX-S), THE PUMP (SCHWPX-C) WILL RESTART AFTER THE SYSTEM RESET (SYS-RESET) IS ACTIVATED.

**ADDITIONAL POINTS MONITORED BY THE FMS:**

CHILLER N STATUS (CHN-S)

CHILLER N ALARM (CHN-A)

CHILLER N LEAVING WATER TEMPERATURE (CHNCHWL-T)



SECONDARY SUPPLY TEMPERATURE (SCHWS-T)

SECONDARY RETURN TEMPERATURE (SCHWR-T)

OUTDOOR AIR TEMPERATURE (OA-T)

## AIR COOLED CHILLER FLOW DIAGRAM

NO SCALE

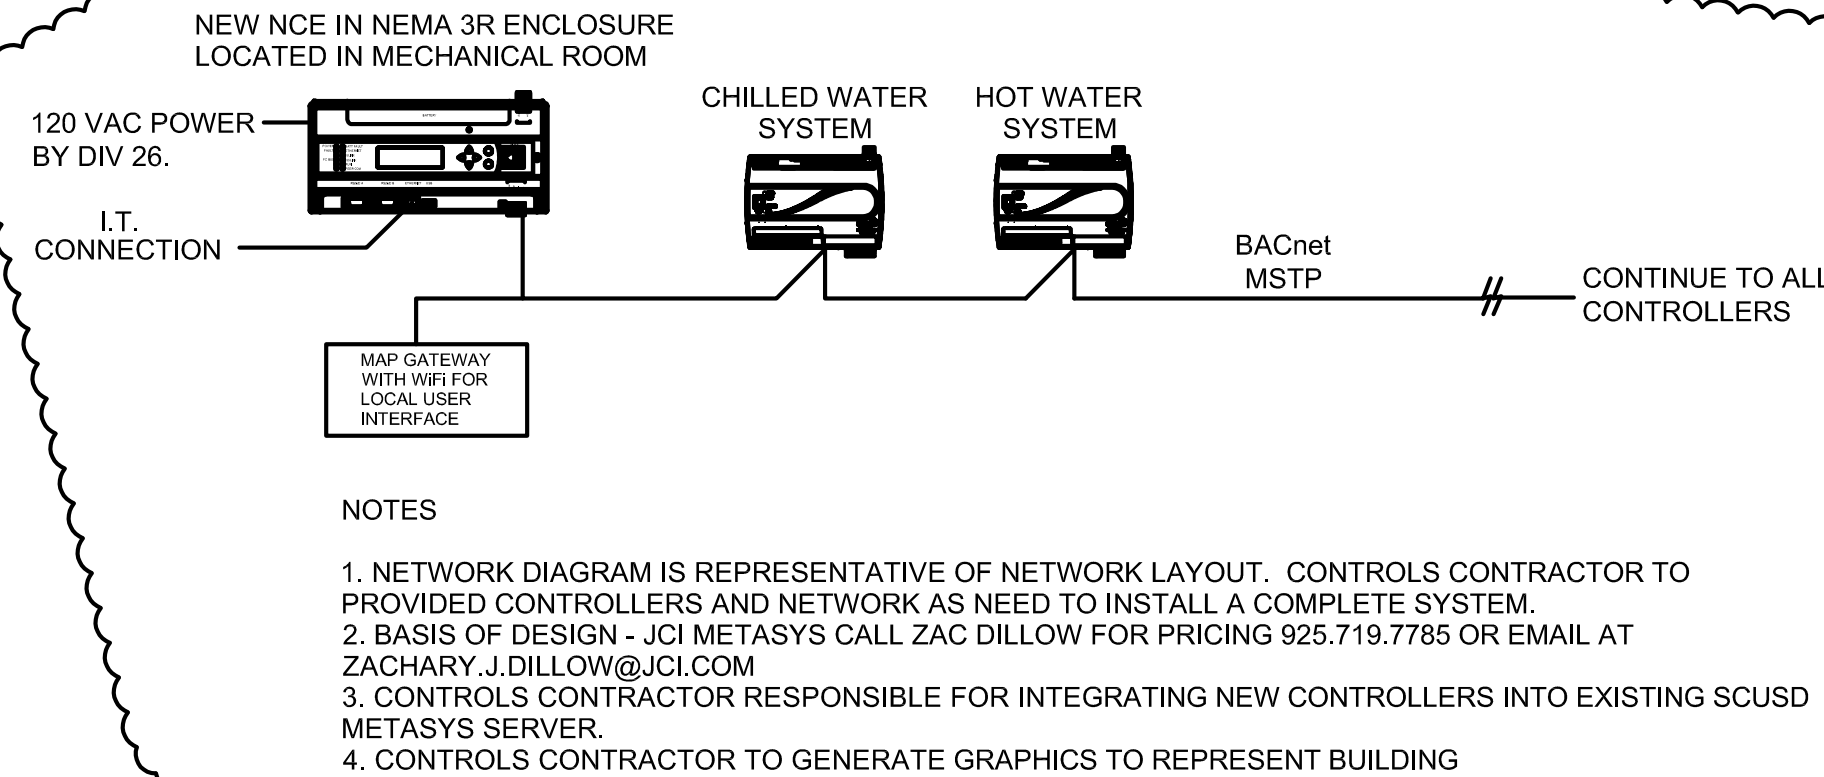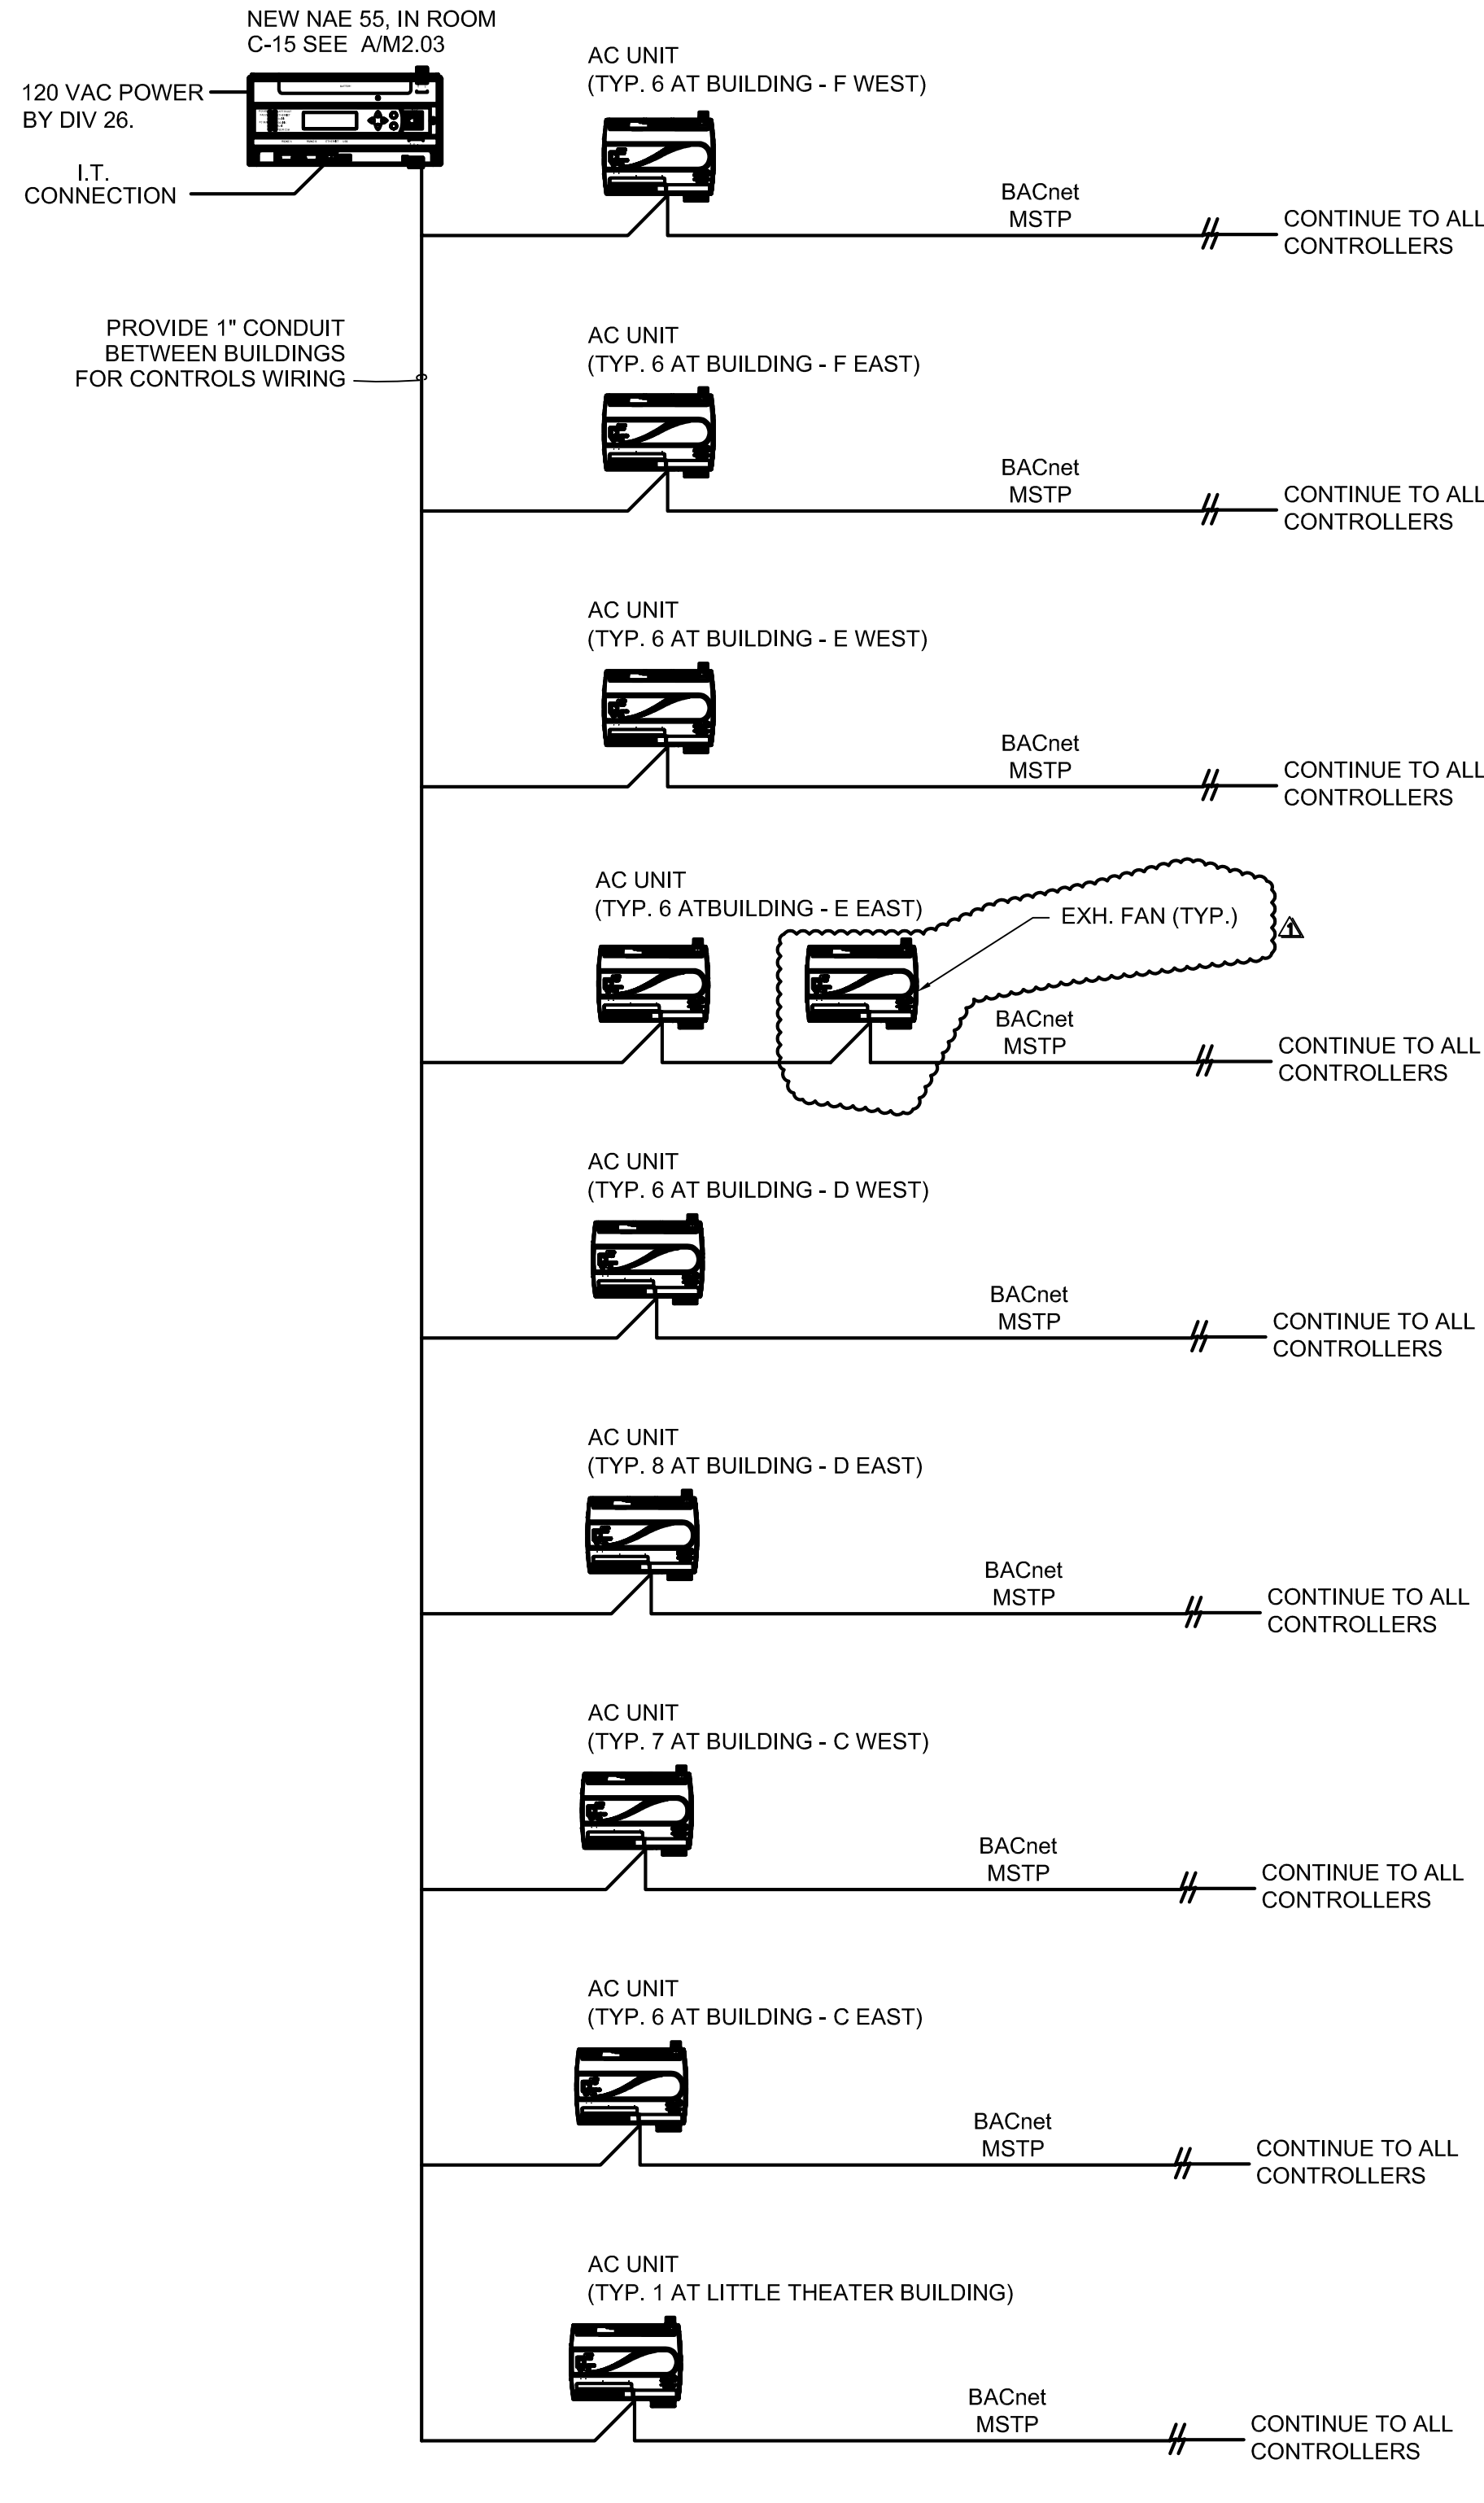

## NETWORK RISER DIAGRAM

NO SCALE







NO SCALE

C:\REV\17312 - Hiram Johnson HVAC Central\_17\_allnotes.rvt


1/23/2018 9:58:27

AM

Z:\User Files\2017\17300 - 17348\17312 - Sac. City USD Hiram Johnson Core Academic HVAC Upgrades\M6.01\_17312.dwg, ME.01, 5/22/2018 3:58:02 PM, NShah

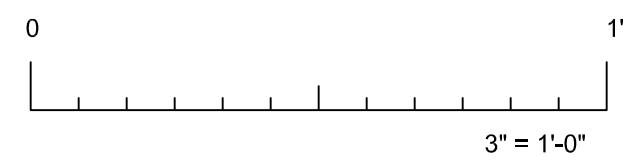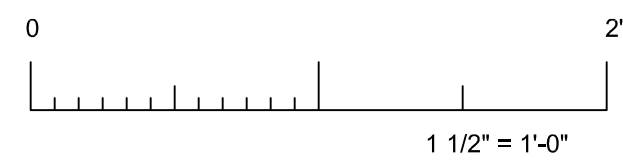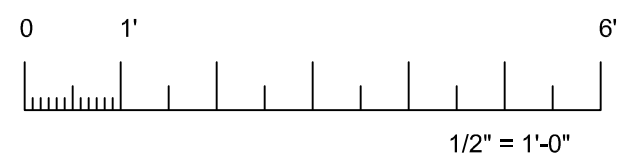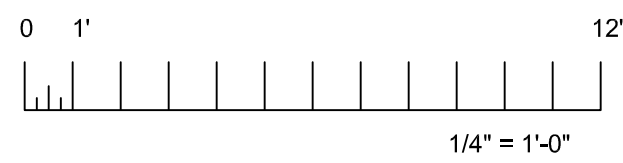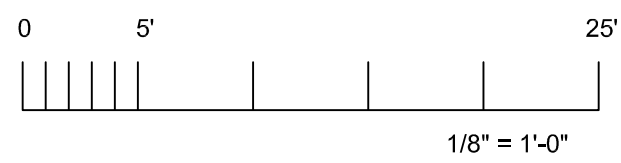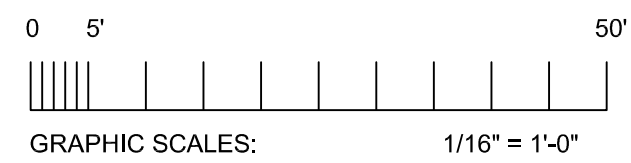

IF THIS SHEET IS NOT 30"x42" , IT IS  
A REDUCED PRINT SCALE ACCORDINGLY

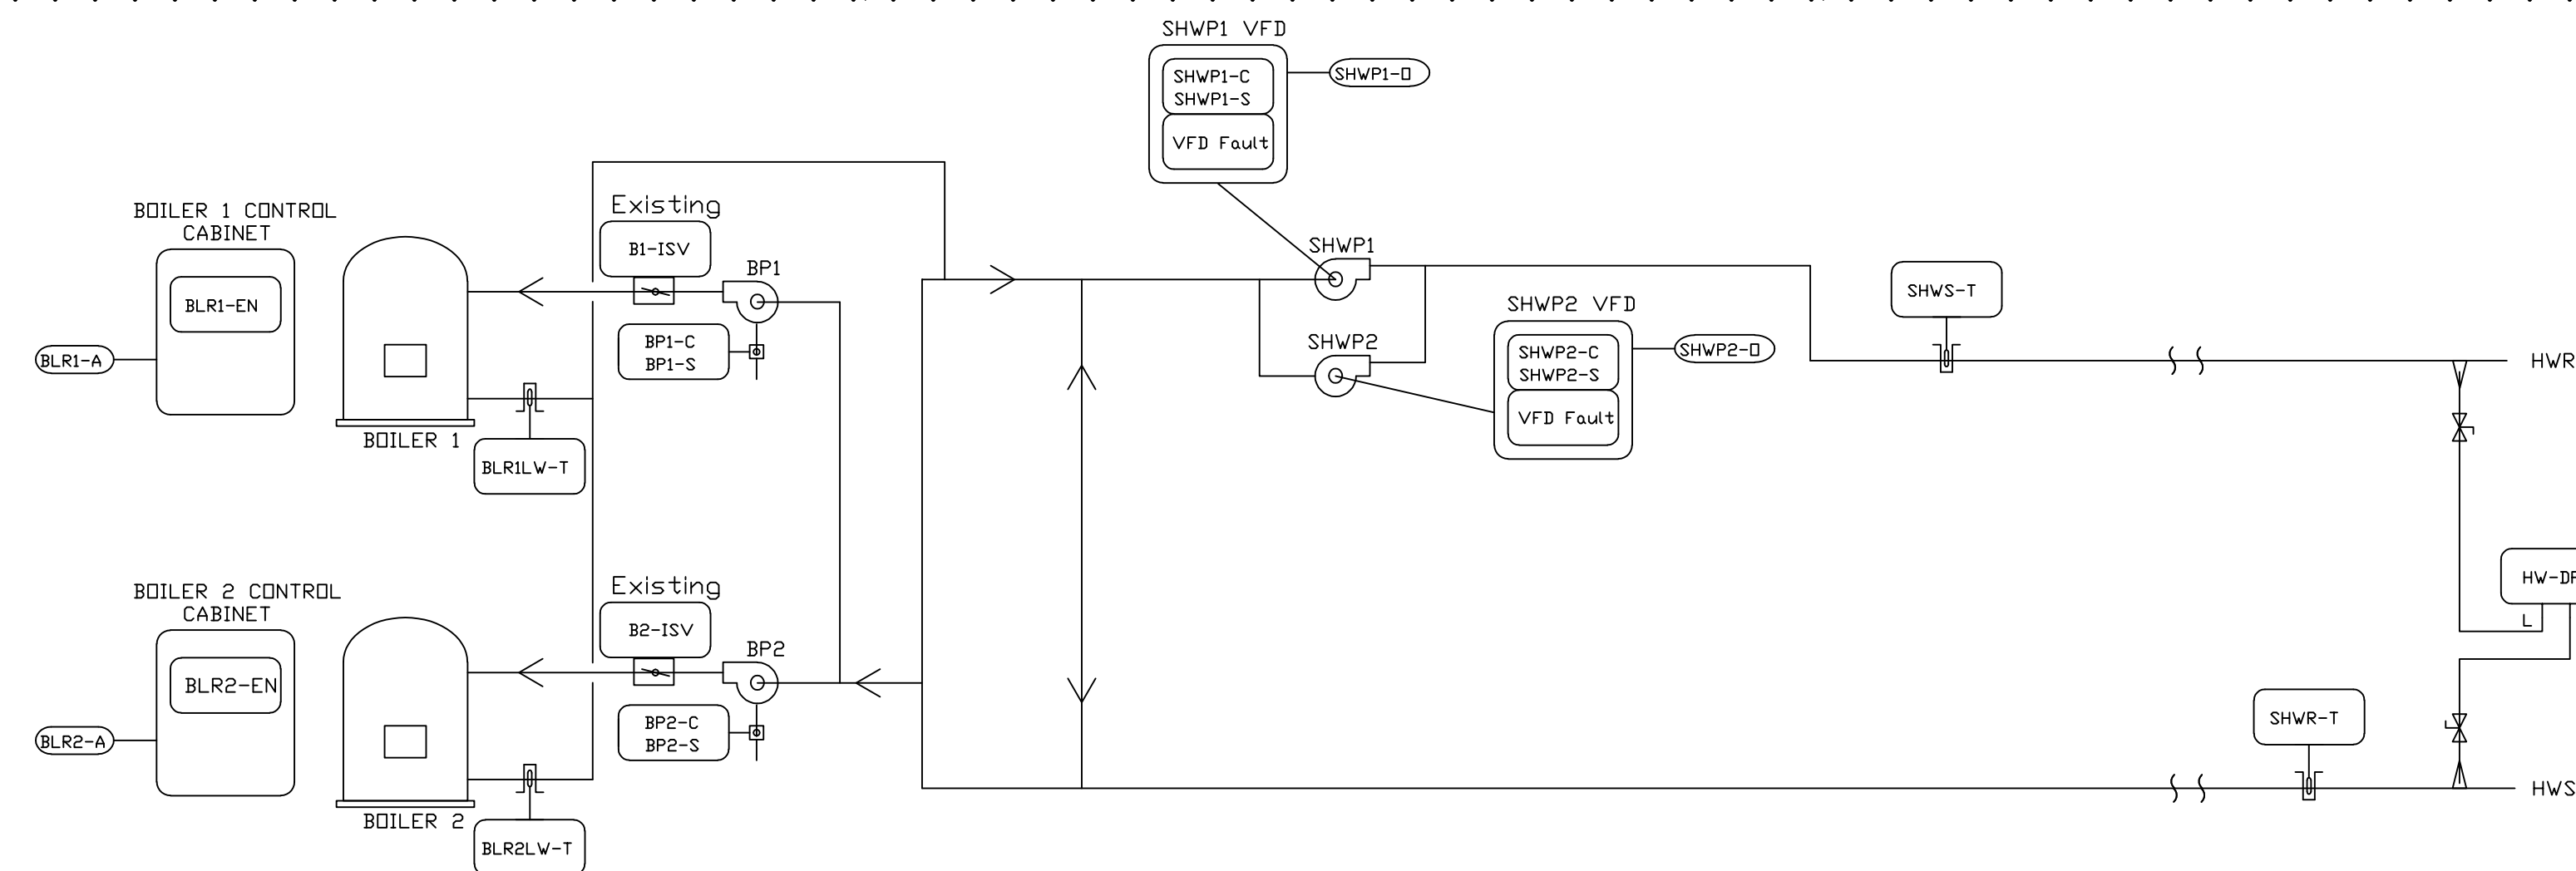

SYSTEM NOTES:

JCI TO REPLACE WIRE AND END DEVICES EXCEPT VALVES AND VALVE ACTUATORS (PROVIDE NEW TEMPERATURE SENSORS).  
 ALLOCATION TO DEMO (E) ALTERNATOR CONTROL PANEL AND RELOCATE ALTERNATOR CONTROLLER. JCI TO INSTALL NEW NEMA ENCLOSURE IN SAME LOCATION.  
 ALLOCATION TO RE-LOCATE ALTERNATOR END SENSOR TO (E) ALTERNATOR ENCLOSURE. RELOCATE ALTERNATOR CONTROLLER TO (E)CONTROL PANEL ON ADJACENT WALL.  
 IN GENERAL, JCI TO INSTALL A SEPARATE END SENSOR IF NEEDED.  
 ALLOCATION TO TERMINATE AND REPROGRAM IN-OUT SENSORS TO MAINTAIN SUCCESSFULLY OPERATION OF LEGACY ALTERNATOR CONTROLLERS REMAINING IN PLACE.  
 ALLOCATION TO REPROGRAM REMAINING CONTROLS TO ALLOW FOR NEW CENTRAL PLANT CONTROL OPERATION. START COMMAND FOR BOILERS AND CHILLERS WILL BE ALTERED TO TIME CLOCK AND AMBIENT. ALL ALTERNATOR CONTROLLERS FROM DEMOED EQUIPMENT TO BE RETURNED TO THE OWNER.

SYSTEM ENABLE:

THE HEATING SYSTEM WILL AUTOMATICALLY START WHEN THE OUTSIDE AIR TEMPERATURE (OA-T) FALLS BELOW THE SYSTEM ENABLE SETPOINT (60°F ADJUSTABLE) AND THE BUILDINGS ARE IN "OCCUPIED" SCHEDULE. WHEN THE OUTSIDE AIR TEMPERATURE (OA-T) RISES ABOVE THIS SETPOINT (HTGOATLOCKOUT-SP) OR THE SYSTEM ENABLE (SYSTEM-EN) IS "OFF", THE HEATING SYSTEM WILL BE DISABLED.

BOILER CONTROL:

THIS SYSTEM CONSISTS OF TWO BOILERS (BLRX-EN). THE BURNERS SHALL BE CONTROLLED VIA THEIR OWN INTERNAL CONTROLS. THE OUTDOOR AIR TEMPERATURE (OA-T) SHALL DETERMINE THE NUMBER OF BOILERS RUNNING OR IF THE BOILER CANNOT SATISFY BOILER SETPOINT TEMPERATURE. WHEN AN ADDITIONAL BOILER IS REQUIRED, THE BOILER WITH THE LOWEST RUNTIME TOTAL SHALL BE ENABLED TO RUN. THE BOILERS WILL WORK IN SEQUENCE TO MAINTAIN A SUPPLY WATER TEMPERATURE OF 170°F. THE BOILER ISOLATION VALVE (BLRXISO-C) WILL BE COMMANDED OPEN PRIOR TO STARTING THE PUMP AND KEPT OPEN LONG ENOUGH FOR THE PUMP TO COAST DOWN.

HOT WATER PUMP CONTROL:

WHEN ENABLED, A PUMP (PHWPX-C) FOR EACH BOILER WILL BE STARTED. AFTER THE BOILER IS COMMANDED OFF, THE PUMP (PHWPX-C) WILL CONTINUE TO RUN FOR A SHORT TIME (5 MINUTES) TO DISSIPATE THE HEAT. IF THE PUMP STATUS (PHWPX-S) DOES NOT MATCH THE COMMAND (PHWPX-C), AN ALARM WILL BE GENERATED AND THE PUMP WILL BE STOPPED. UPON LOSS OF STATUS (PHWPX-S), THE PUMP (PHWPX-C) WILL RESTART AFTER THE SYSTEM RESET (SYS-RESET) IS MANUALLY ACTIVATED.

### SECONDARY LOOP PUMPING:

THE LEAD SECONDARY PUMP (SHWPX-C) WILL BE STARTED WHEN THE SYSTEM IS ENABLED. EACH VARIABLE FREQUENCY DRIVE (SHWPX-O) WILL BE MODULATED IN TO MAINTAIN LOOP PRESSURE (HW-DP). ADDITIONAL PUMP WILL BE STARTED AS REQUIRED TO MAINTAIN THE DIFFERENTIAL PRESSURE IN THE SECONDARY LOOP. WHEN AN ADDITIONAL PUMP (SHWPX-C) IS REQUIRED, THE PUMP WITH THE LOWEST RUNTIME TOTAL SHALL BE ENABLED TO RUN. IF THE PUMP STATUS (SHWPX-S) DOES NOT MATCH THE COMMAND (SHWPX-C), AN ALARM WILL BE GENERATED AND THE PUMP WILL BE STOPPED. UPON LOSS OF STATUS (SHWPX-S), THE PUMP (SHWPX-C) WILL RESTART AFTER THE SYSTEM RESET (SYS-RESET) IS MANUALLY ACTIVATED.

SETBACK:

PROVIDE NIGHT SETBACK TO MAINTAIN MINIMUM 55°F UNOCCUPIED ROOM SETPOINT. ROOM ZONE TEMPERATURE IS PROVIDED FROM A TYPICAL CLASSROOM ON THE JCI METASYS SYSTEM. START PRIMARY, SECONDARY PUMPS AND BOILER AS NEEDED FOR NIGHT SETBACK. ENABLE BOILER SYSTEM TO RUN ANY TIME AMBIENT TEMPERATURE IS BELOW 35°F (FOR FREEZE PROTECTION). JCI TO VERIFY EXISTING SEQUENCE OF OPERATIONS AND MODIFY SETBACK AS NEEDED BASED ON HOW EXISTING FAN COILS ARE CURRENTLY CONTROLLED. IF FAN COILS DO NOT USE NIGHT SETBACK, THE PROGRAMMING FUNCTION AT BOILER OPERATION FOR THIS FUNCTION MAY BE OMITTED. DESCRIBE SEQUENCES IN SUBMITTALS FOR ENGINEERS REVIEW.

ADDITIONAL POINTS MONITORED BY THE FMS:

BOILER N ALARM (BLRN-A)  
BOILER N LEAVING WATER TEMPERATURE (BLRNLW-T)  
SECONDARY SUPPLY TEMPERATURE (SHWS-T)  
SECONDARY RETURN TEMPERATURE (SHWR-T)  
OUTDOOR AIR TEMPERATURE (OA-T)

# BOILER SYSTEM CONTROL

NO SCALE




Sacramento  
City Unified  
School District

# Revisions				
No.	Revisions	By	Date	Appr.
1	Addendum #2		5/22/18	

<h2 style="margin: 0;">DSA Submittal</h2>
<p>ISSUE DATE: <u>4/17/2018</u> BY: <u>AA</u></p>

**DSA APPROVAL**

IDENTIFICATION STAMP  
DIVISION OF STATE ARCHITECT  
APPL. **02-116505**  
AC \_\_\_\_\_ FLS \_\_\_\_\_ SS \_\_\_\_\_  
DATE \_\_\_\_\_  
FILE NO. **67439-353**



## TURLEY & ASSOCIATES

2431 Capital Avenue  
Sacramento, CA 95816

**MECHANICAL  
ENGINEERING  
GROUP, INC.**

(916) 325-1065  
FAX: (916) 325-1075  
Email: [office@turleymech.com](mailto:office@turleymech.com)

Project Engineer:	JT	Job Number:	17312
Project Manager:	NS	Plot Date:	May 22, 2018 - 3:58pm
Project Drafter:	ZH	Logon:	NShan

This document is the property of the Owner and is not to be used without his written permission.

Architect/Engineer Of Record: \_\_\_\_\_



**HY** HIBSER YAMAUCHI  
Architects, Inc.

4602 2nd Street, Suite 3  
Davis, CA 95618  
530.758.1270 tel / 530.758.4789 fax

HY Architects Project number: 5077



Facility	HIRAM JOHNSON HIGH SCHOOL 6879 14th Ave, Sacramento, CA 95820
----------	--








# Project

## HVAC UPGRADE

Sheet Title

MECHANICAL CONTROLS

Client Project Number:		Client Proj. #
Scale:	As indicated	Sheet
Drawn By:	NS	
Checked By:	JT	
Issue Date:	4/17/18	
Revit Version:	2017	
		Sheet 1 of 200 

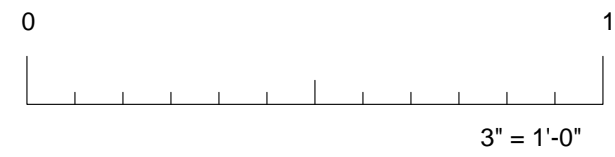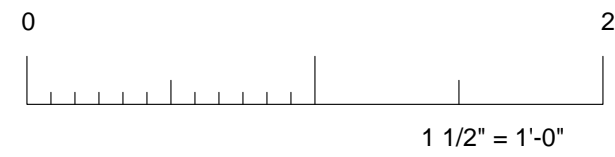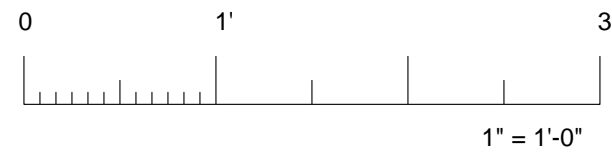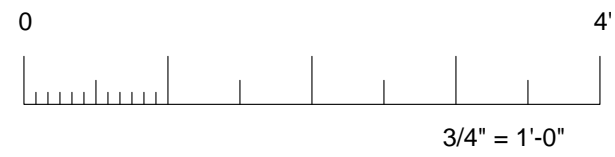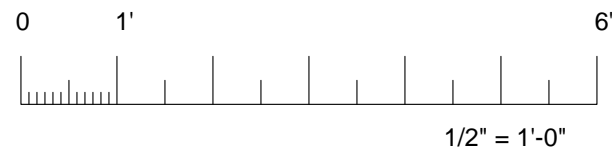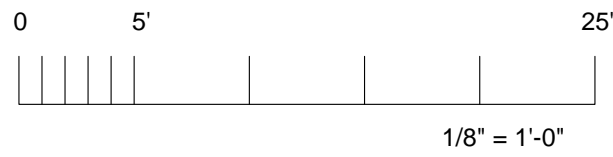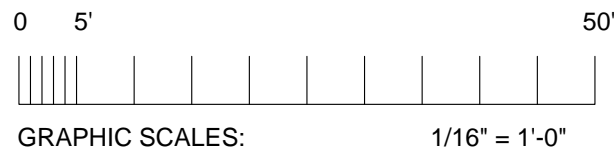

IF THIS SHEET IS NOT 30"x42", IT IS  
A REDUCED PRINT SCALE ACCORDINGLY

## MEP COMPONENT ANCHORAGE NOTES

ALL MECHANICAL, PLUMBING AND ELECTRICAL COMPONENTS SHALL BE ANCHORED AND INSTALLED PER THE DETAILS ON THE DSA APPROVED CONSTRUCTION DOCUMENTS. WHERE NO DETAIL IS INDICATED, THE FOLLOWING COMPONENTS SHALL BE ANCHORED OR BRACED TO MEET THE FORCE AND DISPLACEMENT REQUIREMENTS PRESCRIBED IN THE 2016 CBC, SECTIONS 1616A.1.18 THROUGH 1616A.1.26 AND ASCE 7-10 CHAPTERS 13, 26 AND 30.

- ALL PERMANENT EQUIPMENT AND COMPONENTS.
- TEMPORARY OR MOVEABLE EQUIPMENT THAT IS PERMANENTLY ATTACHED (E.G. HARD WIRED) TO THE BUILDING UTILITY SERVICES SUCH AS ELECTRICITY, GAS OR WATER.
- MOVEABLE EQUIPMENT WHICH IS STATIONED IN ONE PLACE FOR MORE THAN 8 HOURS AND HEAVIER THAN 400 POUNDS OR HAS A CENTER OF MASS LOCATED 4 FEET OR MORE ABOVE THE ADJACENT FLOOR OR ROOF LEVEL THAT DIRECTLY SUPPORT THE COMPONENT IS REQUIRED TO BE ANCHORED WITH TEMPORARY ATTACHMENTS.

THE FOLLOWING MECHANICAL AND ELECTRICAL COMPONENTS SHALL BE POSITIVELY ATTACHED TO THE STRUCTURE, BUT THE ATTACHMENT NEED NOT BE DETAILED ON THE PLANS. THESE COMPONENTS SHALL HAVE FLEXIBLE CONNECTIONS PROVIDED BETWEEN THE COMPONENT AND ASSOCIATED DUCTWORK, PIPING AND CONDUIT.

- COMPONENTS WEIGHING LESS THAN 400 POUNDS AND HAVING A CENTER OF MASS LOCATED 4 A. FEET OR LESS ABOVE THE ADJACENT FLOOR OR ROOF LEVEL THAT DIRECTLY SUPPORTS THE COMPONENT.
- COMPONENTS WEIGHING LESS THAN 20 POUNDS, OR IN THE CASE OF DISTRIBUTED SYSTEMS, LESS THAN 5 POUNDS PER FOOT, WHICH ARE SUSPENDED FROM A ROOF OR FLOOR OR HUNG FROM A WALL.

FOR THOSE ELEMENTS THAT DO NOT REQUIRE DETAILS ON THE APPROVED DRAWINGS, THE INSTALLATION SHALL BE SUBJECT TO THE APPROVAL OF THE DESIGN PROFESSIONAL IN GENERAL RESPONSIBLE CHARGE OR STRUCTURAL ENGINEER DELEGATED RESPONSIBILITY AND THE DSA DISTRICT STRUCTURAL ENGINEER. THE PROJECT INSPECTOR WILL VERIFY THAT ALL COMPONENTS AND EQUIPMENT HAVE BEEN ANCHORED IN ACCORDANCE WITH ABOVE REQUIREMENTS.

## PIPING, DUCTWORK AND ELECTRICAL DISTRIBUTION SYSTEM BRACING NOTE

PIPING, DUCTWORK AND ELECTRICAL DISTRIBUTION SYSTEMS SHALL BE BRACED TO COMPLY WITH THE FORCES AND DISPLACEMENTS PRESCRIBED IN ASCE 7-10 SECTION 13.3 AS DEFINED IN ASCE 7-10 SECTION 13.6.5.6, 13.6.7, 13.6.8, AND 2016 CBC, SECTIONS 1616A.1.24; 1616A.1.25 AND 1616A.1.26.

THE METHOD SHOWING BRACING AND ATTACHMENTS TO THE STRUCTURE FOR THE IDENTIFIED DISTRIBUTION SYSTEM ARE AS NOTED BELOW. WHEN BRACING AND ATTACHMENTS ARE BASED ON A PREAPPROVED INSTALLATION GUIDE (E.G. SMACNA OR OSHPD OPM), COPIES OF THE BRACING SYSTEM INSTALLATION GUIDE OR MANUAL SHALL BE AVAILABLE ON THE JOBSITE PRIOR TO THE START OF AD DURING THE HANGING AND BRACING OF THE DISTRIBUTION SYSTEMS. THE STRUCTURAL ENGINEER OF RECORD SHALL VERIFY THE ADEQUACY OF THE STRUCTURE TO SUPPORT THE HANGER AND BRACE LOADS.

MECHANICAL PIPING (MP), MECHANICAL DUCTS (MD), PLUMBING PIPING (PP), ELECTRICAL DISTRIBUTION SYSTEMS (E):

MP□ MD□ PP□ E□ OPTION 1: DETAILED ON THE APPROVED DRAWINGS WITH PROJECT SPECIFIC NOTES AND DETAILS.

MP□ MD□ PP□ E■ OPTION 2: SHALL COMPLY WITH THE APPLICABLE OSHPD PRE-APPROVAL (OPM #) #0052-13.

MP□ MD□ PP□ E□ OPTION 3: SHALL COMPLY WITH THE SMACNA SEISMIC RESTRAINT MANUAL, OSHPD EDITION (2009), INCLUDING ANY ADDENDA, FASTENERS AND OTHER ATTACHMENTS NOT SPECIFICALLY IDENTIFIED IN THE SMACNA SEISMIC RESTRAINT MANUAL. OSHPD EDITION, ARE DETAILED ON THE APPROVED DRAWINGS WITH PROJECT SPECIFIC NOTES AND DETAILS. THE DETAILS SHALL ACCOUNT FOR THE APPLICABLE SEISMIC HAZARD LEVEL AND CONNECTION LEVEL FOR THE PROJECT AND CONDITIONS.

## LUMINAIRE SCHEDULE

TAG	MANUFACTURER & CATALOG NUMBER	DESCRIPTION	LAMP TYPE	VOLTS	WATTS	REMARKS
<u>A1</u>	LITHONIA 2RTL4-48L-LP840	LAY-IN 2x4	LED	UNV	47	NOTE 1
<u>B1</u>	LITHONIA 2RTL2-33L-LP840	LAY-IN 2x2	LED	UNV	36	NOTE 1
<u>B2</u>	LITHONIA 2RTL2-40L-LP840	LAY-IN 2x2	LED	UNV	40	NOTE 1
<u>X</u>	LITHONIA LHQM-LED-BR-SD	CEILING MOUNTED EXIT SIGN WITH EMERGENCY HEADS	LED	UNV	4	

NOTES:  
1. INCLUDE IN BID ALL MATERIALS AND LABOR FOR AN ADDITIONAL (15) A1 FIXTURES, (10) B1 FIXTURES AND (10) B2 FIXTURES.

## GENERAL NOTES

- EXISTING UNDERGROUND UTILITIES ARE PRESENT, BUT THEIR EXACT LOCATIONS ARE NOT KNOWN. CONTRACTOR SHALL LOCATE AND PROTECT BEFORE TRENCHING OR EXCAVATING IN ANY AREA. CONSULT UTILITY COMPANIES, "AS-BUILT" DRAWINGS, AND SCHOOL MAINTENANCE PERSONNEL FOR LOCATION OF EXISTING UNDERGROUND WORK. IF EXISTING PIPING OR UTILITIES ARE DAMAGED DURING CONSTRUCTION, CONTRACTOR SHALL REPAIR IMMEDIATELY AT OWN EXPENSE. NEW UNDERGROUND SHALL BE MODIFIED AS NECESSARY TO CONFORM TO EXISTING CONDITIONS.
- INFORMATION GIVEN, CONCERNING EXISTING ELECTRICAL INSTALLATION IS AS EXACT AS COULD BE SECURED, BUT EXTREME ACCURACY IS NOT GUARANTEED. CONTRACTOR SHALL VISIT THE JOB SITE PRIOR TO BIDS AND SATISFY HIMSELF AS TO THE CONDITIONS UNDER WHICH THE WORK IS TO BE PERFORMED.
- EXISTING CIRCUITS AND SERVICES SHALL NOT BE INTERRUPTED EXCEPT BY SPECIFIC APPROVAL OF THE SCHOOL. ALL SHUTDOWNS SHALL BE SCHEDULED WITH THE SCHOOL.
- ALL INTERIOR CONDUIT SHALL BE RUN CONCEALED. FISH FLEX IN EXISTING WALLS AND USE CUT-IN BOXES, UNLESS NOT POSSIBLE. WHERE CONDUIT MUST RUN EXPOSED, PROVIDE WIREMOLD SURFACE NONMETALLIC RACEWAY, SIZE AS REQUIRED (800 SERIES MINIMUM SIZE). ROUTE AS INCONSPICUOUS AS POSSIBLE. MAKE ANGLES CUTS AS REQUIRED. ATTACH TO WALL WITH SCREWS SPACED 48" MAX. SCREWS MUST PENETRATE STRUCTURAL MEMBERS WITH 1" PENETRATION. COORDINATE ROUTING WITH ARCHITECT PRIOR TO INSTALLATION.
- CONTRACTOR SHALL VISIT SITE PRIOR TO BIDDING AND WALK ROUTES OF NEW UNDERGROUND CONDUITS. NOTE AREAS OF CONCRETE AND ASPHALT BEING CROSSED AND INCLUDE IN BID ALL COSTS FOR CUTTING AND PATCHING AS SHOWN ON DETAILS.
- PROVIDE TRAFFIC RATED (H/20 LOAD) COVER AND BOXES FOR ALL PULLBOXES UNLESS SPECIFICALLY NOTED OTHERWISE.
- REFER TO DETAILS ON STRUCTURAL DRAWINGS FOR PENETRATION REQUIREMENTS THROUGH FRAMING TOP PLATES, SILL PLATES, BEAMS, JOIST, RAFTERS, ETC. PROVIDE NOTCHING BORING, DRILLING, ANCHOR BOLTS AND OTHER WORK IN STRICTEST CONFORMANCE TO STRUCTURAL DETAILS.

## ELECTRICAL SYMBOLS

SYMBOL	DESCRIPTION
	RACEWAY INSTALLED IN CEILING OR WALL. ROUTE EXPOSED IN ALL UNFINISHED AREAS.
	RACEWAY INSTALLED BELOW FINISHED FLOOR OR GRADE.
	EXISTING CONDUIT RUN TO BE ABANDONED. CONDUIT ABOVE THE FLOOR AND BELOW THE STRUCTURE ABOVE SHALL BE REMOVED. CONDUCTORS SHALL BE REMOVED.
	EXISTING CONDUIT RUN, VERIFY ROUTING ON THE JOB.
	REMOVE (E) WIRE, PULL IN NEW WIRES, #12 AWG UNLESS NOTED.
	ARROW AT END OF RACEWAY INDICATES HOME RUN TO RESPECTIVE PANELBOARD OR SWITCHBOARD.
	BRANCH CIRCUIT WITHOUT FURTHER DESIGNATION INDICATES A 2 #12 AWG CIRCUIT WITH 1 #12 AWG GROUND.
	STRAIGHT CROSS-LINES IN BRANCH CIRCUIT RACEWAY INDICATE NUMBER OF #12 AWG WIRES IN A CIRCUIT. SHORT LINES INDICATE UNGROUNDED CONDUCTORS. LONG LINES INDICATE NEUTRAL CONDUCTORS. WIRES SHOWN ARE IN ADDITION TO 1 #12 AWG GROUNDING CONDUCTOR.
	BRANCH CIRCUIT WITH GROUNDING WIRE LARGER THAN #12 AWG. NUMBER ADJACENT TO CURVED CROSS-LINE INDICATES WIRE SIZE.
	BRANCH CIRCUIT RACEWAY WITH WIRE OTHER THAN #12 AWG. NUMBER ADJACENT TO STRAIGHT OR CURVED CROSS-LINES INDICATES WIRE SIZE. UNGROUNDED AND NEUTRAL CONDUCTORS SHALL BE THE SAME SIZE UNLESS OTHERWISE NOTED.
	FLEX CONDUIT OR METAL CLAD CABLE.
	INDICATES RACEWAY TURNING UP.
	INDICATES RACEWAY TURNING DOWN.
	INDICATES RACEWAY STUB, TERMINATE W/ BUSHING OR CAP IF UNDERGROUND.
	ASYMMETRIC INTERRUPTING CIRCUIT RATING.
	FEEDER TAG, SEE FEEDER SCHEDULE.
	EQUIPMENT DESIGNATION.
	NUMBERED NOTE.
	ENLARGED PLAN OR DETAIL CALL-OUT.
	UTILITY METER.
	CIRCUIT BREAKER.
	NON FUSED DISCONNECT SWITCH. NUMBER ADJACENT INDICATES AMPERE RATING OF SWITCH.
	FUSED DISCONNECT SWITCH WITH CLASS 'R' DUAL ELEMENT FUSES, SIZE TO SUIT EQUIPMENT NAME PLATE RATING. NUMBER ADJACENT INDICATES AMPERE RATING OF SWITCH.
	CONTROL/EQUIPMENT PROVIDED UNDER ANOTHER DIVISION. PROVIDE POWER CONNECTION(S) AS NOTED ON PLAN.
	MOTOR PROVIDED UNDER ANOTHER DIVISION, PROVIDE POWER CONNECTION AS NOTED ON PLANS.
	DISTRIBUTION PANEL/MOTOR CONTROL CENTER.
	BRANCH CIRCUIT PANELBOARD, SURFACE MOUNTED.
	TERMINAL CABINET, FLUSH MOUNTED, SIZE AND TYPE AS INDICATED.
	20 AMP 125V 3W DUPLEX CONVENIENCE RECEPTACLE W/ GROUND FAULT INTERRUPTER, MOUNTED +48" MAX AFF TO TOP OF BOX.
	JUNCTION BOX, SIZE AND TYPE AS INDICATED OR REQUIRED.
	SURFACE MOUNTED LUMINAIRE.
	RECESSED MOUNTED LUMINAIRE.
	CEILING OR WALL MOUNTED ILLUMINATED EXIT SIGN W/ DIRECTIONAL ARROWS NOTED ON PLANS. WORD 'EXIT' TO BE LOCATED IN SHADED FACE(S)
	LUMINAIRE TAG, LETTER INDICATES TYPE, SEE LUMINAIRE SCHEDULE.
	SINGLE POLE TOGGLE SWITCH, MOUNTED +48" MAX AFF TO TOP OF BOX.
	AUTOMATIC "ON", CEILING MOUNTED DUAL TECHNOLOGY OCCUPANCY SENSOR. PROVIDE WIRING PER DIAGRAM. ACUITY nVV PDT 16 WITH CEILING MOUNT BRACKET
	LIGHTING ROOM CONTROLLER ATTACHED TO JUNCTION BOX ABOVE CEILING, 1 RELAY ROOM CONTROLLER W/ 0-10V DIMMING. ACUITY nPP16D
	DIMMING CONTROL, WALL MOUNTED +48" MAX AFF TO TOP OF BOX. PROVIDE 1" C STUBBED ABOVE CEILING WITH WIRING PER DIAGRAM. ACUITY nPOM DX

## ABBREVIATIONS

1PH, 3PH 1P, 2P, 3P 3W, 4W (D) (E) (ER) (N) (R)	1 PHASE, 3 PHASE 1 POLE, 2 POLE, 3 POLE 3 WIRE, 4 WIRE DEMO, DEMOLISH EXISTING ONLY EXISTING RELOCATED NEW RELOCATE	MCA MCB MCC MLO MOCP MT	-M- MINIMUM CIRCUIT AMPACITY MAIN CIRCUIT BREAKER MOTOR CONTROL CENTER MAIN LUGS ONLY MAXIMUM OVER-CURRENT PROTECTION EMPTY CONDUIT W/ PULL-LINE
A, AMPS AC AF AFF AIC	AMPERES ALTERNATING CURRENT FRAME RATING IN AMPERES ABOVE FINISHED FLOOR AMPERES INTERRUPTING CAPACITY	NC NCTC NEC NEMA	-N- NORMALLY CLOSED NURSE CALL TERMINAL CABINET NATIONAL ELECTRIC CODE NATIONAL ELECTRICAL MANUFACTURER ASSOCIATION NOT INCLUDED IN ELECTRICAL SCOPE
AL, ALUM ATS AT AWG	ALUMINUM AUTO TRANSFER SWITCH TRIP RATING IN AMPERES AMERICAN WIRE GAUGE	NL NO NTS	NL NIGHT LIGHT NORMALLY OPEN NOT TO SCALE
BTR	BUILDING TELECOM ROOM	OCF OFCL	-O- OVER-CURRENT PROTECTION OWNER FURNISHED CONTRACTOR INSTALLED OWNER FURNISHED OWNER INSTALLED
CB, C/B CEC CT CU	CONDUIT CIRCUIT BREAKER CALIFORNIA ELECTRICAL CODE CURRENT TRANSFORMER COPPER	PT PVC	-P- POTENTIAL TRANSFORMER POLYVINYL CHLORIDE CONDUIT
DC	DIRECT CURRENT	RLA RSC	-R- RUNNING LOAD AMP RIGID STEEL CONDUIT
EA ELEC EMT	EACH ELECTRICAL ELECTRICAL METALLIC TUBING	SPD SPDT SPST SST	-S- SURGE PROTECTION DEVICE SINGLE POLE DOUBLE THROW SINGLE POLE SINGLE THROW SOLID STATE TRIP
FA FACP FATC FLA FT	FIRE ALARM FIRE ALARM CONTROL PANEL FIRE ALARM TERMINAL CABINET FULL LOAD AMPS FOOT OR FEET	TER TR TM TTB	-T- TELECOM EQUIPMENT ROOM TELECOM ROOM THERMAL MAGNETIC TERMINAL BACKBOARD
G, GND GA GFCI	GROUND GAUGE GROUND FAULT CIRCUIT INTERRUPTER GROUND FAULT INTERRUPTER	UG UL UON UPS	-U- UNDERGROUND UNDERWRITERS LAB. UNLESS OTHERWISE NOTED UNINTERRUPTIBLE POWER SUPPLY
HOA HP	HAND-OFF-AUTO HORSE POWER	V VA VAC	-V- VOLTS VOLT-AMPS VOLTS ALTERNATE CURRENT
J-BOX	JUNCTION BOX	W WP	-W- WATTS WEATHERPROOF
KVA KW	ONE THOUSAND VOLT-AMPS ONE THOUSAND WATTS	XFMR XFER	-X- TRANSFORMER TRANSFER SWITCH
LCP LTG	LIGHTING CONTROL PANEL LIGHTING		

## SHEET INDEX

SHEET	DESCRIPTION
E0.01	ELECTRICAL COVER SHEET
E1.01	SITE PLAN - ELECTRICAL
E1.02	PARTIAL SITE PLAN - ELECTRICAL
E1.11	ONE LINE DIAGRAM
E1.21	PANEL SCHEDULES
E2.01	ELECTRICAL DEMO PLANS WEST WING
E2.02	ELECTRICAL DEMO PLANS EAST WING
E2.03	ELECTRICAL DEMO PLAN LITTLE THEATER
E2.04	LIGHTING DEMO PLANS WEST WING
E2.05	LIGHTING DEMO PLANS EAST WING
E2.11	ELECTRICAL ROOF PLANS WEST WING
E2.12	ELECTRICAL ROOF PLANS EAST WING
E2.13	ELECTRICAL ROOF PLAN LITTLE THEATER
E2.21	ELECTRICAL FLOOR PLANS TOILET ROOMS
E2.22	LIGHTING PLANS WEST WING
E2.23	LIGHTING PLANS EAST WING
E3.01	FIRE ALARM COVER SHEET
E3.11	FIRE ALARM SITE PLAN
E3.21	FIRE ALARM PLANS WEST WING
E3.22	FIRE ALARM PLANS EAST WING
E3.23	FIRE ALARM PLAN LITTLE THEATER
E3.31	FIRE ALARM FLOOR PLANS TOILET ROOMS
E3.41	FIRE ALARM CALCULATIONS
E4.01	ELECTRICAL DETAILS
E4.02	ELECTRICAL DETAILS



# Revisions			
No.	Revisions	By	Date   Appr.
1	Addendum #2		5/22/18

## BACKCHECK SET

ISSUE DATE: 4/17/18 BY: AA

## DSA APPROVAL

IDENTIFICATION STAMP  
DIVISION OF STATE ARCHITECT  
APPL. 02-116505  
AC FLS SS  
DATE  
FILE NO. 67439-353

## EDGE ELECTRICAL CONSULTING

431 30th Street  
Sacramento, CA 95816  
916.256.2480

300 27th Street #201  
Oakland, CA 94612  
510.775.3896


Project Number: E373 Contact: CHRIS

This document is the property of the Owner and is not to be used without the written permission of the Architect/Engineer Of Record.

Architect/Engineer Of Record:



05/22/2018

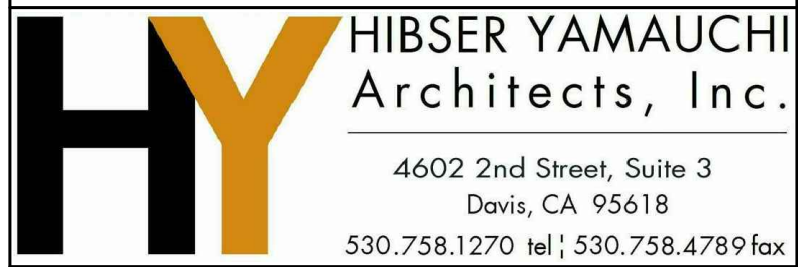

4602 2nd Street, Suite 3  
Davis, CA 95618  
530.758.1270 tel | 530.758.4789 fax

HY Architects Project number: 5077

Facility  
HIRAM JOHNSON HIGH SCHOOL  
6879 14th Ave, Sacramento, CA 95820

Project  
HVAC UPGRADE

Sheet Title  
ELECTRICAL COVER SHEET


Client Project Number: Client Proj. #

Scale: As indicated  
Drawn By: Chris  
Checked By: Donny  
Issue Date: 4/17/18  
Revit Version: 2017

# E0.01



IF THIS SHEET IS NOT 30"x42", IT IS  
A REDUCED PRINT SCALE ACCORDINGLY

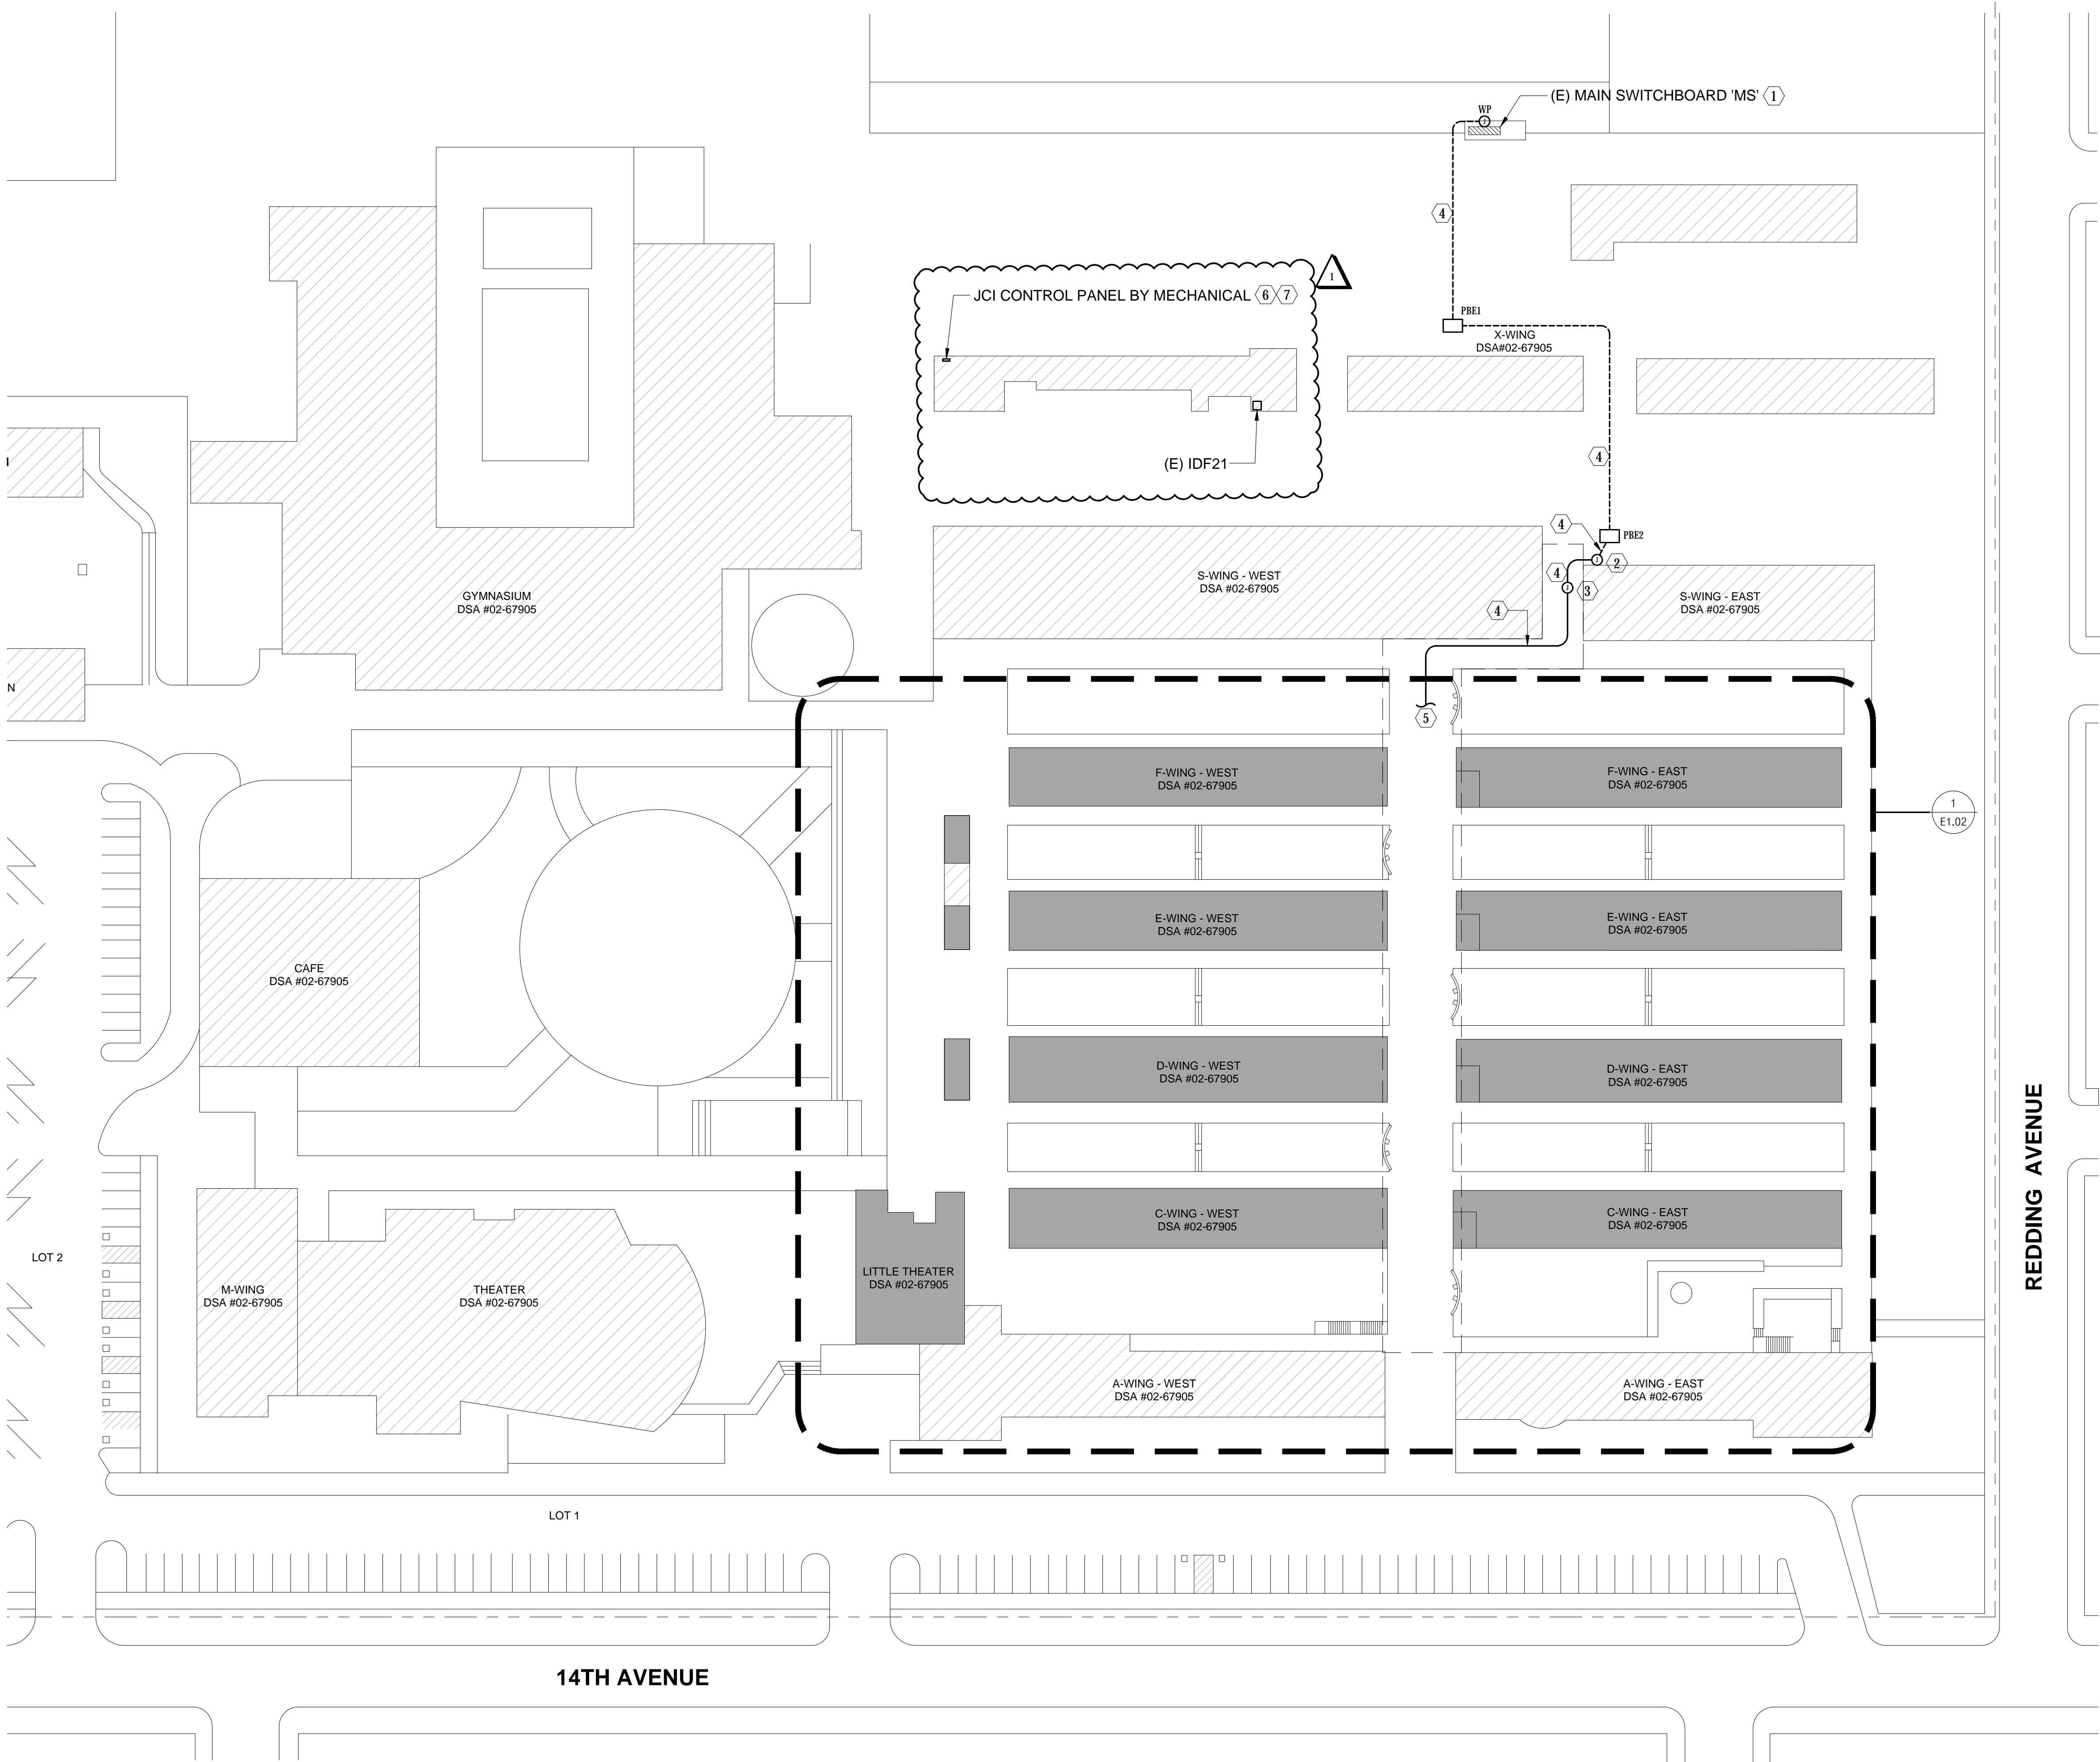

1 SITE PLAN - ELECTRICAL  
SCALE: 1" = 40'-0"



## GENERAL NOTES

1. FOR ROOF MOUNTED CONDUITS REFER TO DETAIL 6/A9.11.

## NUMBERED NOTES

- 1 PROVIDE (N) BREAKERS AS INDICATED ON THE ONE LINE DIAGRAM.
- 2 RISE CONDUITS ON BUILDING EXTERIOR UP TO A NEMA 3R BOX. THEN RUN CONDUITS ON ROOF.
- 3 NEMA 4X BOX ON ROOF.
- 4 REFER TO ONE LINE DIAGRAM FOR CONDUIT & CONDUCTOR QUANTITIES AND SIZES.
- 5 SEE SHEET E1.02 FOR CONTINUATION.
- 6 EXTEND (E) 120V CIRCUIT FROM (E) CONTROL PANEL AND CONNECT TO (N) CONTROL PANEL.
- 7 PROVIDE 1"C WITH (1) CAT6 CABLE TO THE (E) IDF.
- 8 CONNECT (N) CAT6 CABLE AS REQUIRED. PROVIDE (N) PATCH PANEL IF REQUIRED. COORDINATE REQUIREMENTS WITH OWNER.



Revisions			
No.	Revisions	By	Date
1	Addendum #2		5/22/18

## BACKCHECK SET


ISSUE DATE: 4/17/18 BY: AA

## DSA APPROVAL

IDENTIFICATION STAMP  
DIVISION OF STATE ARCHITECT  
APPL 02-116505  
AC FLS SS  
DATE  
FILE NO. 67439-353

**EDGE**  
ELECTRICAL CONSULTING  
431 30th Street  
Sacramento, CA 95816  
916.256.2460  
300 27th Street #201  
Oakland, CA 94612  
510.775.3836  
Project Number E373 Contact CHRIS

This document is the property of the Owner and is not to be used without his written permission.  
Architect/Engineer Of Record:

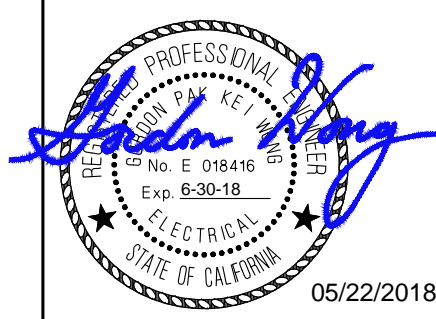

**HY** HIBSER YAMAUCHI  
Architects, Inc.  
4602 2nd Street, Suite 3  
Davis, CA 95618  
530.758.1270 tel | 530.758.4789 fax

HY Architects Project number: 5077

Facility  
HIRAM JOHNSON HIGH SCHOOL  
6879 14th Ave, Sacramento, CA 95820

Project  
HVAC UPGRADE

Sheet Title  
SITE PLAN - ELECTRICAL

Client Project Number:	Client Proj. #
Scale: As indicated	Sheet
Drawn By: Chris	<b>E1.01</b>
Checked By: Donny	
Issue Date: 4/17/18	
Revit Version: 2017	



IF THIS SHEET IS NOT 30"x42", IT IS  
A REDUCED PRINT SCALE ACCORDINGLY



Revisions				
No.	Revisions	By	Date	Appr.
1	Addendum #2		5/22/18	

## SHEET NOTES

1. CONTRACTOR SHALL VISIT THE SITE TO DETERMINE THE EXTENT SCOPE OF DEMOLITION WORK REQUIRED.
2. DURING THE CEILING DEMOLITION AND NEW INSTALLATION, (E) WIRING SHALL BE PROTECTED OR REMOVED AND REINSTALLED. FIELD VERIFY REQUIREMENTS.
3. WHERE ITEMS ARE REMOVED, MAKE ANY RECONNECTIONS REQUIRED TO MAINTAIN CIRCUITS TO (E) DEVICES THAT ARE TO REMAIN.

## NUMBERED NOTES

1. DISCONNECT EQUIPMENT THAT IS BEING REMOVED. REMOVE (E) WIRING BACK TO SOURCE. ABANDON CONCEALED CONDUIT, REMOVE CONDUIT THAT IS EXPOSED OR BECOMES EXPOSED DURING CONSTRUCTION. TYPICAL, UON.
2. REMOVE (E) WIRING AND PROTECT CONDUIT FOR REUSE.
3. DISCONNECT (E) RELIEF DAMPER. REMOVE (E) WIRING BACK TO ASSOCIATED UNIT VENTILATOR. ABANDON CONCEALED CONDUIT, REMOVE CONDUIT THAT IS EXPOSED OR BECOMES EXPOSED DURING CONSTRUCTION. TYPICAL, UON.
4. REMOVE (E) FA DETECTOR. REMOVE ASSOCIATED CONDUIT AND WIRE.
5. (E) WIREMOLD RACEWAY(S) ON CEILING. REMOVE RACEWAY AND PROTECT WIRING. AFTER NEW CEILING IS IN PLACE, REINSTALL (E) WIRING IN (N) WIREMOLD RACEWAY(S).
6. REMOVE (E) FA HORN/STROBE. REMOVE EXPOSED BOX AND RACEWAY.

## BACKCHECK SET

ISSUE DATE: 4/17/18 BY: AA

## DSA APPROVAL

IDENTIFICATION STAMP  
DIVISION OF STATE ARCHITECT  
APPL. 02-116505  
AC FLS SS  
DATE  
FILE NO. 67439-353

## EDGE

ELECTRICAL CONSULTING


431 30th Street  
Sacramento, CA 95816  
916.256.2460

300 27th Street #201  
Oakland, CA 94612  
510.775.3856

Project Number E373 Contact CHRIS

This document is the property of the Owner and is not to be used without his written permission.

Architect/Engineer Of Record:

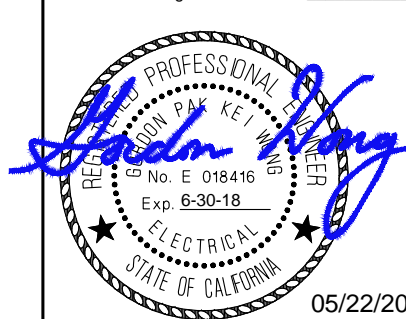

05/22/2018

**HY** HIBSER YAMAUCHI  
Architects, Inc.  
4602 2nd Street, Suite 3  
Davis, CA 95618  
530.758.1270 tel | 530.758.4789 fax

HY Architects Project number: 5077

Facility  
HIRAM JOHNSON HIGH SCHOOL  
6879 14th Ave, Sacramento, CA 95820

Project  
HVAC UPGRADE

Sheet Title  
ELECTRICAL DEMO PLANS  
WEST WING

Client Project Number: Client Proj. #

Scale: As indicated


Drawn By: Chris

Checked By: Donny

Issue Date: 4/17/18


Revit Version: 2017

E2.01

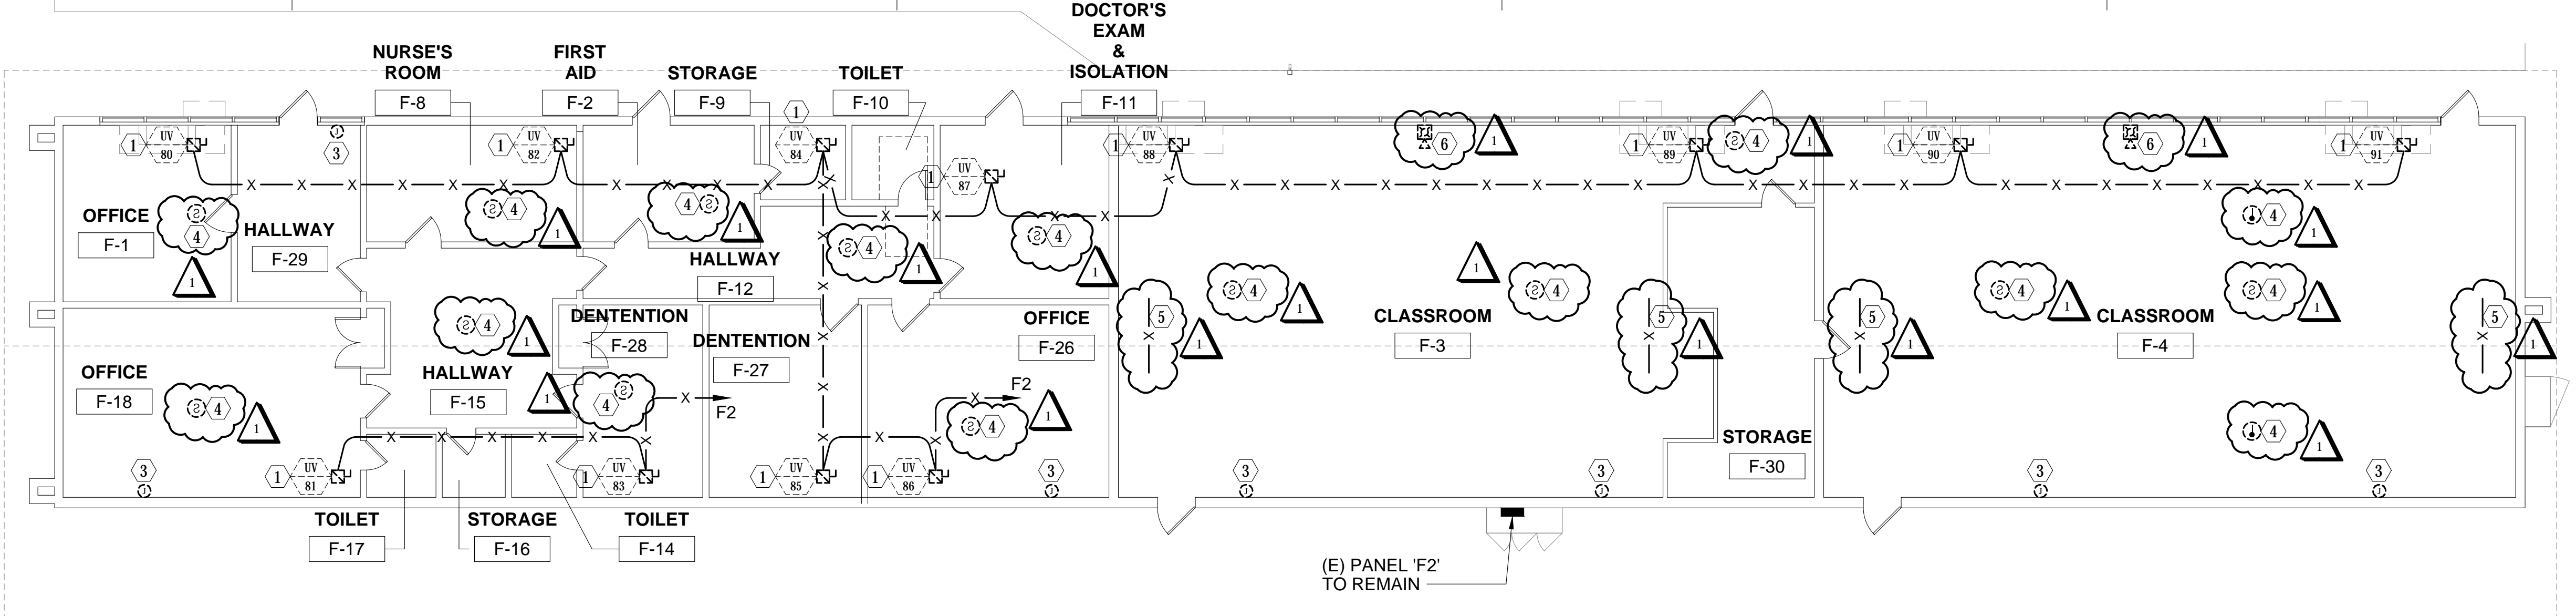


BUILDING F - WEST WING - DEMO ELECTRICAL FLOOR PLAN

SCALE: 1/8" = 1'-0"

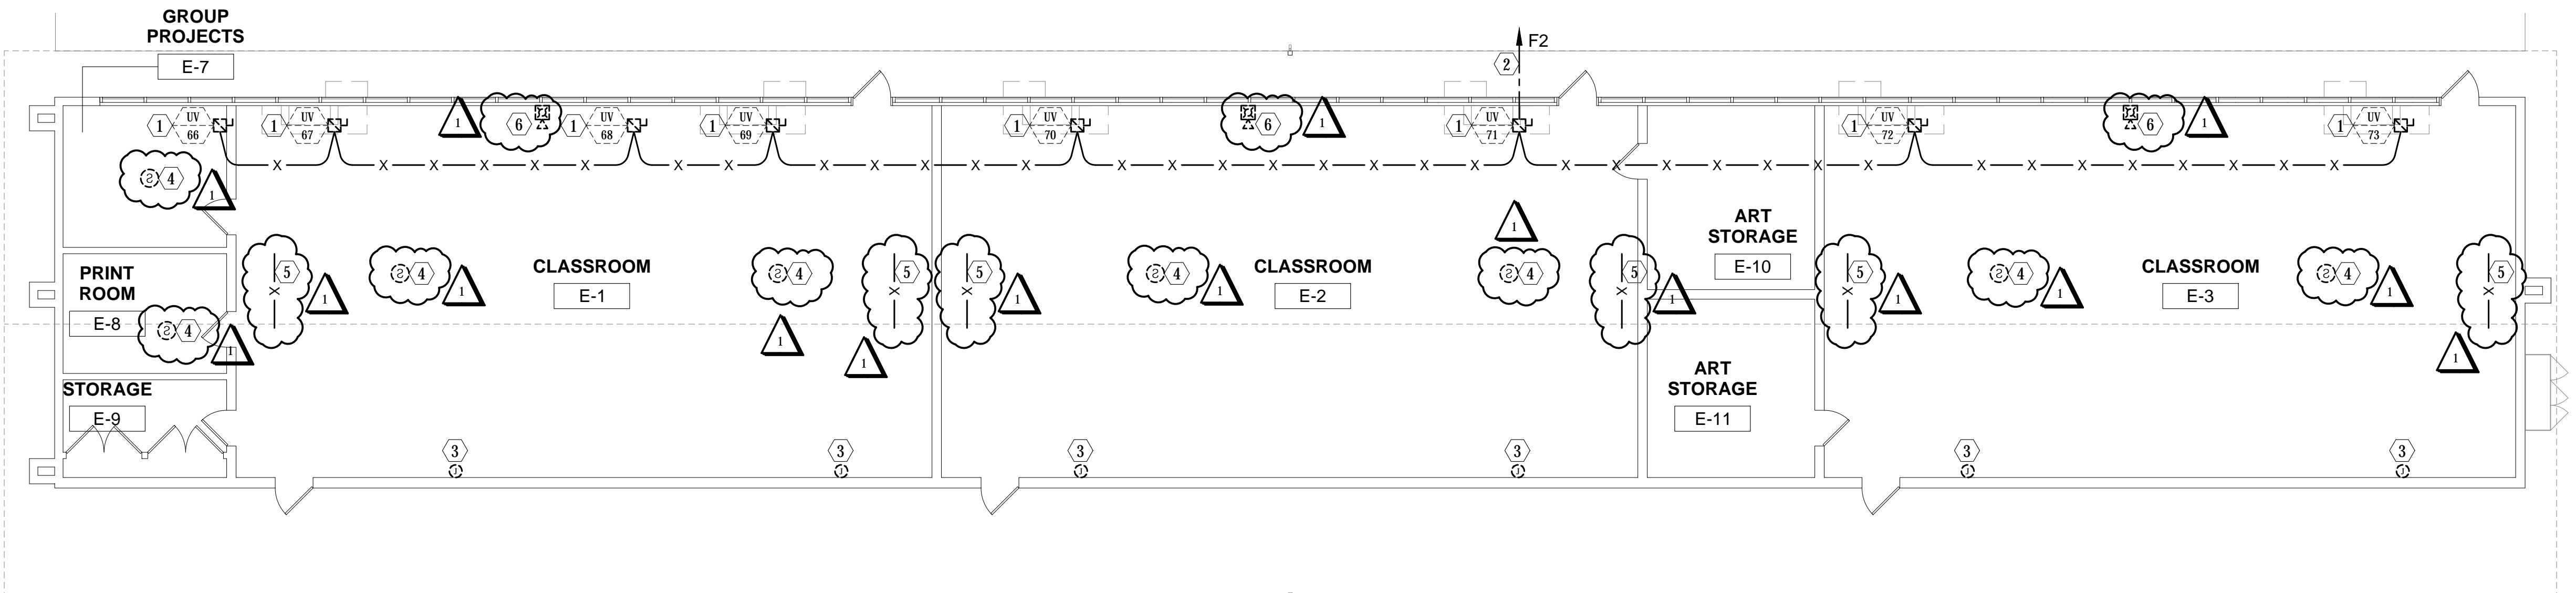


BUILDING E - WEST WING - DEMO ELECTRICAL FLOOR PLAN

SCALE: 1/8" = 1'-0"

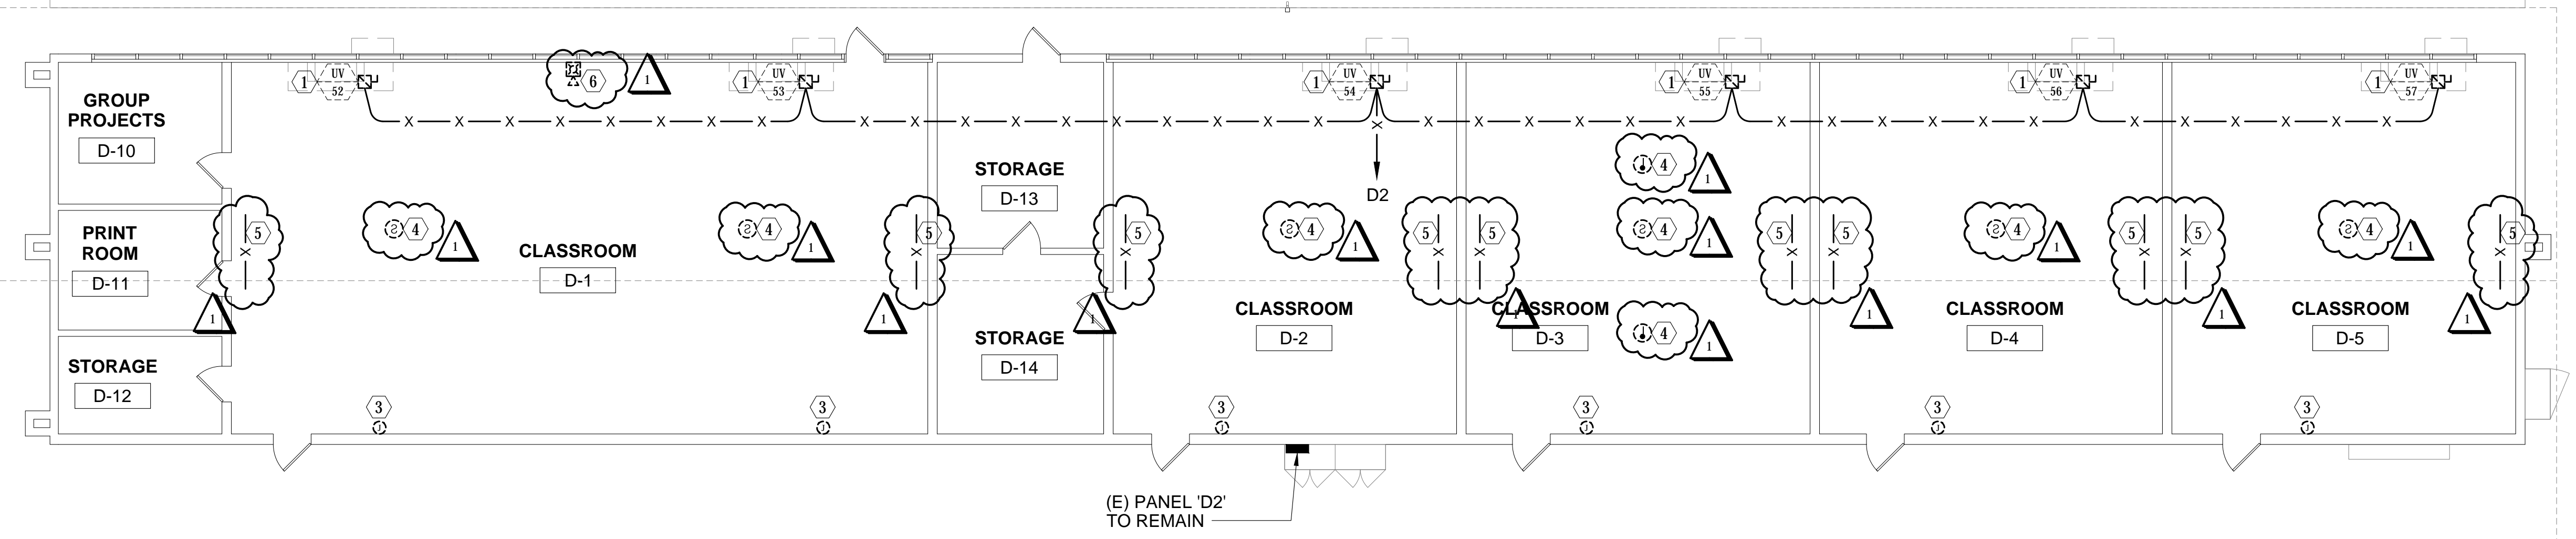

BUILDING D - WEST WING - DEMO ELECTRICAL FLOOR PLAN

SCALE: 1/8" = 1'-0"




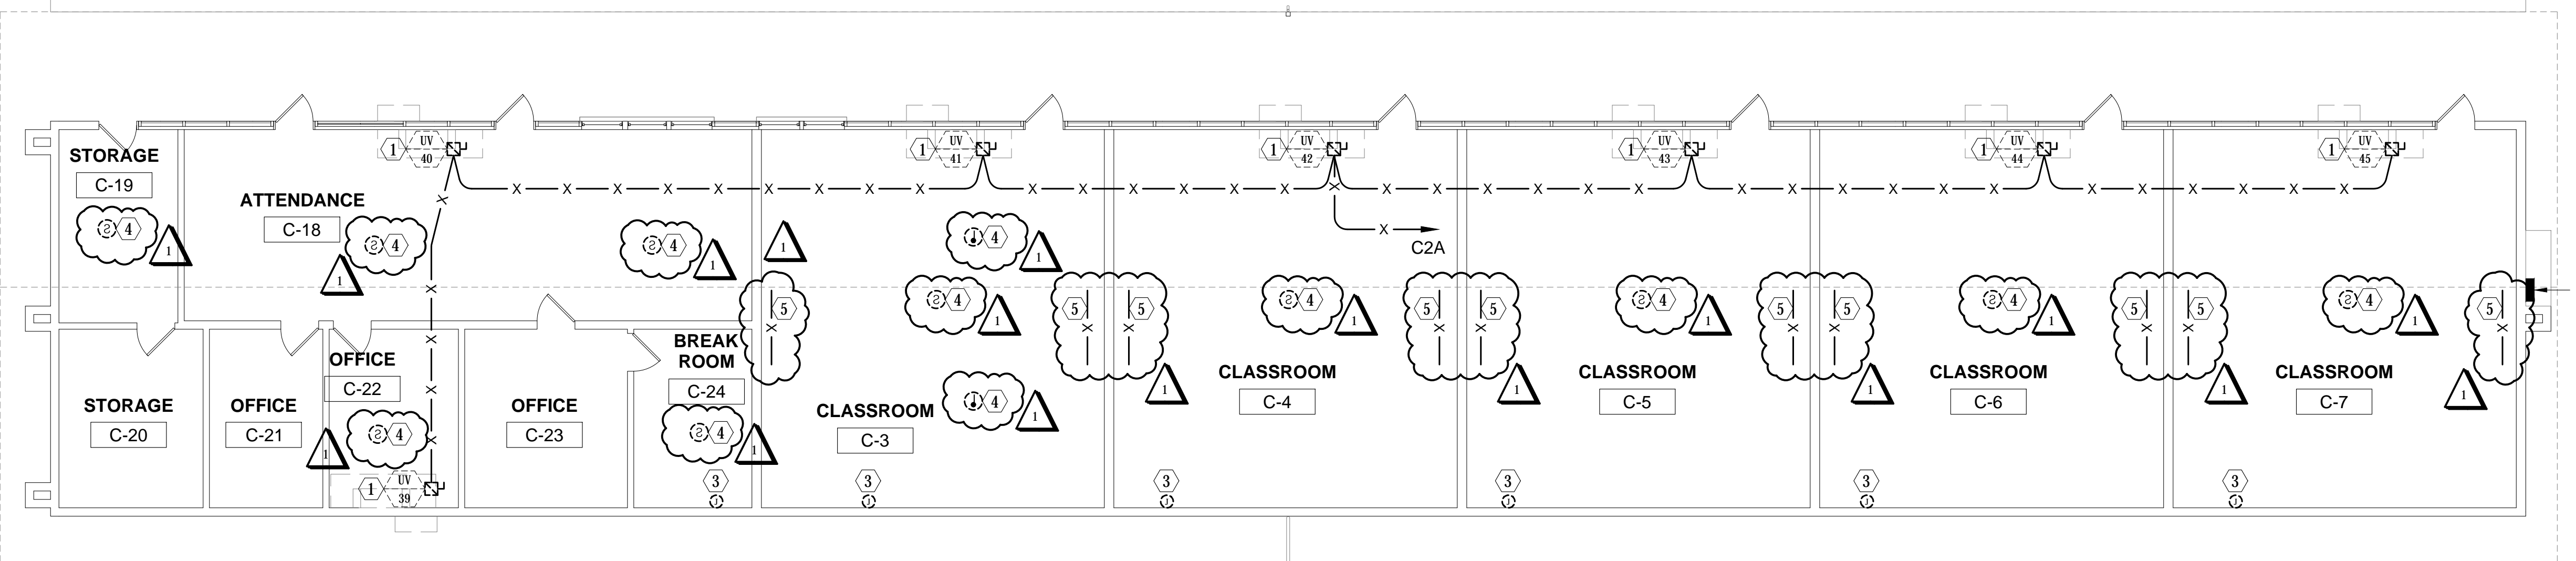


BUILDING C - WEST WING - DEMO ELECTRICAL FLOOR PLAN

SCALE: 1/8" = 1'-0"



IF THIS SHEET IS NOT 30"x42", IT IS  
A REDUCED PRINT SCALE ACCORDINGLY

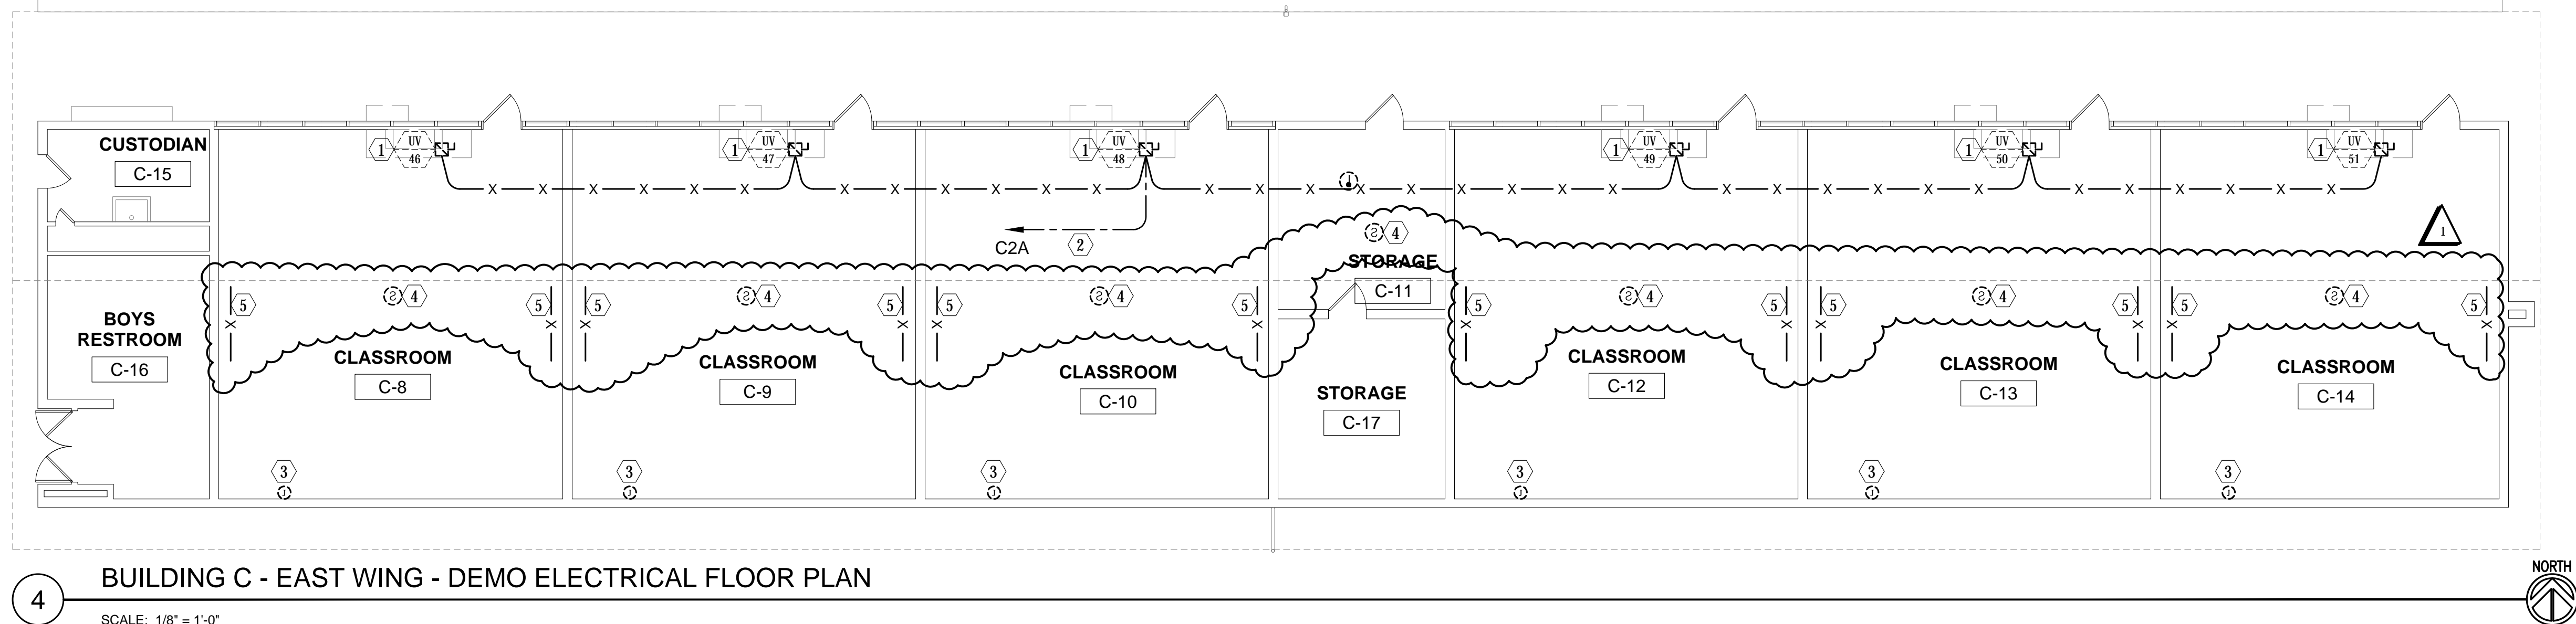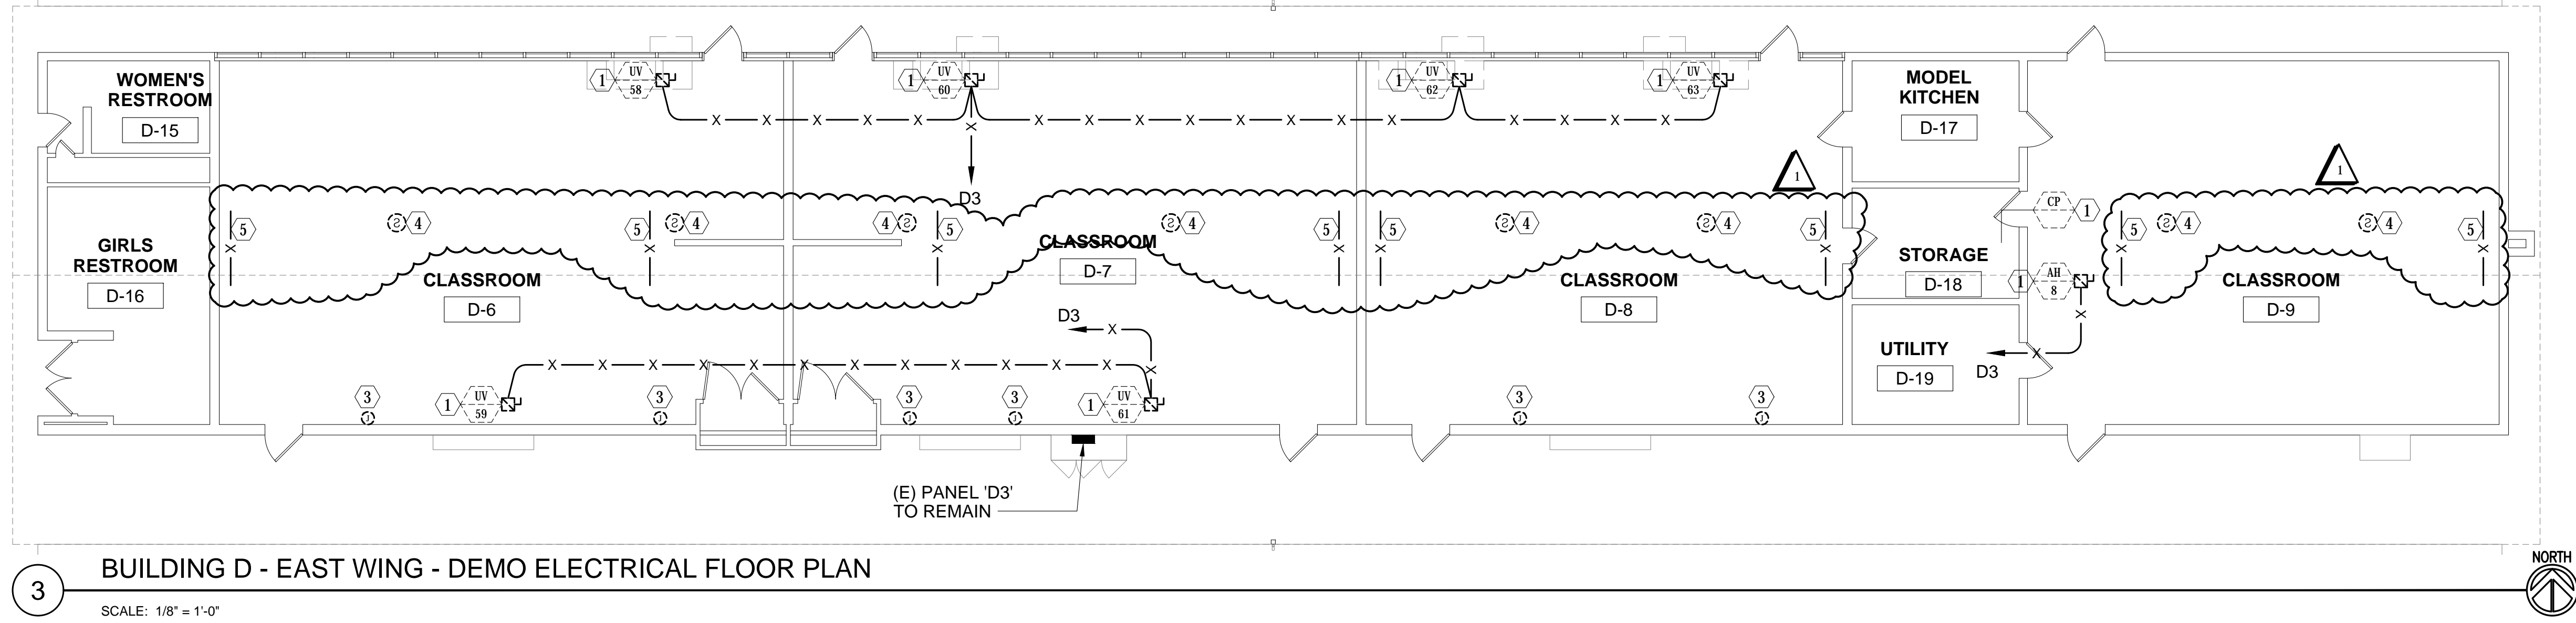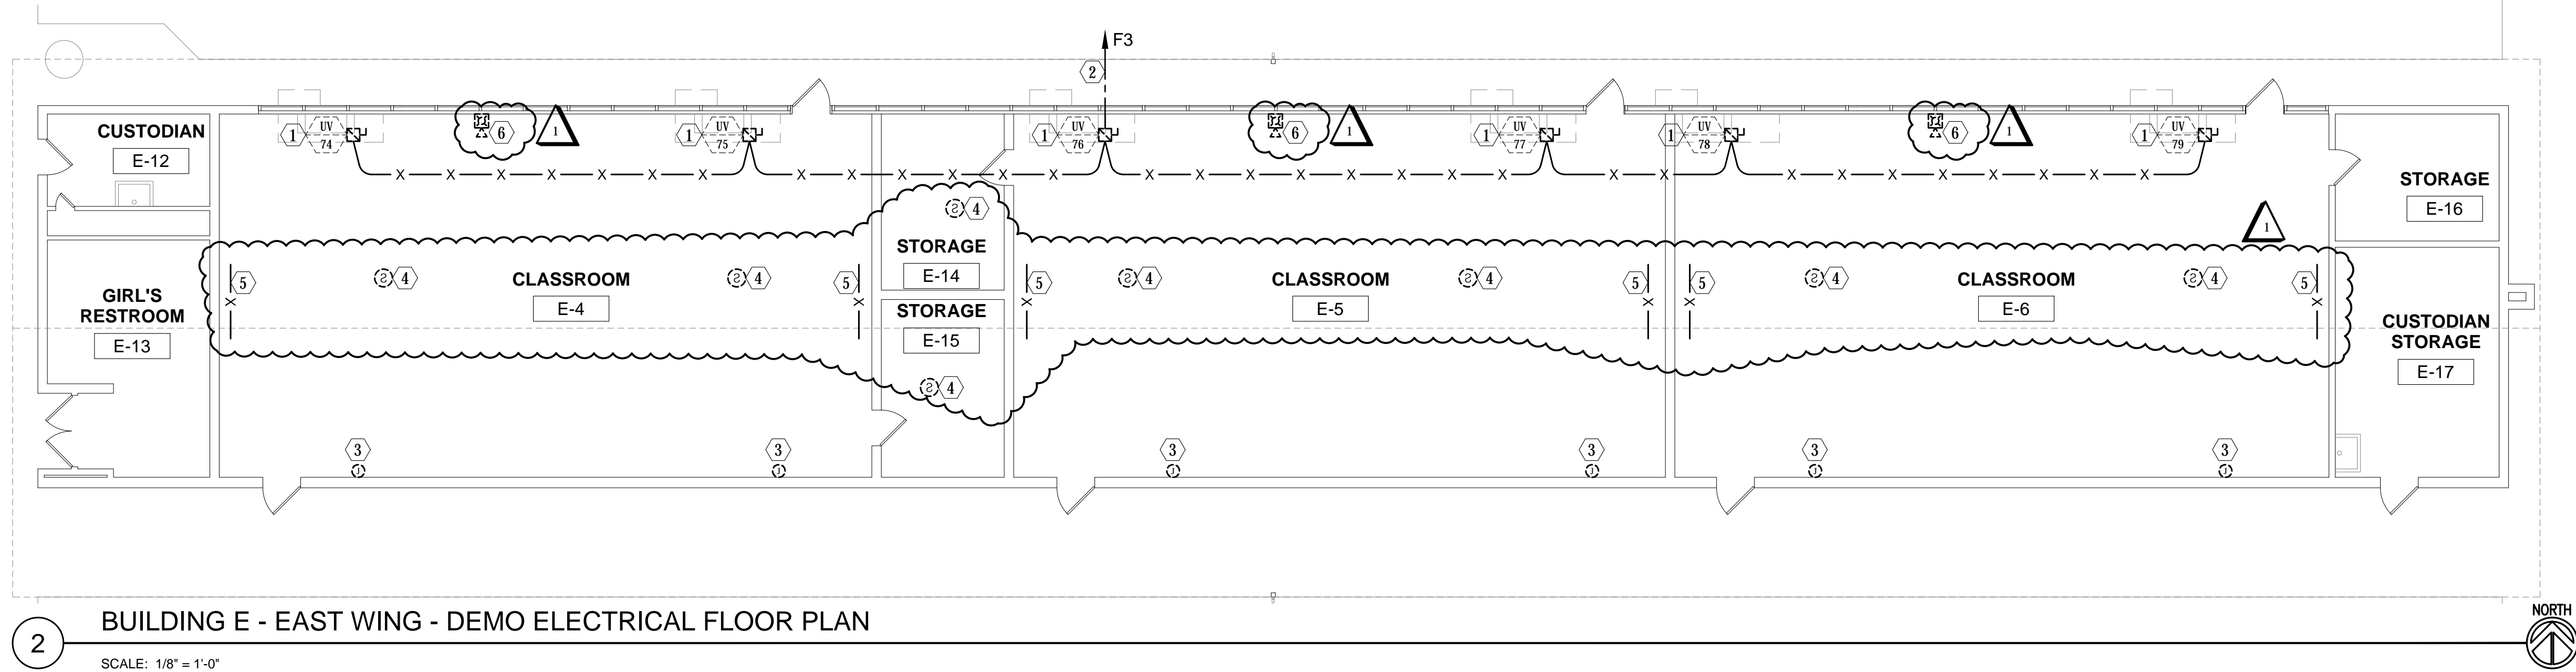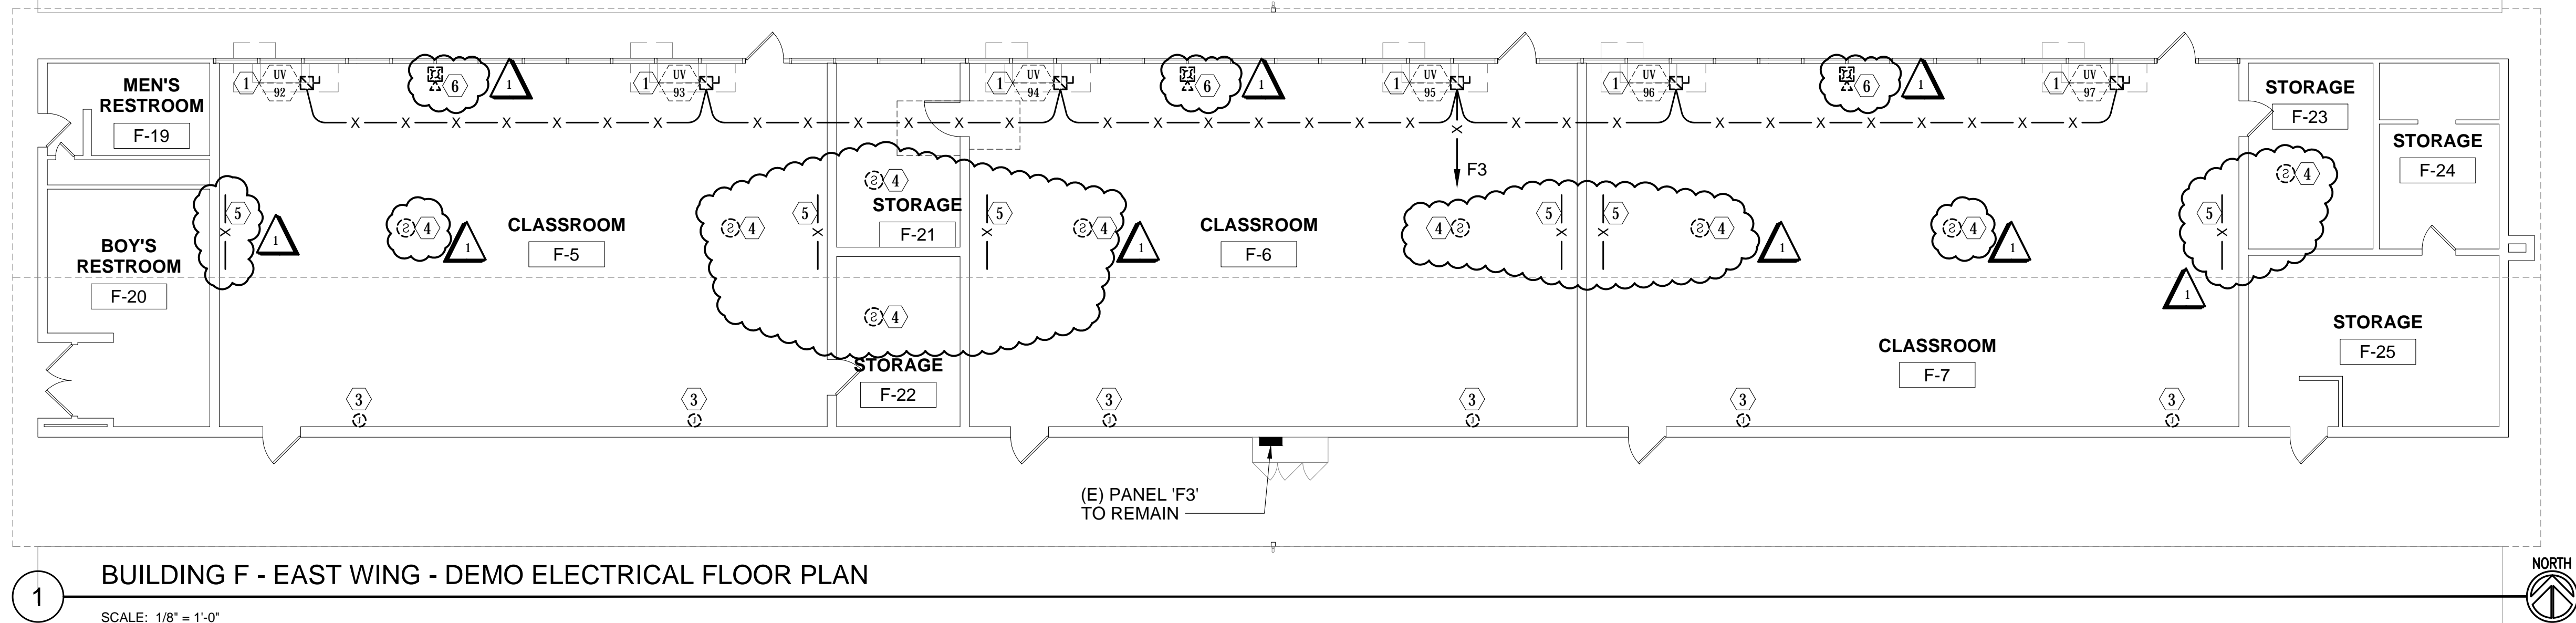

## SHEET NOTES

1. CONTRACTOR SHALL VISIT THE SITE TO DETERMINE THE EXTENT SCOPE OF DEMOLITION WORK REQUIRED.
2. DURING THE CEILING DEMOLITION AND NEW INSTALLATION, (E) WIRING SHALL BE PROTECTED OR REMOVED AND REINSTALLED. FIELD VERIFY REQUIREMENTS.
3. WHERE ITEMS ARE REMOVED, MAKE ANY RECONNECTIONS REQUIRED TO MAINTAIN CIRCUITS TO (E) DEVICES THAT ARE TO REMAIN.

## NUMBERED NOTES

1. DISCONNECT EQUIPMENT THAT IS BEING REMOVED. REMOVE (E) WIRING BACK TO SOURCE. ABANDON CONCEALED CONDUIT. REMOVE CONDUIT THAT IS EXPOSED OR BECOMES EXPOSED DURING CONSTRUCTION. TYPICAL, UON.
2. REMOVE (E) WIRING AND PROTECT CONDUIT FOR REUSE.
3. DISCONNECT (E) RELIEF DAMPER. REMOVE (E) WIRING BACK TO ASSOCIATED UNIT VENTILATOR. ABANDON CONCEALED CONDUIT. REMOVE CONDUIT THAT IS EXPOSED OR BECOMES EXPOSED DURING CONSTRUCTION. TYPICAL, UON.
4. REMOVE (E) FA DETECTOR. REMOVE ASSOCIATED CONDUIT AND WIRE.
5. (E) WIREMOLD RACEWAY(S) ON CEILING. REMOVE RACEWAY AND PROTECT WIRING. AFTER NEW CEILING IS IN PLACE, REINSTALL (E) WIRING IN (N) WIREMOLD RACEWAY(S).
6. REMOVE (E) FA HORN/STROBE. REMOVE EXPOSED BOX AND RACEWAY.



# Revisions				
No.	Revisions	By	Date	Appr.
1	Addendum #2		5/22/18	

## BACKCHECK SET

ISSUE DATE: 4/17/18 BY: AA

## DSA APPROVAL

IDENTIFICATION STAMP  
DIVISION OF STATE ARCHITECT  
APPL 02-116505  
AC FLS SS  
DATE  
FILE NO. 67439-353

## EDGE


ELECTRICAL CONSULTING

431 30th Street  
Sacramento, CA 95816  
916.256.2460  
Project Number E373 Contact CHRIS

300 27th Street #201  
Oakland, CA 94612  
510.775.3856

This document is the property of the Owner and is not to be used without his written permission.

Architect/Engineer Of Record:

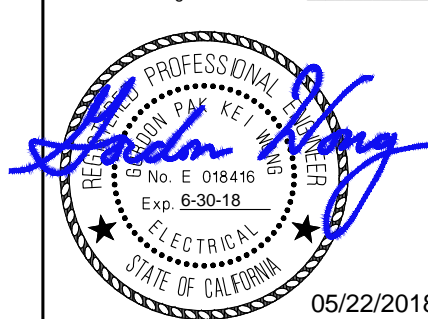

05/22/2018

**HY** HIBSER YAMAUCHI  
Architects, Inc.  
4602 2nd Street, Suite 3  
Davis, CA 95618  
530.758.1270 tel | 530.758.4789 fax  
HY Architects Project number: 5077

Facility  
HIRAM JOHNSON HIGH SCHOOL  
6879 14th Ave, Sacramento, CA 95820


Project  
HVAC UPGRADE

Sheet Title  
ELECTRICAL DEMO PLANS  
EAST WING

Client Project Number: Client Proj. #

Scale: As indicated  
Drawn By: Chris  
Checked By: Donny  
Issue Date: 4/17/18  
Revit Version: 2017

E2.02

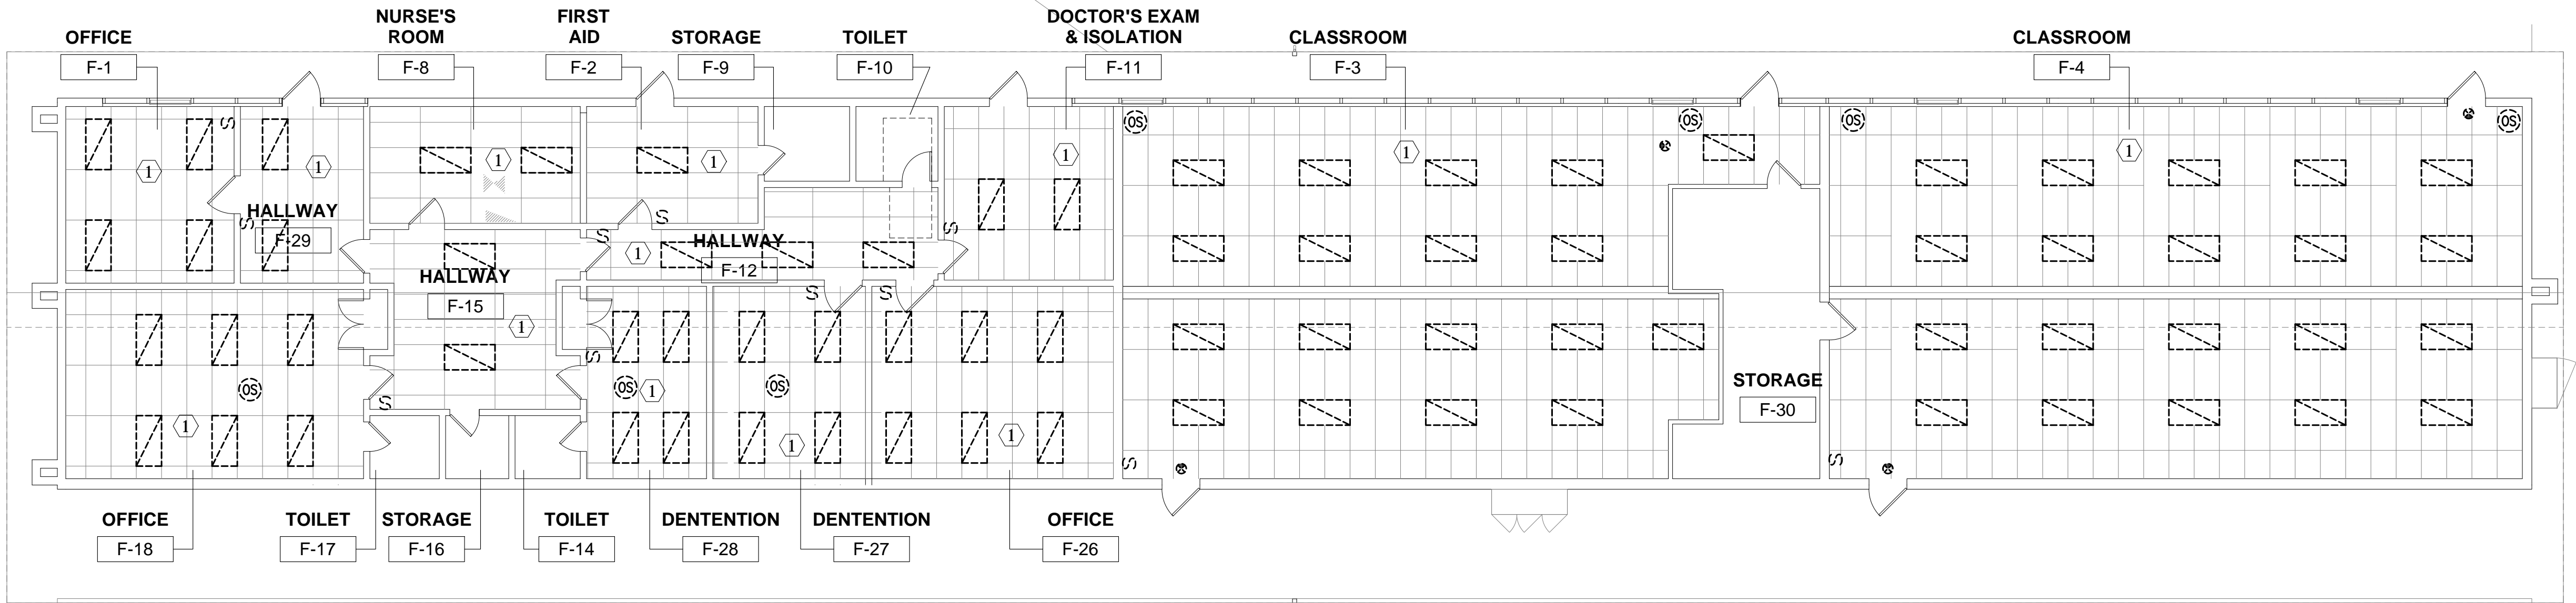


1

BUILDING F - WEST WING - LIGHTING DEMO FLOOR PLAN

SCALE: 1/8" = 1'-0"

NORTH

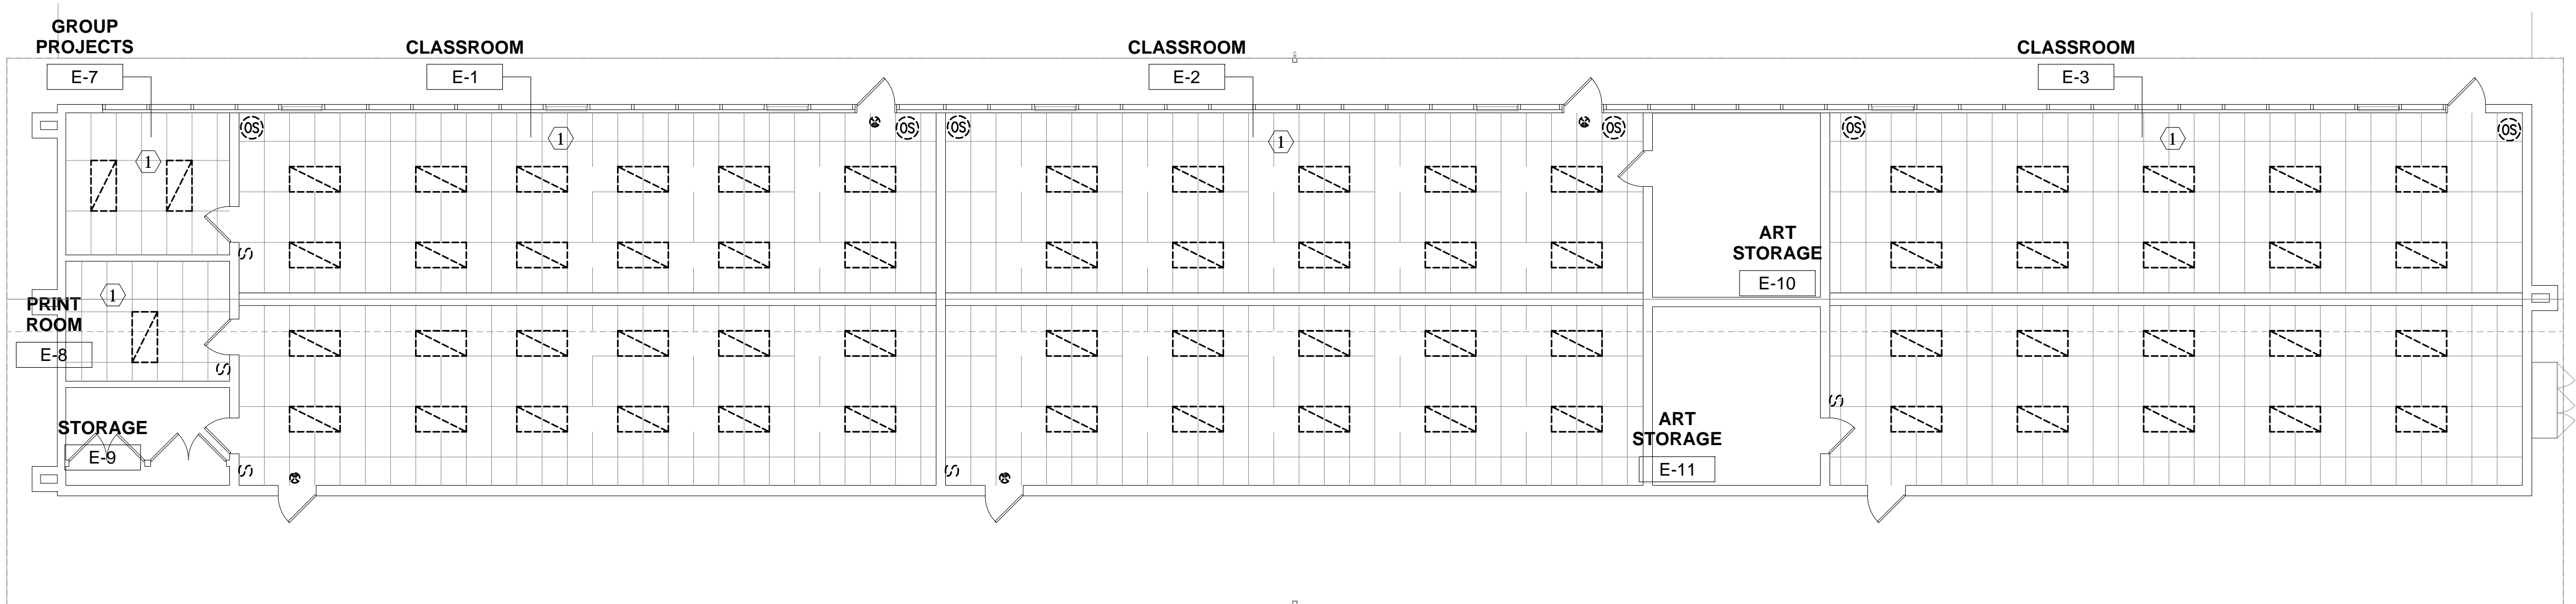


2

BUILDING E - WEST WING - LIGHTING DEMO FLOOR PLAN

SCALE: 1/8" = 1'-0"

NORTH

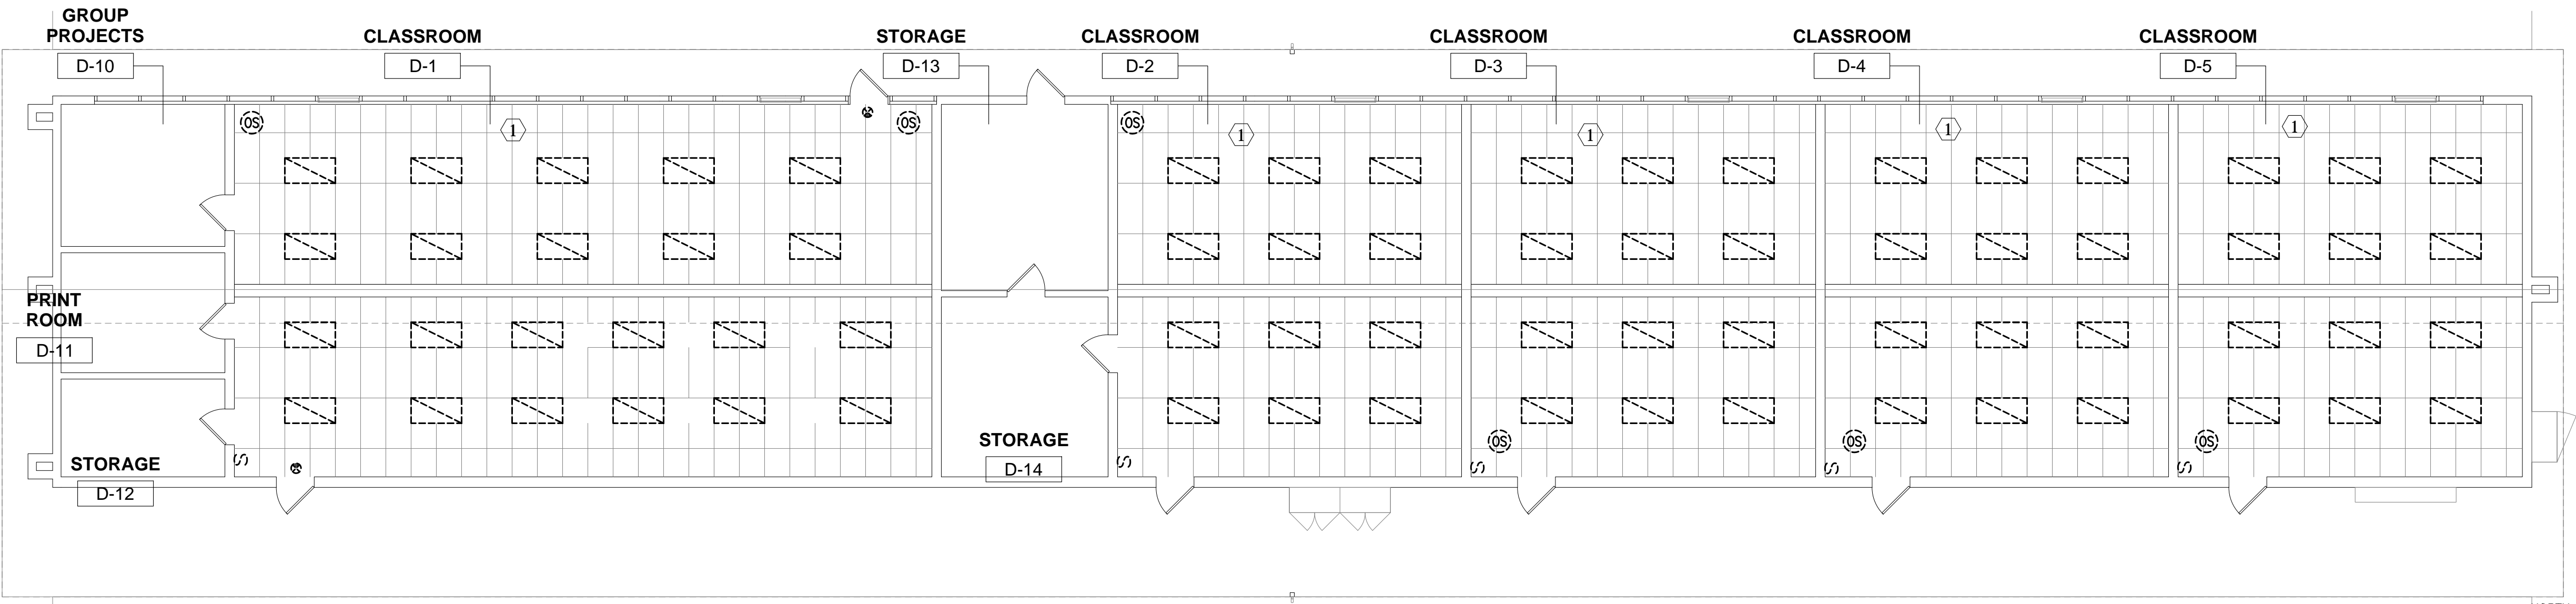


3

BUILDING D - WEST WING - LIGHTING DEMO FLOOR PLAN

SCALE: 1/8" = 1'-0"

NORTH

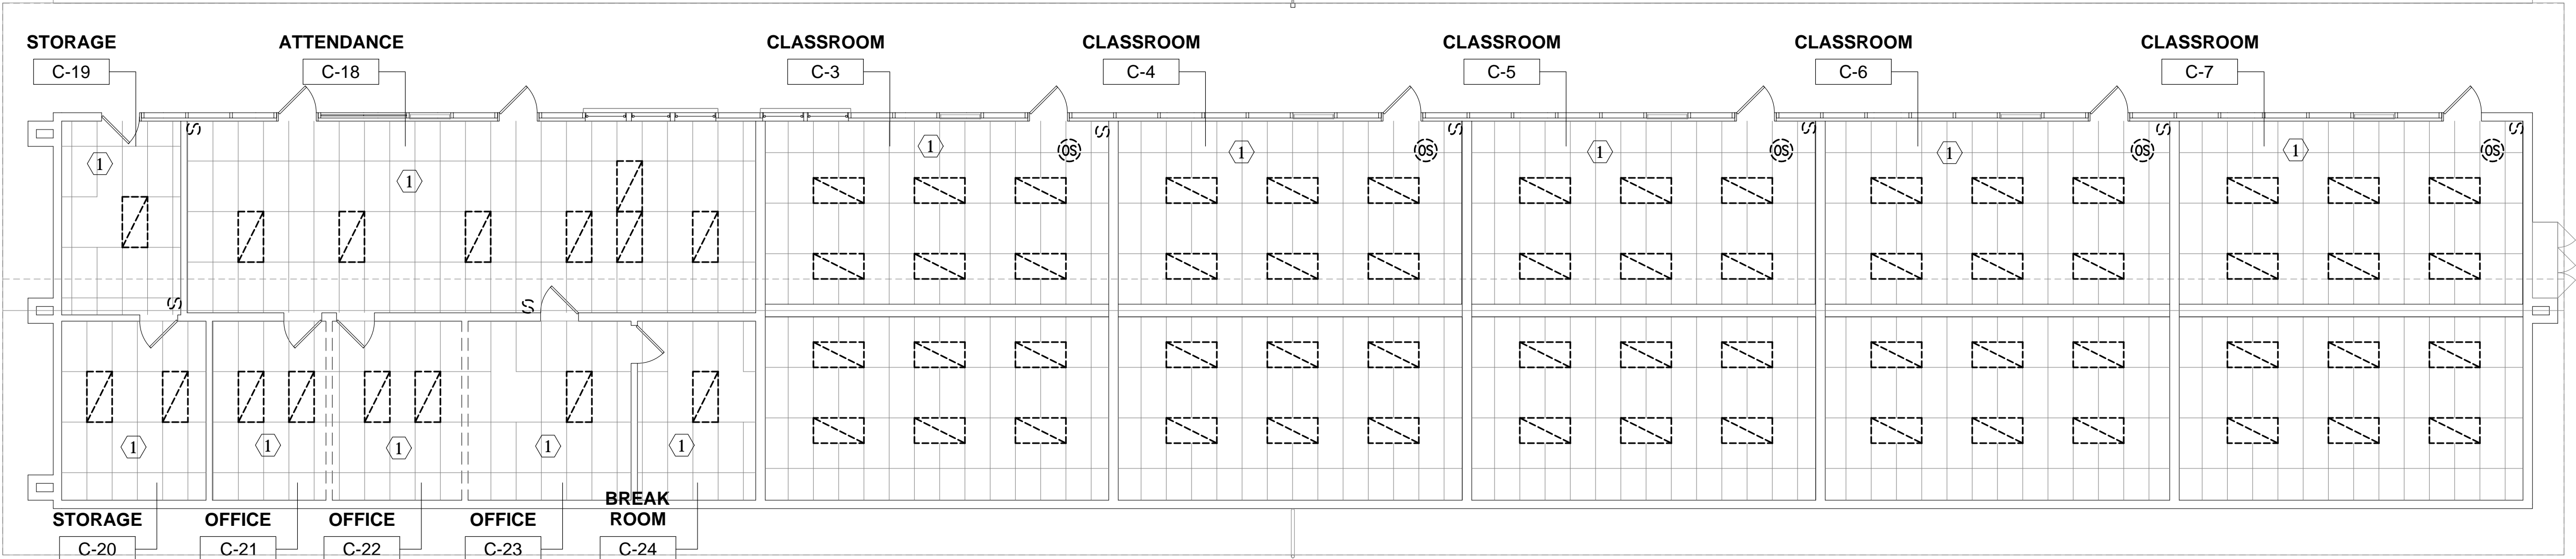

4

BUILDING C - WEST WING - LIGHTING DEMO FLOOR PLAN

SCALE: 1/8" = 1'-0"

NORTH

SHEET NOTES

- CONTRACTOR SHALL VISIT THE SITE TO DETERMINE THE EXTENT SCOPE OF DEMOLITION WORK REQUIRED.
- DURING THE CEILING DEMOLITION AND NEW INSTALLATION, (E) WIRING SHALL BE PROTECTED OR REMOVED AND REINSTALLED. FIELD VERIFY REQUIREMENTS.
- WHERE ITEMS ARE REMOVED, MAKE ANY RECONNECTIONS REQUIRED TO MAINTAIN CIRCUITS TO (E) DEVICES THAT ARE TO REMAIN.

NUMBERED NOTES

- 1 REMOVE ALL (E) LIGHT FIXTURES, SWITCHES, OCCUPANCY SENSORS, EXIT SIGNS AND ALL ASSOCIATED CONDUITS AND WIRING IN ROOM



Revisions				
No.	Revisions	By	Date	Appr.
1	Addendum #2		5/22/18	

BACKCHECK SET

ISSUE DATE: 4/17/18 BY: AA

DSA APPROVAL

IDENTIFICATION STAMP  
DIVISION OF STATE ARCHITECT  
APPL: 02-116505  
AC \_\_\_\_\_ FL \_\_\_\_\_ SS \_\_\_\_\_  
DATE \_\_\_\_\_  
FILE NO. 67439-353


EDGE ELECTRICAL CONSULTING

431 30th Street  
Sacramento, CA 95816  
916.256.2460  
Project Number E373 Contact CHRIS

300 27th Street #201  
Oakland, CA 94612  
510.775.3836

This document is the property of the Owner and is not to be used without his written permission

Architect/Engineer Of Record:

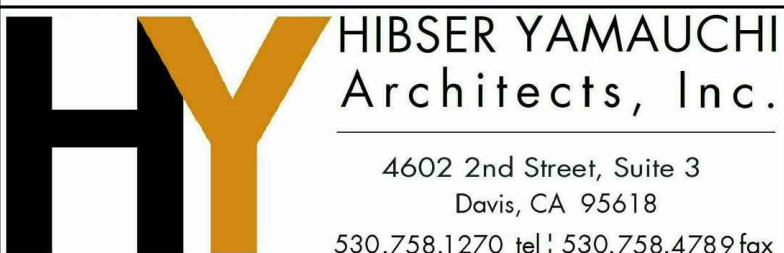

HY Architects Project number: 5077

Facility

HIRAM JOHNSON HIGH SCHOOL  
6879 14th Ave, Sacramento, CA 95820

Project  
HVAC UPGRADE

Sheet Title  
LIGHTING DEMO PLANS  
WEST WING

Client Project Number: 1 Client Proj. #

Scale: As indicated Sheet

Drawn By: Chris


Checked By: Donny

Issue Date: 4/17/18


Revit Version: 2017

E2.04




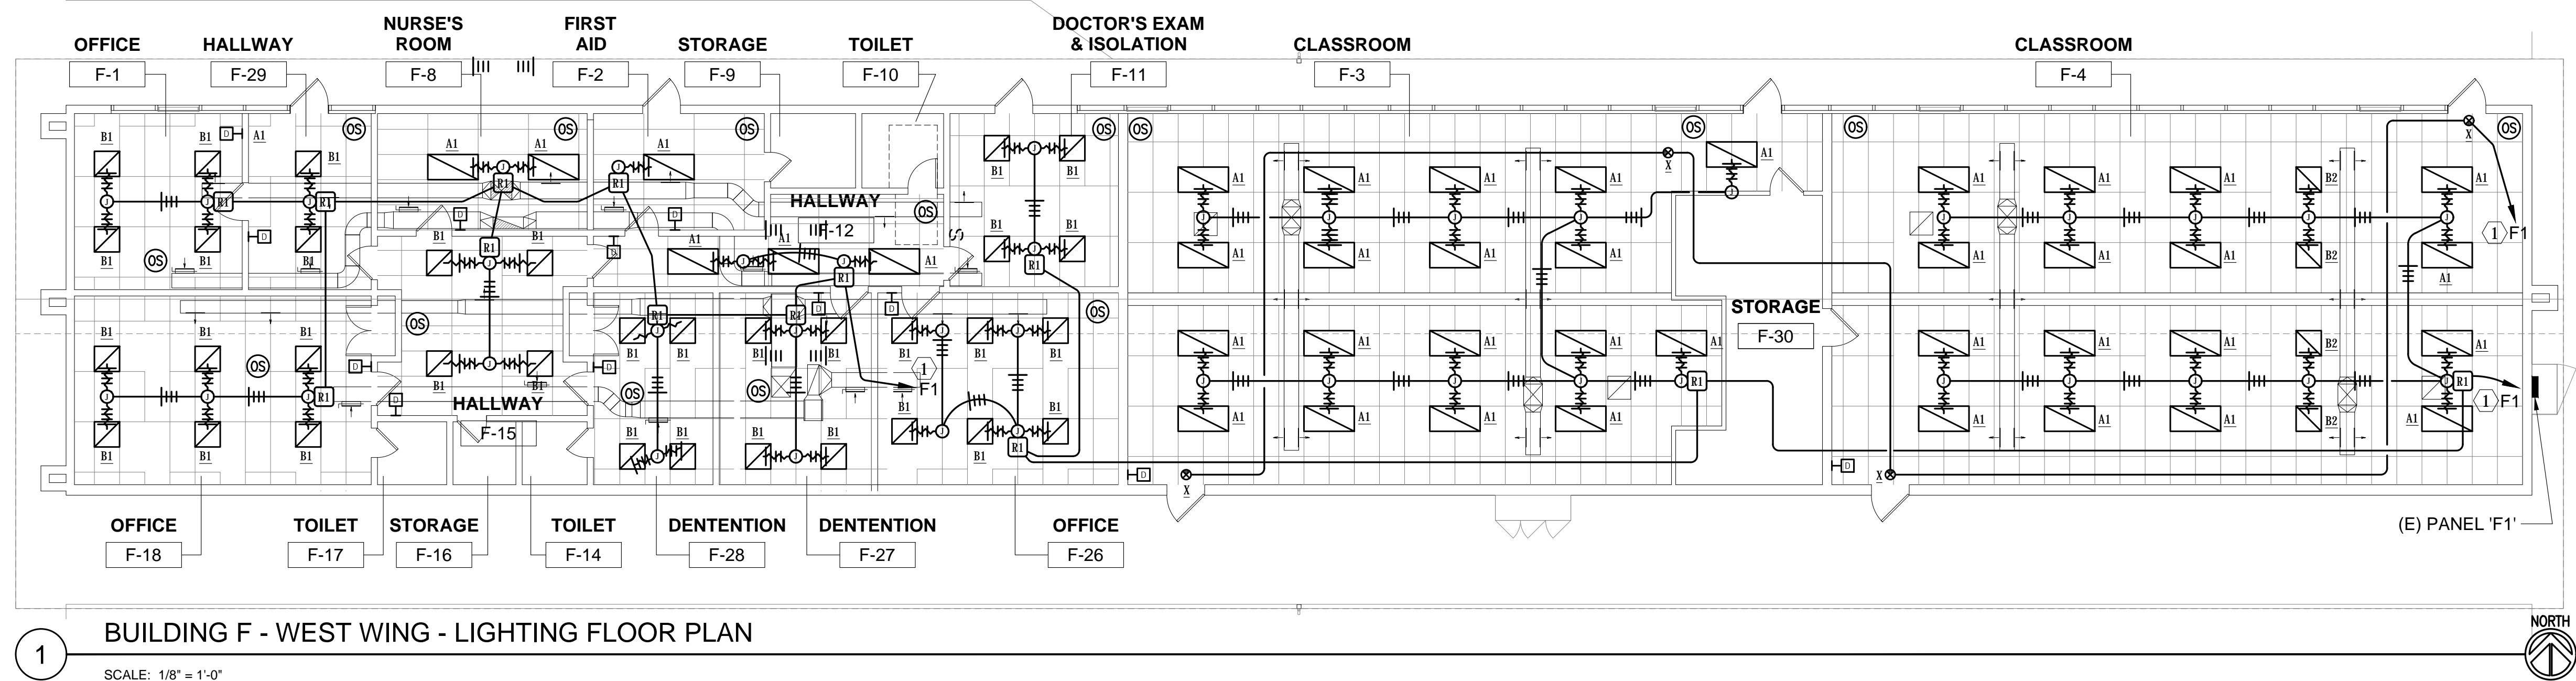


1 BUILDING F - WEST WING - LIGHTING FLOOR PLAN

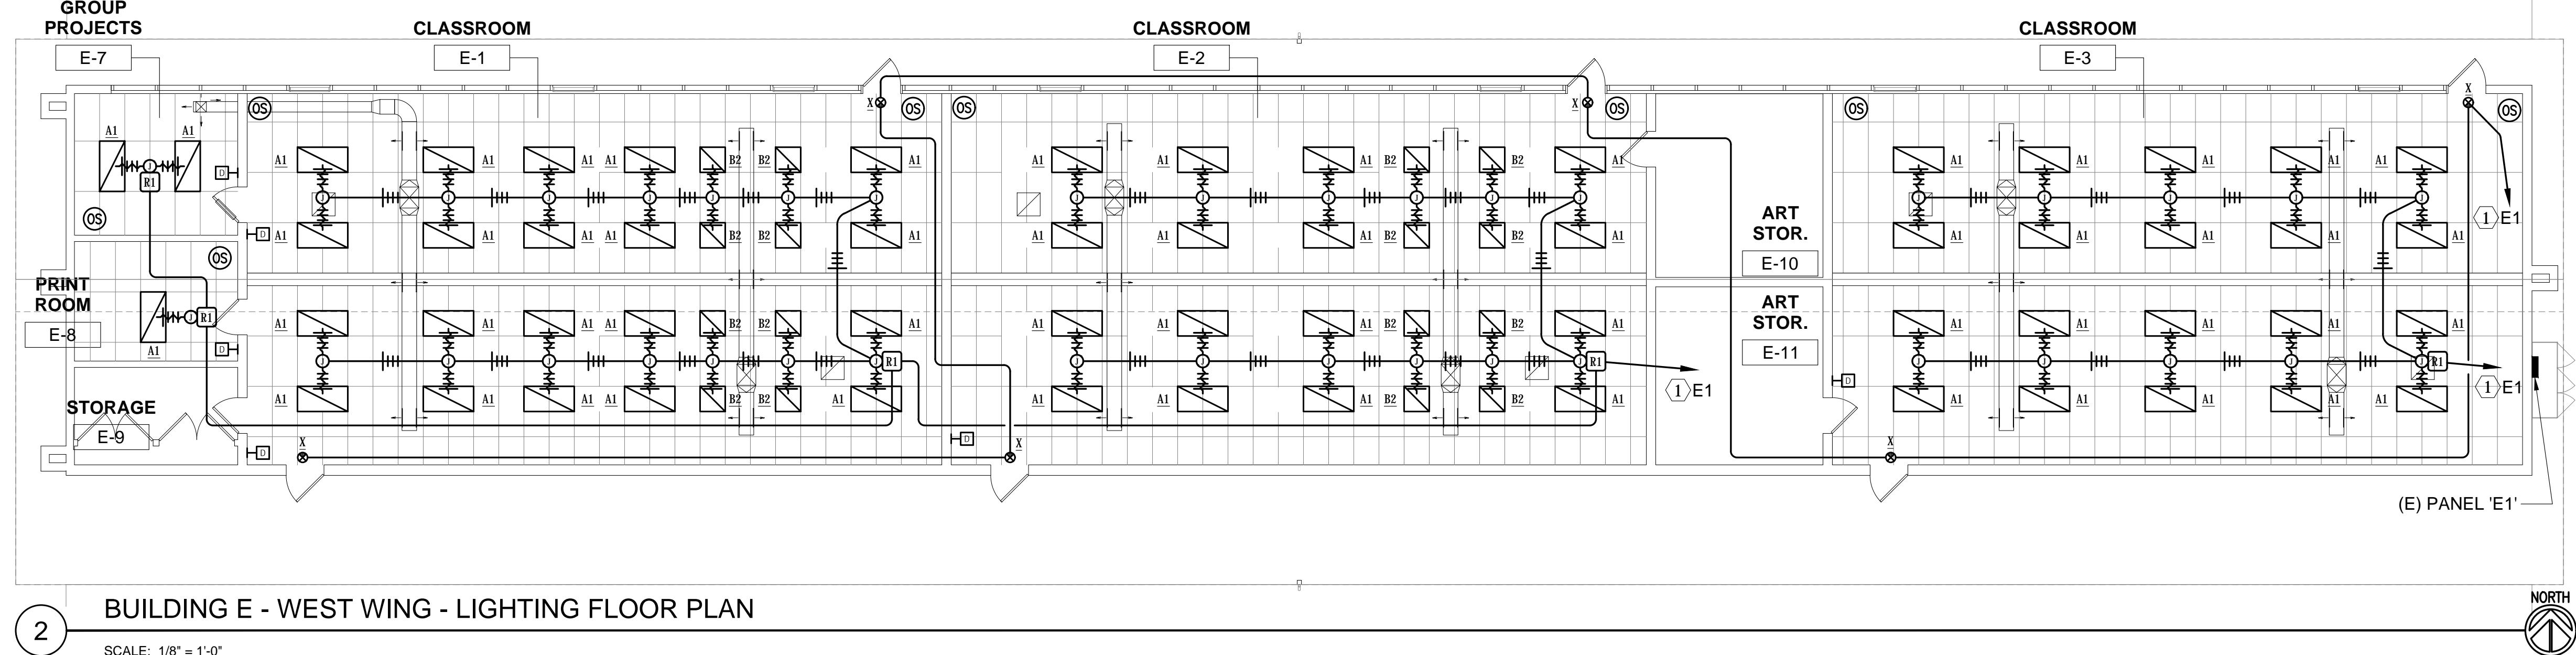

2 BUILDING E - WEST WING - LIGHTING FLOOR PLAN

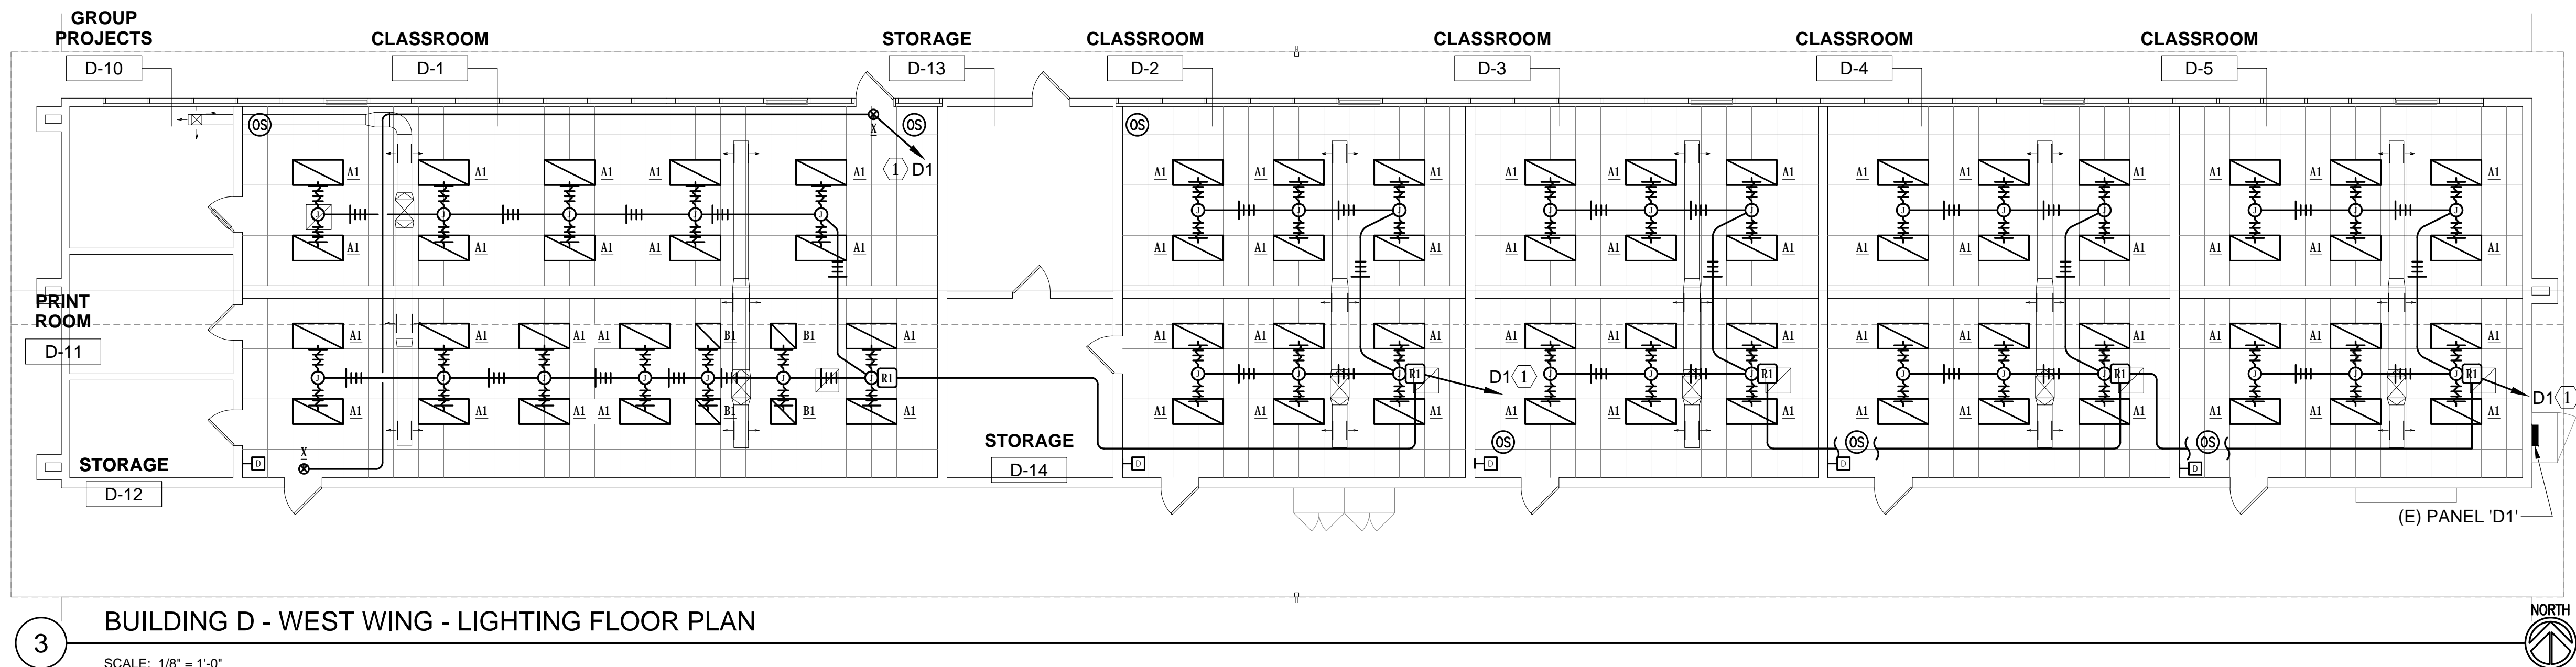

3 BUILDING D - WEST WING - LIGHTING FLOOR PLAN

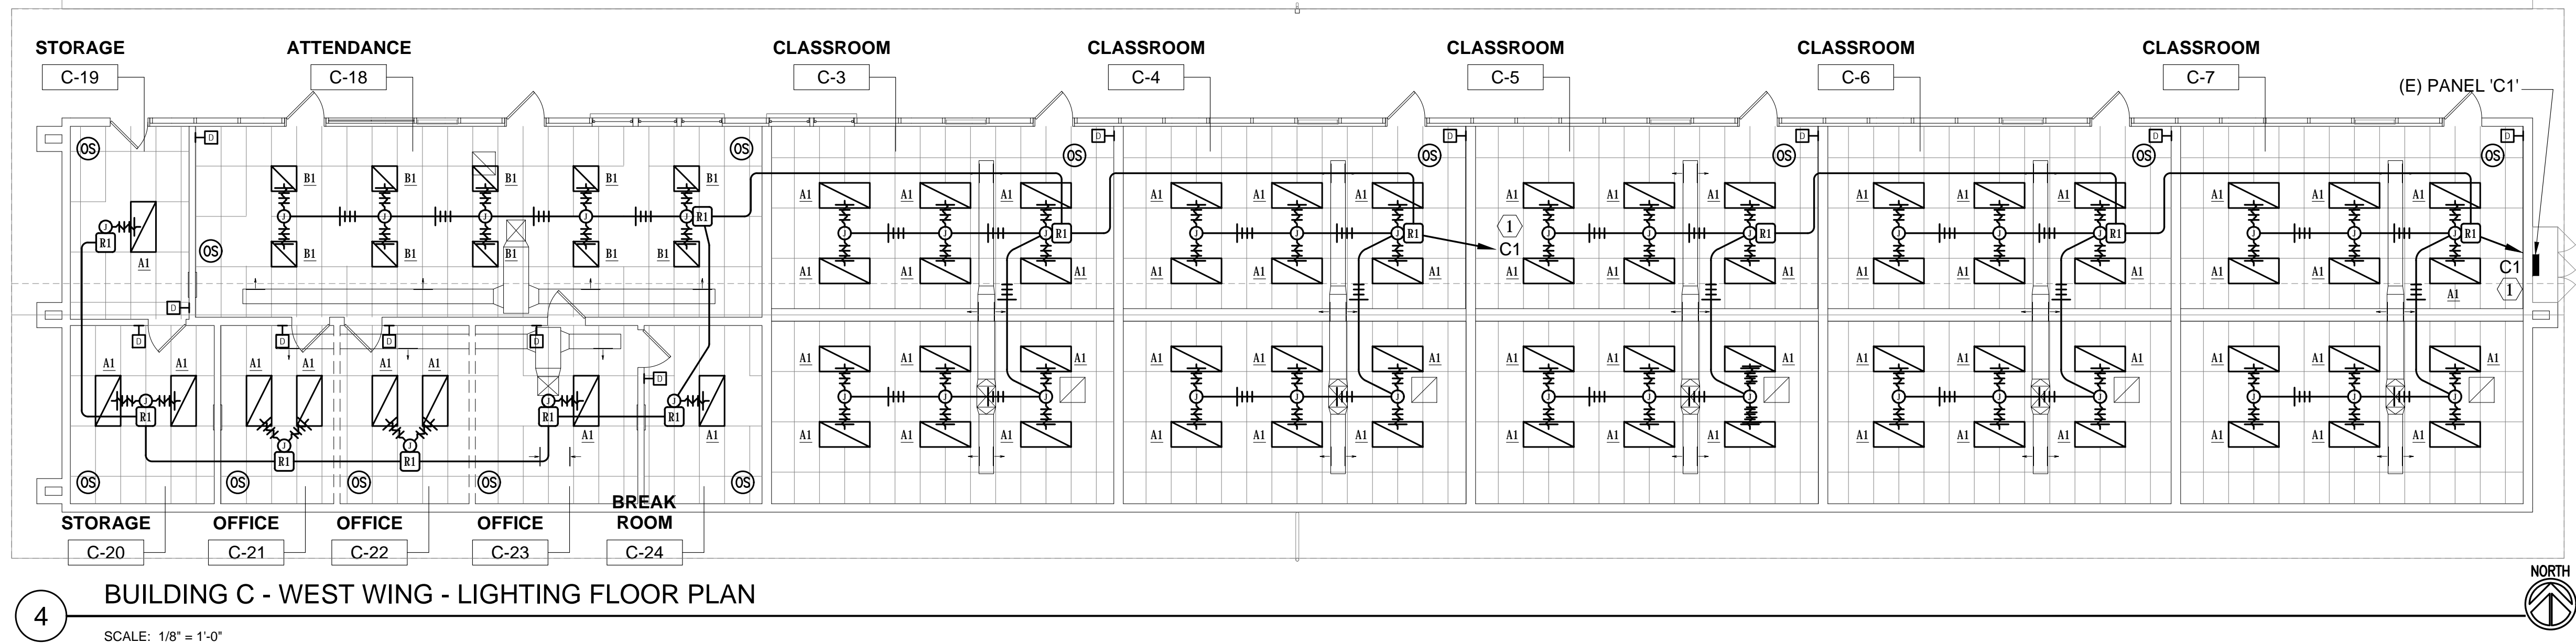

4 BUILDING C - WEST WING - LIGHTING FLOOR PLAN

## NUMBERED NOTES

- 1 PROVIDE (N) 20A/1P BREAKER IN (E) SPACE. AIC OF (N) BREAKER SHALL MATCH (E) BREAKERS.
- 2
- 3



Revisions				
No.	Revisions	By	Date	Appr.
1	Addendum #2		5/22/18	

## BACKCHECK SET

ISSUE DATE: 4/17/18 BY: AA

## DSA APPROVAL

IDENTIFICATION STAMP

DIVISION OF STATE ARCHITECT

APPL: 02-116505

AC FLS SS

DATE

FILE NO. 67439-353

## EDGE ELECTRICAL CONSULTING



431 30th Street  
Sacramento, CA 95816  
916.256.2460

300 27th Street #201  
Oakland, CA 94612  
510.775.3836

Project Number E373 Contact CHRIS

This document is the property of the Owner and is not to be used without his written permission.

Architect/Engineer Of Record:

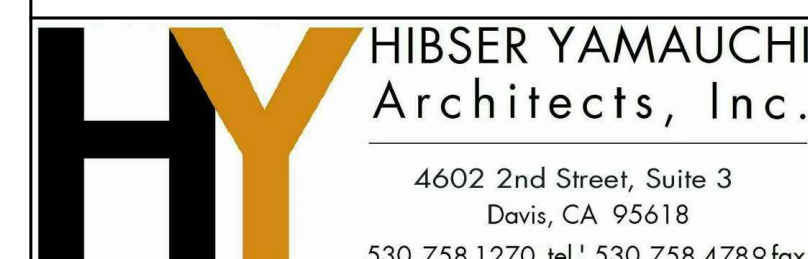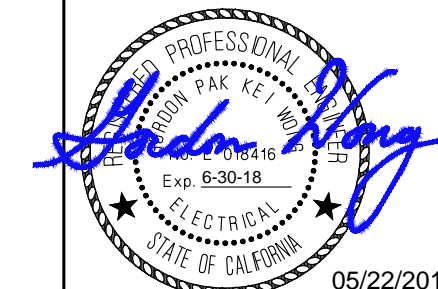

HY Architects Project number: 5077

Facility

HIRAM JOHNSON HIGH SCHOOL  
6879 14th Ave, Sacramento, CA 95820

Project

HVAC UPGRADE

Sheet Title  
LIGHTING PLANS  
WEST WING

Client Project Number: 1 Client Proj. #

Scale: As indicated






Drawn By: Chris

Checked By: Donny


Issue Date: 4/17/18

Revit Version: 2017

E2.22

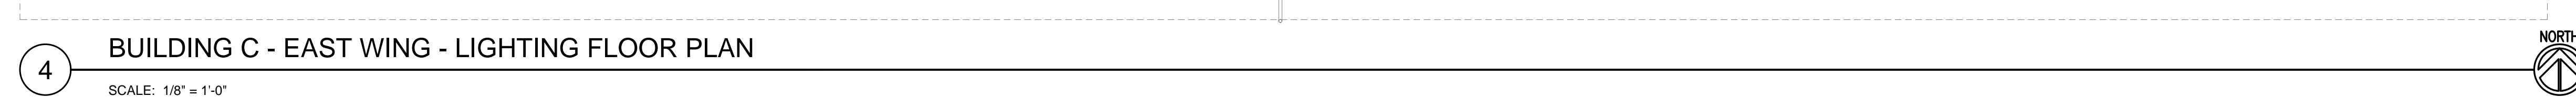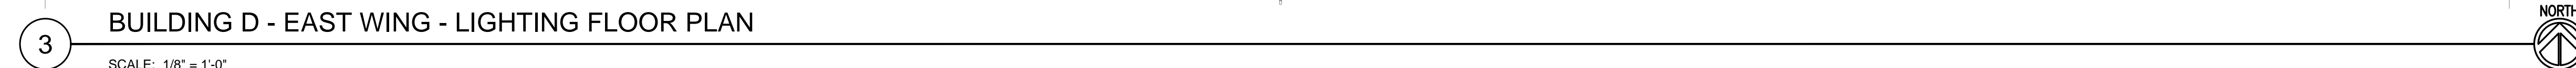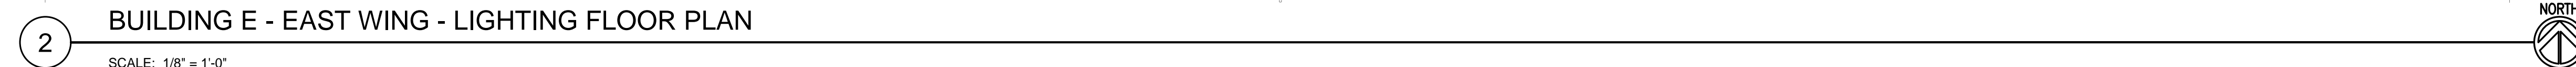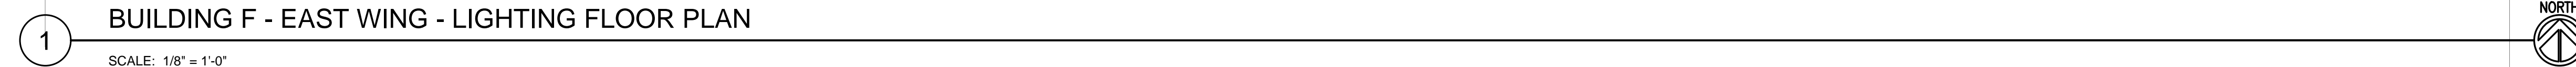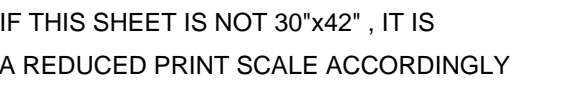

1 PROVIDE (N) 20A/1P BREAKER IN (E) SPACE. AIC OF (N) BREAKER SHALL MATCH (E) BREAKERS.

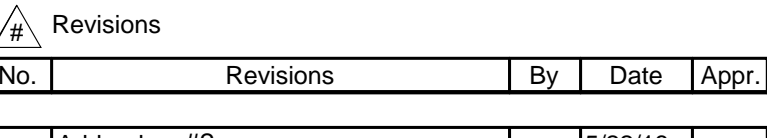

Addendum #2		5/22/18	
-------------	--	---------	--

ISSUE DATE: 4/17/18 BY: AA

IDENTIFICATION STAMP  
DIVISION OF STATE ARCHITECT

APPL. 02-116505

AC \_\_\_\_\_ FLS \_\_\_\_\_ SS \_\_\_\_\_  
DATE \_\_\_\_\_

DATE \_\_\_\_\_

FILE NO. 67439-353

1 30th Street Sacramento, CA 95816 6.256.2460	300 27th Street #201 Oakland, CA 94612 510.775.3836
---	---



1 30th Street Sacramento, CA 95816 6.256.2460	300 27th Street #201 Oakland, CA 94612 510.775.3836
---	---

Project Number E373 Contact CHRIS

---

This document is the property of the Owner and is not to be used without his written permission

Architect/Engineer Of Record: \_\_\_\_\_

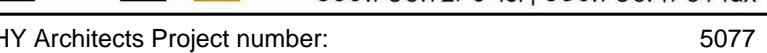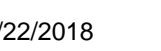

Facility

HIRAM JOHNSON HIGH SCHOOL  
6879 14th Ave, Sacramento, CA 95820

Project

## HVAC UPGRADE

### THREE STAGES

Sheet Title

## LIGHTING PLANS

EAST WING

△

Client Project Number:  Client Proj. #

Scale: As indicated

Drawn By: Chris

Checked By: Donny **F2 23**

Issue Date: 4/17/18


Issue Date: 4/17/10

Result Version: 2017

## E2.23



IF THIS SHEET IS NOT 30"x42", IT IS  
A REDUCED PRINT SCALE ACCORDINGLY

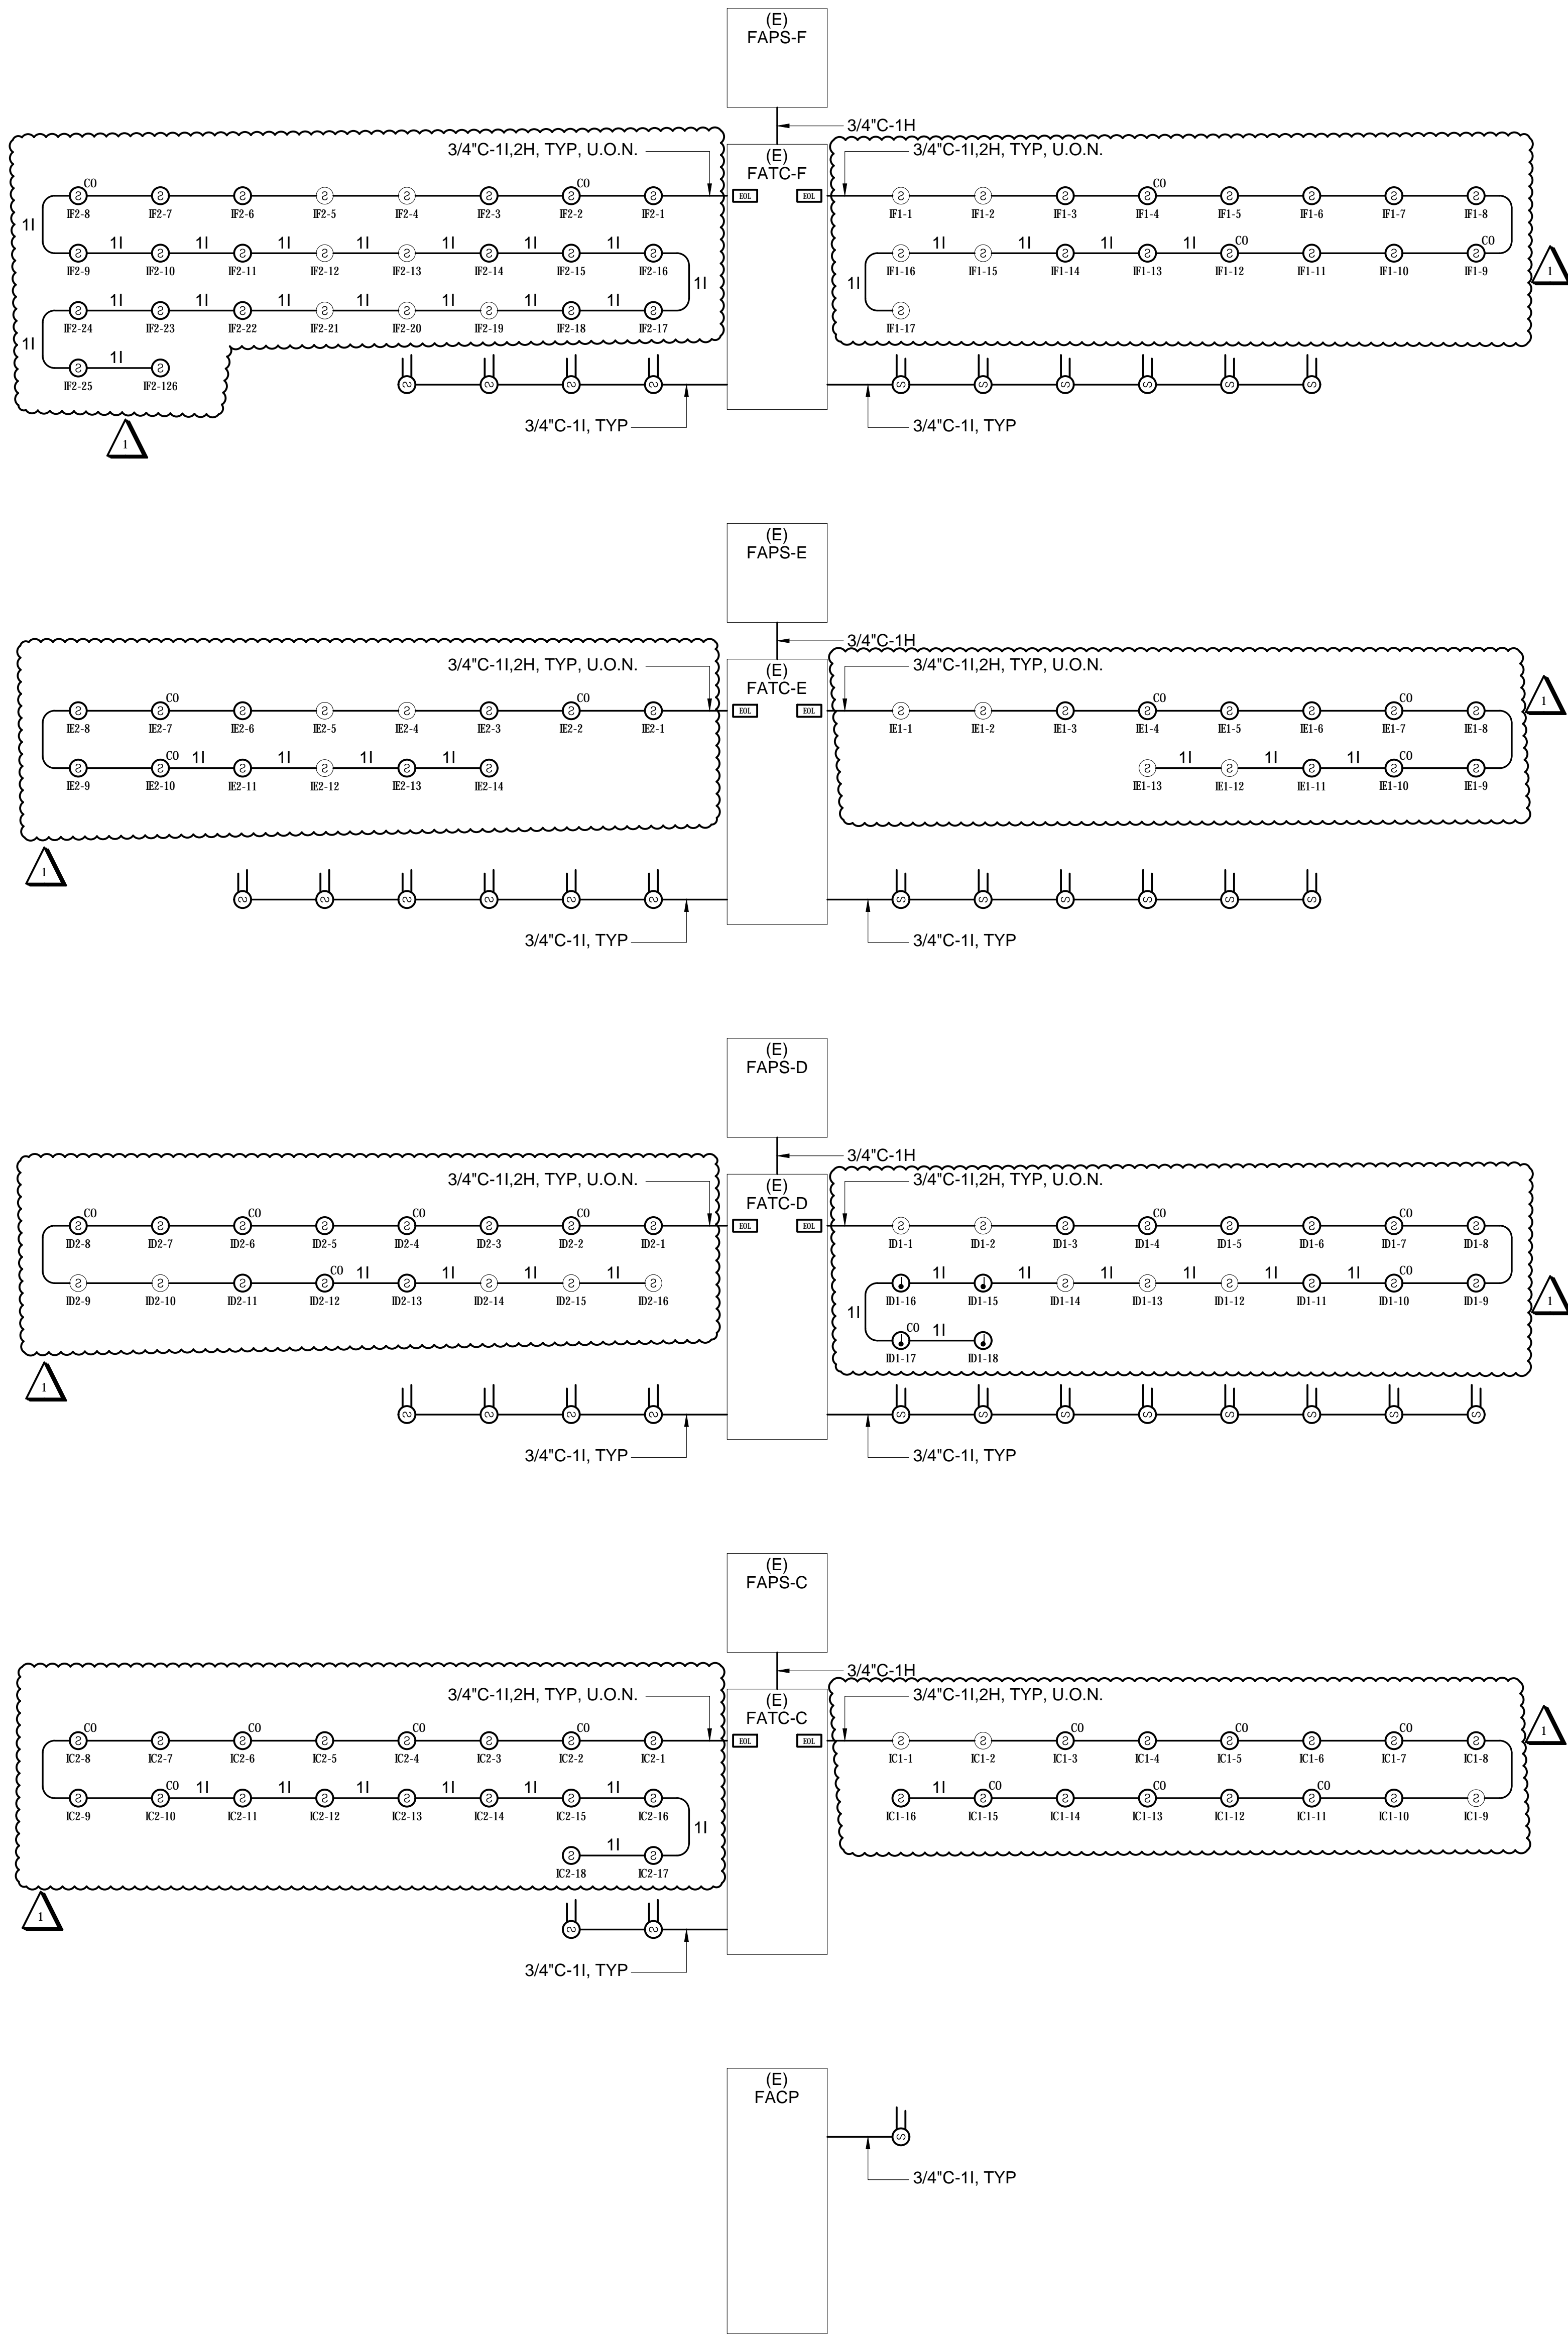

## FIRE ALARM RECORD DOCUMENTS CABINET

1. THE FIRE ALARM SYSTEM WORK SHALL INCLUDE A DOCUMENTATION CABINET, INSTALLED AT THE SYSTEM CONTROL PANEL OR OTHER APPROVED LOCATION PER NFPA 72, 7.7.2.
2. THE DOCUMENTATION CABINET SHALL BE RED WITH A HINGED, LOCKING DOOR AND SHALL BE PROMINENTLY LABELED "SYSTEM RECORD DOCUMENTS".
3. ALL RECORD AND TESTING DOCUMENTATION SHALL BE STORED INSIDE THE CABINET.
4. CONTENTS SHALL BE ACCESSIBLE BY AUTHORIZED PERSONNEL ONLY.
5. WHERE CABINET IS INSTALLED IN A LOCATION OTHER THAN THE SYSTEM CONTROL UNIT, ITS LOCATION SHALL BE IDENTIFIED AT THE SYSTEM CONTROL UNIT.
6. PROVIDE SYSTEM DOCUMENTS AS APPLICABLE:
  - a. RECORD DRAWINGS/AS-BUILTS
  - b. EQUIPMENT CUT SHEETS AND CA SFM LISTINGS
  - c. ALTERNATIVE MEANS AND METHODS
  - d. PERFORMANCE BASED DESIGN DOCUMENTATION (NFPA 72, 7.3.7)
  - e. SYSTEM RECORD OF COMPLETION AND ANY SUPPLEMENTAL INSPECTION AND TESTING DOCUMENTATION (NFPA 72, 7.8.2)
  - f. EMERGENCY RESPONSE PLAN (NFPA 72, 7.3.8)
  - g. EVALUATION DOCUMENTATION (NFPA 72, 7.3.9)
  - h. RISK ANALYSIS DOCUMENTATION (NFPA 72, 7.3.6)
  - i. SOFTWARE AND FIRMWARE CONTROL DOCUMENTATION (NFPA 72, 23.2.2)

## FIRE ALARM MONITORING NOTE

AUTOMATIC FIRE ALARM SYSTEMS SHALL TRANSMIT THE ALARM, SUPERVISORY AND TROUBLE SIGNALS TO AN APPROVED SUPERVISING STATION AS REQUIRED BY NFPA 72. THE SUPERVISING STATION SHALL BE LISTED AS EITHER UJFX OR UJUS BY UNDERWRITERS LABORATORY OR SHALL MEET THE REQUIREMENTS OF FACTORY MUTUAL RESEARCH APPROVAL STANDARD 3011. SUPERVISION OF SYSTEM AND LEASED TELEPHONE LINES SHALL BE ARRANGED BY OWNER.

## FIRE ALARM SYSTEM SEQUENCE OF OPERATION

X = REQUIRED ACTION BLANK MEANS NOT APPLICABLE		EFFECT	ALARM				TROUBLE		SUPERVISORY		REMARKS
			ALARM AT FACP	ALARM AT OFF-SITE REPORTING	ACTIVATE AUDIBLE/VISUAL ALARMS	LOCAL ALARM (SOUNDER BASE, TEMPORAL)	TROUBLE AT FACP	TROUBLE AT OFF-SITE REPORTING	SUPERVISORY CONDITION AT FACP	SUPERVISORY CONDITION AT OFF-SITE REPORTING	
CAUSE											
1	SMOKE DETECTOR	X	X	X							
2	HEAT DETECTOR	X	X	X							
3	CARBON MONOXIDE DETECTOR				X		X				
4	MANUAL PULL STATION	X	X	X							
5	DUCT DETECTOR	X	X	X							SHUTDOWN ASSOCIATED MECHANICAL UNIT (BY MECHANICAL)
6	POWER FAILURE						X	X			
7	FIRE ALARM TROUBLE (OPEN, SHORTS OR GROUNDS ON INITIATION, NOTIFICATION OR SIGNALING LINE CIRCUITS)						X	X			

## WIRE SCHEDULE

TYPE	DESCRIPTION
H	2 #14 THHN/THWN (RED, BLACK) (SOUNDER BASE AUX. POWER)
I	WEST PENN D980 (FIRE ALARM ADDRESSABLE CABLE)
N	2 #12 THHN/THWN (FIRE ALARM NOTIFICATION WIRING)

### NOTES:

1. VERIFY ALL WIRING TYPES AND QUANTITY WITH SYSTEM VENDOR REQUIREMENTS.
2. PROVIDE SPARE CABLES WHERE SHOWN.

## FIRE ALARM SYMBOLS

SYMBOL	DESCRIPTION
②	FIRE ALARM SMOKE DETECTOR.
② <sub>CO</sub>	FIRE ALARM SMOKE/CARBON MONOXIDE DETECTOR.
①	FIRE ALARM HEAT DETECTOR.
① <sub>CO</sub>	FIRE ALARM HEAT/CARBON MONOXIDE DETECTOR.
② <sub>—</sub>	FIRE ALARM DUCT SMOKE DETECTOR.
END	END OF LINE RESISTOR.
⊠	FIRE ALARM HORN / CHIME.
⊠	FIRE ALARM HORN / CHIME / STROBE COMBINATION.
⊠	FIRE ALARM WALL MOUNTED STROBE LIGHT.
⊠	FIRE ALARM CEILING MOUNTED STROBE LIGHT.
⊠	FIRE ALARM CEILING MOUNTED HORN / CHIME / STROBE COMBINATION.
MM	FIRE ALARM MONITOR MODULE.

## Fire Alarm Components

Manufacturer	Model No.	Description	CSFM Listings No.
NOTIFIER	FSP-951R	SMOKE DETECTOR	7272-0028-0206
SYSTEM SENSOR	B224RB	SMOKE DETECTOR BASE	7300-1853-0126
SYSTEM SENSOR	DNR	DUCT SMOKE DETECTOR HOUSING	3242-1853-0209
SYSTEM SENSOR	RTS151KEY	DUCT DETECTOR REMOTE TEST STATION	7300-1853-0212
NOTIFIER	FCO-851	SMOKE/CARBON MONOXIDE DETECTOR	7275-0028-0264
NOTIFIER	FCO-851	HEAT/CARBON MONOXIDE DETECTOR	7275-0028-0264
SYSTEM SENSOR	B501BHT	DETECTOR SOUNDER BASE	7300-1853-0106
NOTIFIER	RSS-240C/WR	STROBE	7125-0765-0141
WHEELLOCK	HSRC	HORN/STROBE, CEILING MOUNTED	7123-2765-0165

## FIRE ALARM GENERAL NOTES

1. FURNISH AND INSTALL A (N) FIRE ALARM SYSTEM INCLUDING ALL WIRING AND CONNECTIONS AND OTHER MATERIALS AS SHOWN ON PLANS AND SPECIFIED HEREIN. IT IS THE INTENT THAT A COMPLETE OPERATING SYSTEM CONFORMING TO ALL APPLICABLE CODES BE INSTALLED AND THAT ANY POWER SUPPLIES, RELAYS, RESISTORS, CARDS, MODULES, PROGRAMMING, OR OTHER ITEMS REQUIRED TO ACHIEVE THIS END RESULT SHALL BE FURNISHED WHETHER OR NOT SUCH ITEM OR ITEMS ARE SHOWN OR SPECIFIED.
2. THE CONTRACT DRAWINGS AND SPECIFICATIONS INDICATE THE GENERAL SCOPE OF THE FIRE ALARM SYSTEM. THE FIRE ALARM SYSTEM CONTRACTOR SHALL LAYOUT ALL DEVICES, EQUIPMENT, CONDUIT, WIRING, ETC. AND SUBMIT DRAWINGS AS REQUIRED BY THE SPECIFICATIONS. ALL LOCATIONS AND SPACINGS SHALL CONFORM TO APPLICABLE CODES. ANY ADDITIONAL DETECTION AND SIGNALING DEVICES REQUIRED BY CODES AND THE ENFORCING AUTHORITY SHALL BE PROVIDED AS PART OF THIS CONTRACT.
3. THE SYSTEM SHALL BE FULLY AUTOMATIC WITH MANUAL STATIONS AT MAIN OFFICE AND IN ASSEMBLY AREAS.
4. THE SYSTEM SHALL BE ADDRESSABLE WITH CLASS B SIGNALING CIRCUITS (NAC'S) AND CLASS B WIRING FOR NON-ADDRESSABLE PORTIONS OF INITIATION CIRCUITS.
5. INSTALLATION OF THE FIRE ALARM SYSTEM EQUIPMENT SHALL NOT BE STARTED UNTIL SUBMITTAL HAS BEEN APPROVED BY ARCHITECT.
6. THE FIRE ALARM SYSTEM SHALL CONFORM TO THE FOLLOWING CODES:
  - CALIFORNIA BUILDING CODE (CBC), 2016
  - CALIFORNIA ELECTRICAL CODE (CEC), 2016
  - CALIFORNIA FIRE CODE (CFC), 2016
  - NATIONAL FIRE PROTECTION ASSOCIATION (NFPA) NFPA 72 WITH CALIFORNIA AMENDMENTS, 2016
7. IF FIRE ALARM TESTING RESULTS DETERMINE ALARM AUDIBILITY DOES NOT REACH 15db OVER AMBIENT NOISE LEVELS, ADDITIONAL SIGNALING DEVICES SHALL BE REQUIRED. AUDIBLE DEVICES SHALL PROVIDE A SOUND LEVEL OF NOT LESS THAN 75db AT 10 FT. OR MORE THAN 110db MAXIMUM.
8. AUDIBLE DEVICES SHALL PROVIDE THE CALIFORNIA UNIFORM FIRE ALARM SIGNAL IN TEMPORAL MODE.
9. VISUAL DEVICES SHALL NOT EXCEED 2 FLASHES PER SECOND AND SHALL NOT BE SLOWER THAN 1 FLASH PER SECOND. ALL DEVICES WITHIN THE NORMAL VIEW RANGE SHALL BE SYNCHRONIZED.
10. REFER TO "DETAIL-FR DEVICE ELEVATIONS" FOR DEVICE MOUNTING HEIGHTS.
11. UPON COMPLETION OF THE INSTALLATION OF THE FIRE PROTECTIVE SIGNALING EQUIPMENT, A SATISFACTORY TEST OF THE ENTIRE SYSTEM SHALL BE MADE IN THE PRESENCE OF THE PROJECT INSPECTOR/DSA.
12. POWER SERVICE FOR FIRE ALARM CONTROL PANELS AND/OR REMOTE POWER SUPPLIES SHALL BE ON DEDICATED CIRCUITS. CIRCUIT BREAKER HANDLES FOR SUCH DEDICATED CIRCUITS SHALL BE PAINTED RED AND IDENTIFIED IN DIRECTORY AS "FIRE ALARM CIRCUIT". CIRCUIT BREAKER(S) SERVING CONTROL PANELS AND POWER SUPPLIES SHALL BE EQUIPPED WITH HANDLE LOCKS TO PREVENT BREAKERS FROM BEING OPENED BY UNAUTHORIZED PERSONS.
13. THE LOCATION OF THE DEDICATED CIRCUIT BREAKER SERVING CONTROL PANELS AND POWER SUPPLIES SHALL BE PERMANENTLY IDENTIFIED AT THE CONTROL PANELS AND POWER SUPPLIES. PROVIDE ADHESIVE BACKED NAMEPLATE TO READ "DEDICATED 120V CIRCUIT FROM \_\_\_\_\_" WITH CIRCUIT NUMBER INCLUDED IN TEXT. ATTACH TO INSIDE OF DOOR.
14. FINAL FIRE TEST SHALL BE MADE WITH PROJECT INSPECTOR AS A MINIMUM. LOCAL FIRE AUTHORITY SHALL BE NOTIFIED OF DATE AND TIME OF FINAL FIRE ALARM TESTING AND SHALL ASSIST/WITNESS SUCH TESTING WHEN ABLE.
15. FIRE ALARM CONTRACTOR SHALL PROVIDE A "RECORD OF COMPLETION" TO THE PROJECT INSPECTOR/ DSA AFTER COMPLETION OF THE OPERATIONAL ACCEPTANCE TESTS. THE RECORD OF COMPLETION MUST BE SIGNED BY CONTRACTOR.



# Revisions				
No.	Revisions	By	Date	Appr.
1	Addendum #2		5/22/18	

## BACKCHECK SET

ISSUE DATE: 4/17/18 BY: AA

## DSA APPROVAL

IDENTIFICATION STAMP

DIVISION OF STATE ARCHITECT

APPL 02-116505

AC FLS SS

DATE

FILE NO. 67439-353



431 30th Street  
Sacramento, CA 95816  
916.256.2480

300 27th Street #201  
Oakland, CA 94612  
510.775.3856


Project Number E373 Contact CHRIS

This document is the property of the Owner and is not to be used without his written permission.

Architect/Engineer Of Record:



05/22/2018

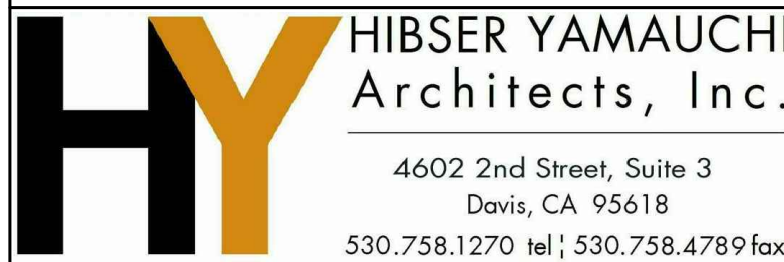

4602 2nd Street, Suite 3  
Davis, CA 95618

530.758.1270 tel | 530.758.4789 fax

HY Architects Project number: 5077

Facility

HIRAM JOHNSON HIGH SCHOOL  
6879 14th Ave, Sacramento, CA 95820

Project

HVAC UPGRADE

Sheet Title

FIRE ALARM COVER SHEET

Client Project Number: Client Proj. #

Scale: As indicated


Drawn By: Chris

Checked By: Donny


Issue Date: 4/17/18

Revit Version: 2017

E3.01

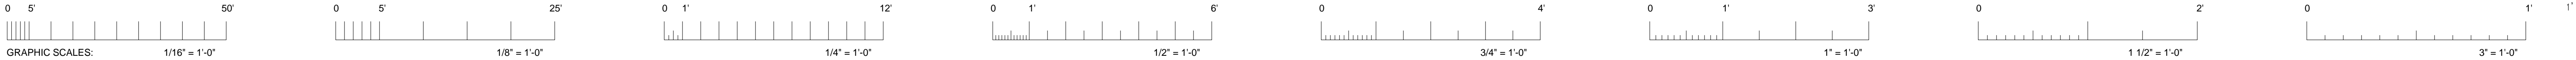

IF THIS SHEET IS NOT 30"x42", IT IS  
A REDUCED PRINT SCALE ACCORDINGLY

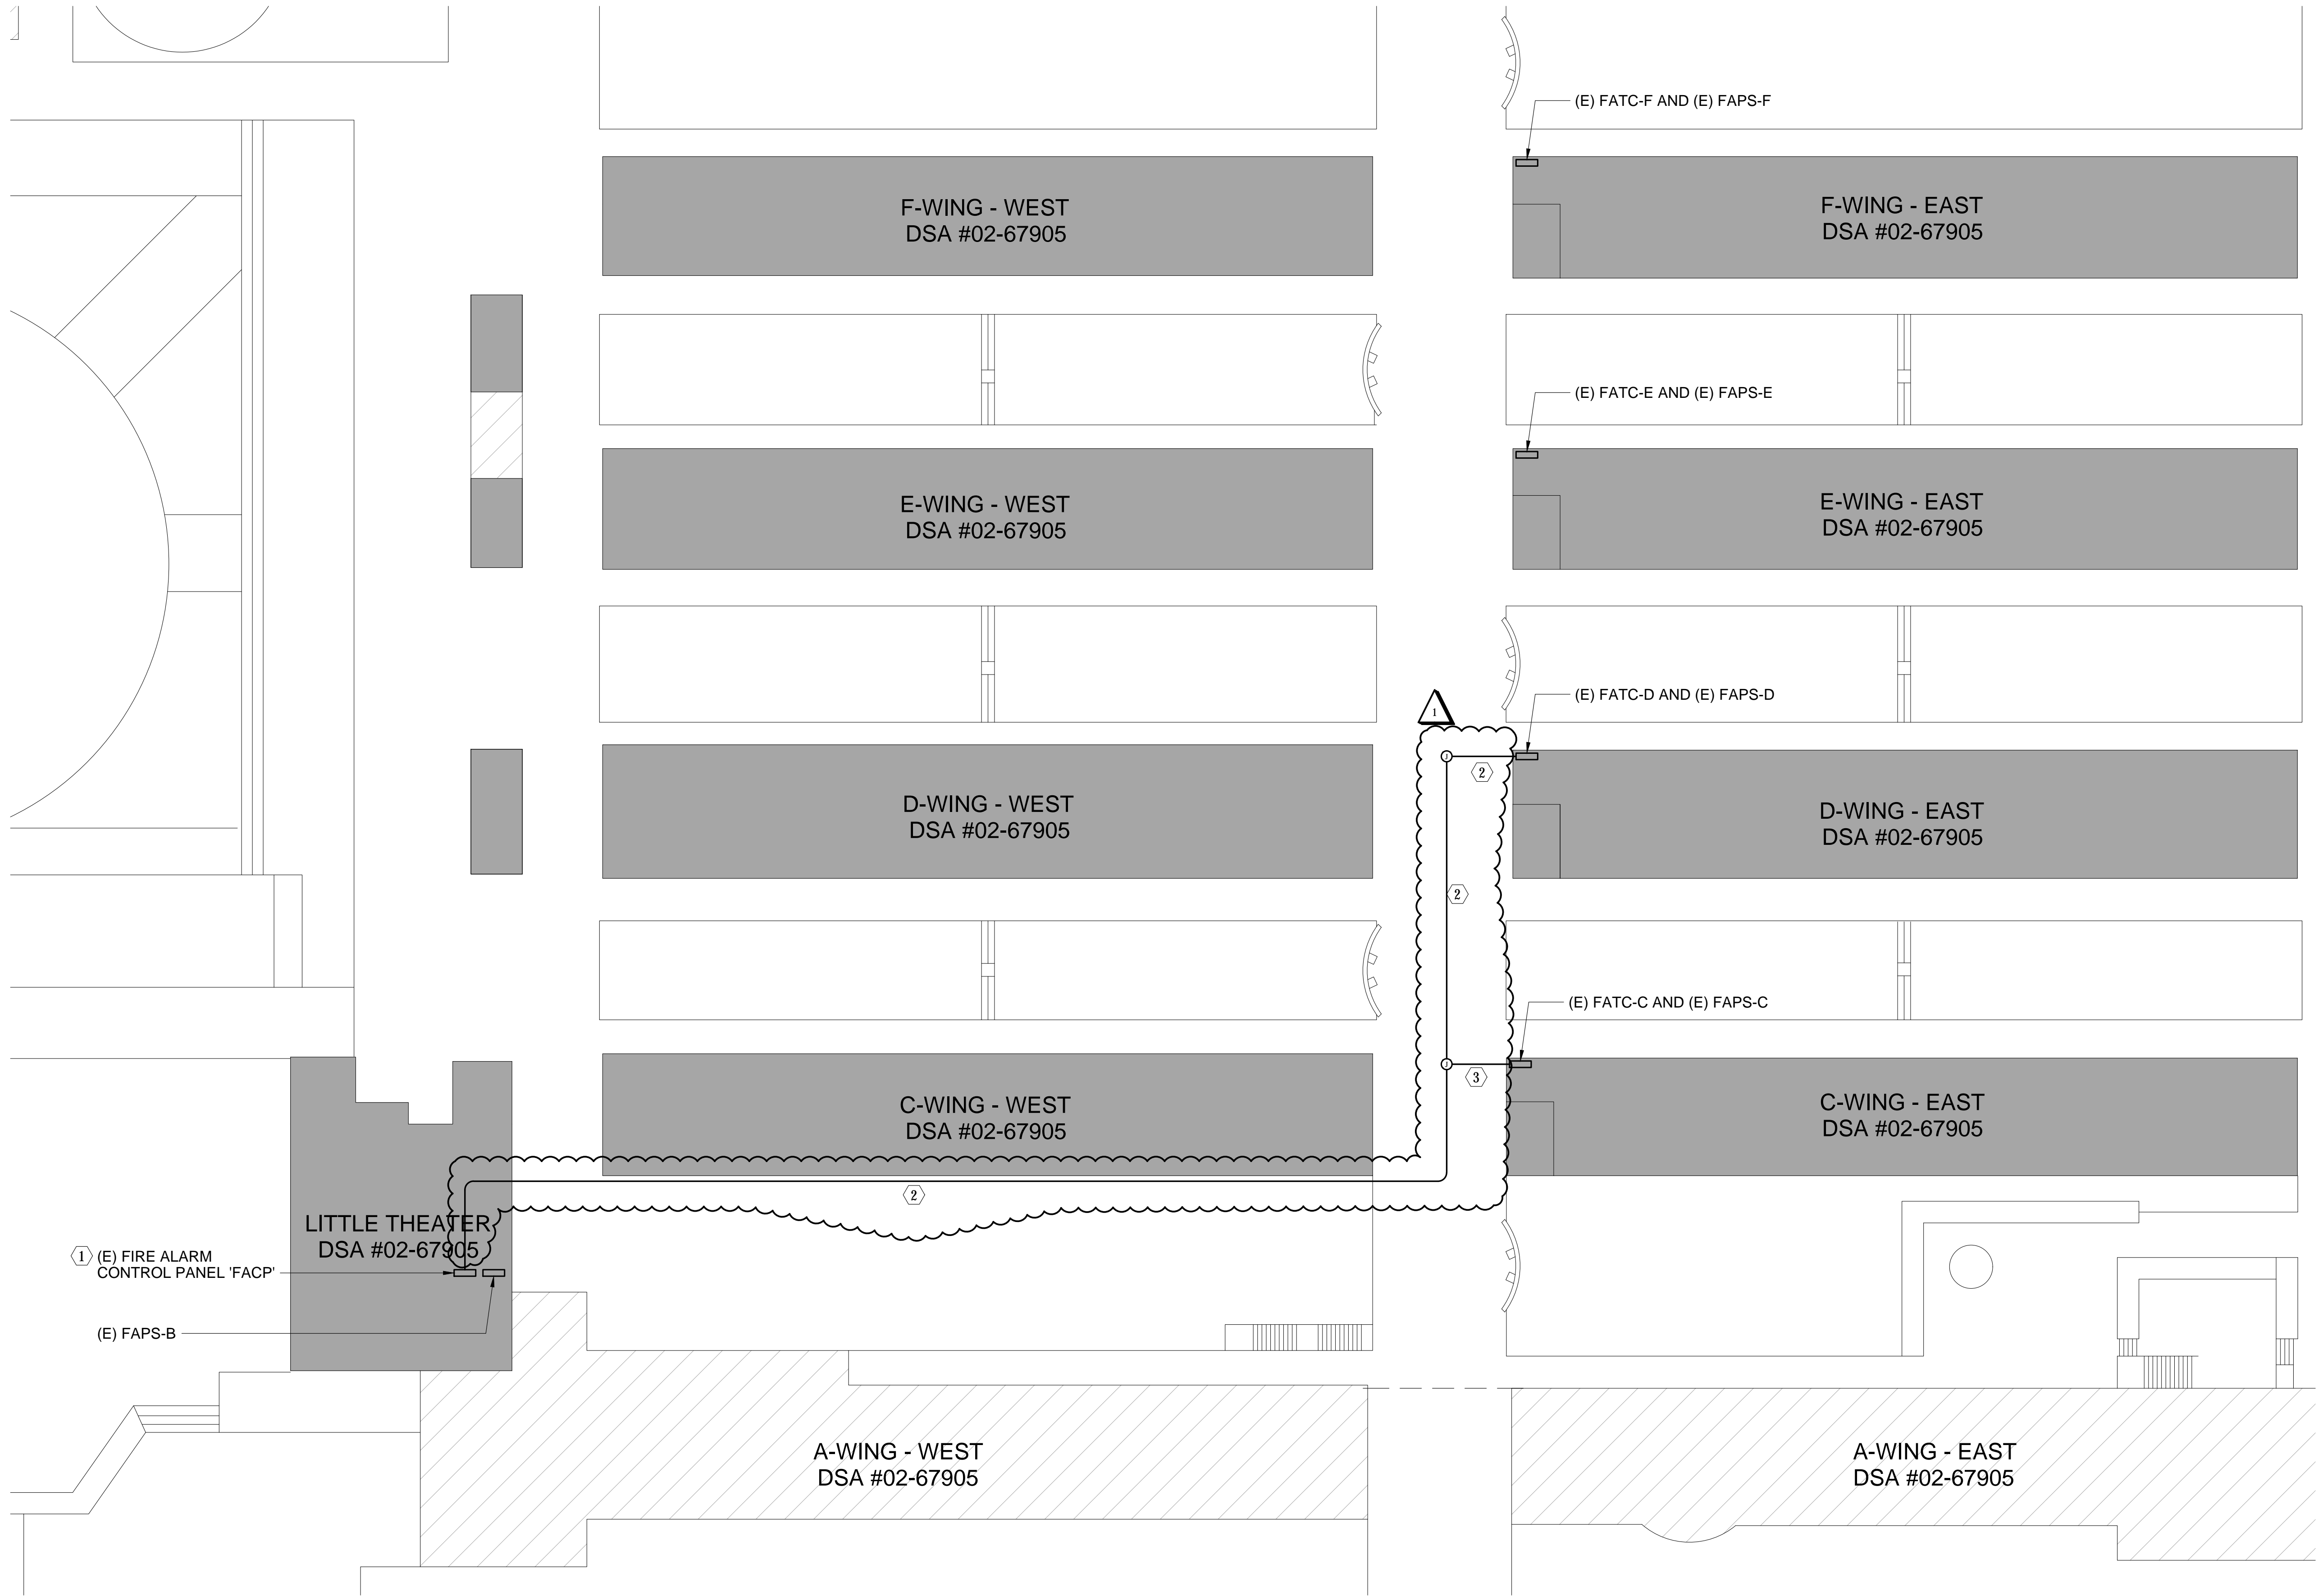

1 PARTIAL SITE PLAN - FIRE ALARM  
SCALE: 1" = 20'-0"

NUMBERED NOTES

- 1 PROVIDE ALL PARTS, CARDS, PROGRAMMING, ETC. AS REQUIRED.
- 2 1"C-1N.
- 3 1"C-2N.



# Revisions			
No.	Revisions	By	Date
1	Addendum #2		5/22/18

BACKCHECK SET

ISSUE DATE: 4/17/18 BY: AA

DSA APPROVAL

IDENTIFICATION STAMP  
DIVISION OF STATE ARCHITECT  
APPL 02-116505  
AC FLS SS  
DATE  
FILE NO. 67439-353

**EDGE**  
ELECTRICAL CONSULTING  
431 30th Street  
Sacramento, CA 95816  
916.256.2460  
300 27th Street #201  
Oakland, CA 94612  
510.775.3836  
Project Number E373 Contact CHRIS

This document is the property of the Owner and is not to be used without his written permission.  
Architect/Engineer Of Record:



**HY** HIBSER YAMAUCHI  
Architects, Inc.  
4602 2nd Street, Suite 3  
Davis, CA 95618  
530.758.1270 tel | 530.758.4789 fax  
HY Architects Project number: 5077

Facility  
HIRAM JOHNSON HIGH SCHOOL  
6879 14th Ave, Sacramento, CA 95820

Project  
HVAC UPGRADE

Sheet Title  
PARTIAL SITE PLAN - FIRE  
ALARM

Client Project Number:	Client Proj. #
Scale: As indicated	Sheet
Drawn By: Chris	E3.11
Checked By: Donny	
Issue Date: 4/17/18	
Revit Version: 2017	




IF THIS SHEET IS NOT 30"x42", IT IS  
A REDUCED PRINT SCALE ACCORDINGLY




Revisions				
No.	Revisions	By	Date	Appr.
1	Addendum #2		5/22/18	


- NUMBERED NOTES**
- CONNECT INTO (E) ADDRESSABLE LOOP.
  - EXTEND SOUNDER BASE POWER TO FAPS. CONNECT TO AUX. OUTPUT.
  - RECONNECT (E) DEVICE.
  - (E) MULTI-CANDELA HORN/STROBE. ADJUST CANDELA RATING TO BE AS SHOWN.
  - 3/4"C-2N TO PREVIOUS FA NOTIFICATION DEVICE. FIELD VERIFY LOCATION.
  - 3/4"C-2N TO NEXT FA NOTIFICATION DEVICE. FIELD VERIFY LOCATION.
  - 3/4"C-2N.

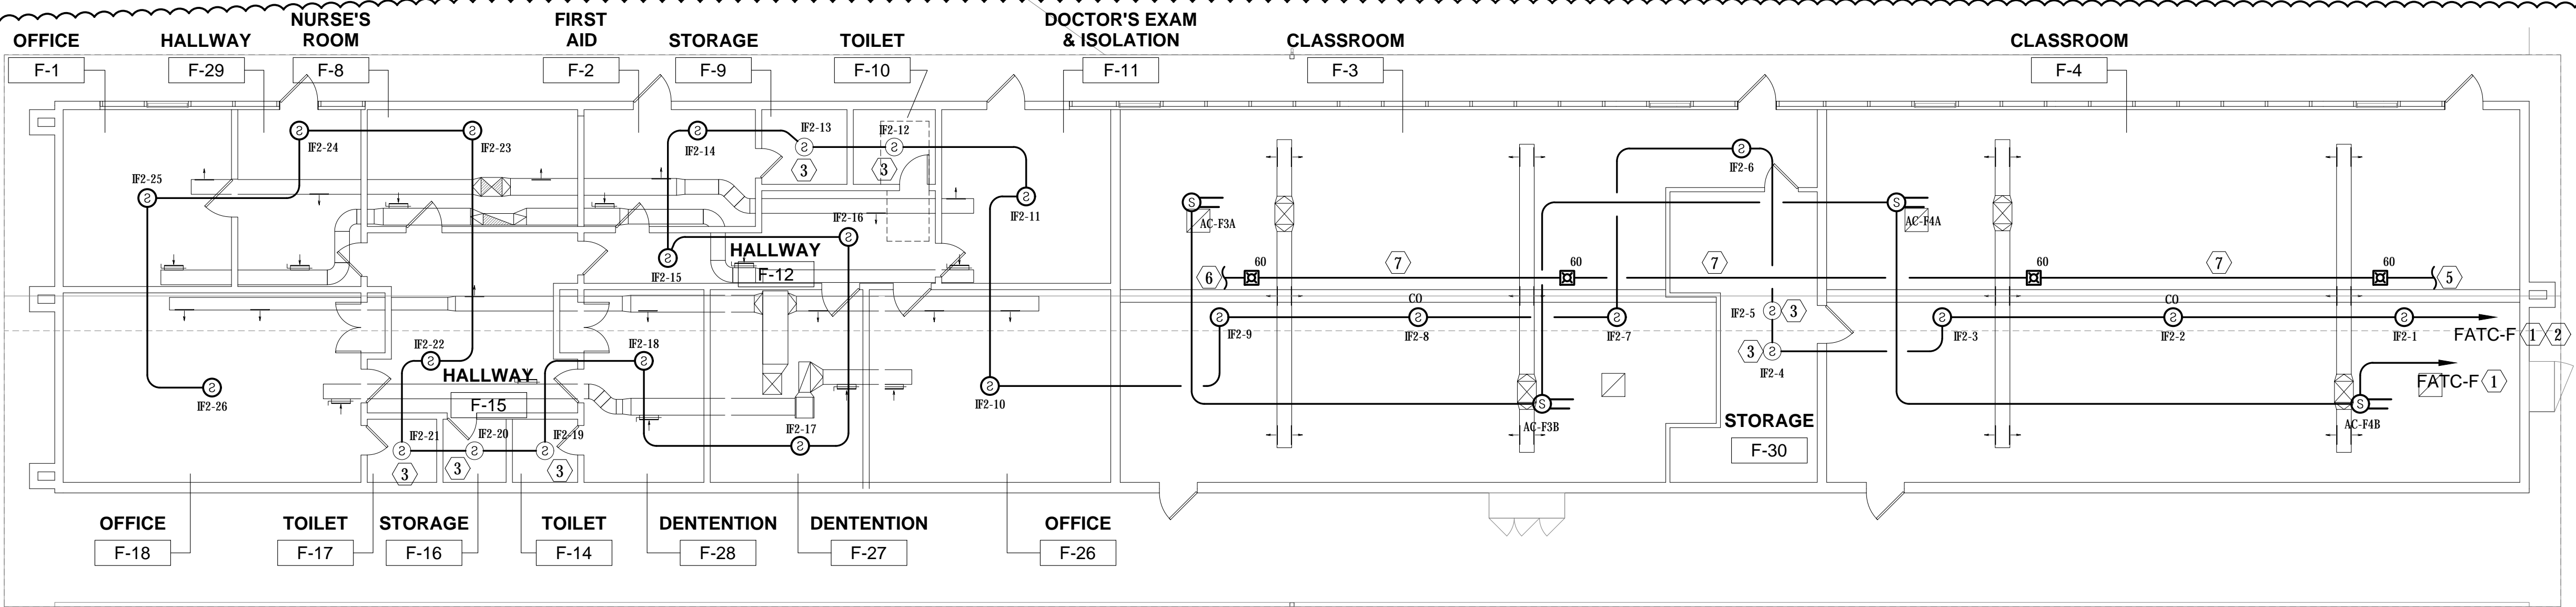


**1 BUILDING F - WEST WING - LIGHTING FLOOR PLAN**  
SCALE: 1/8" = 1'-0"

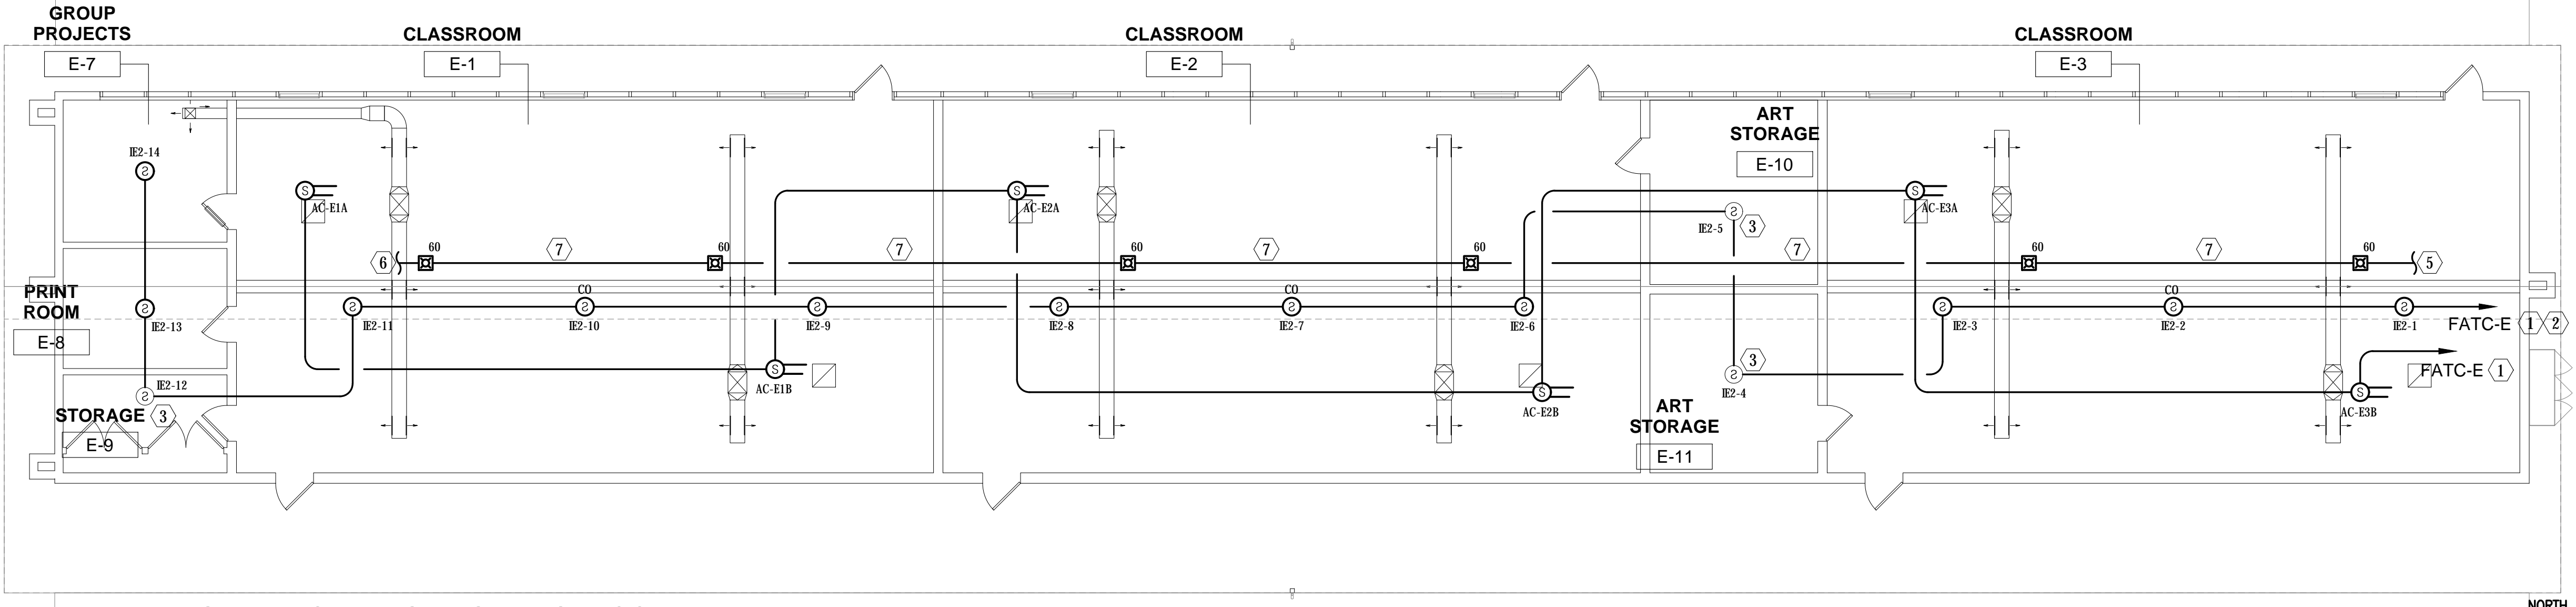

**2 BUILDING E - WEST WING - LIGHTING FLOOR PLAN**  
SCALE: 1/8" = 1'-0"

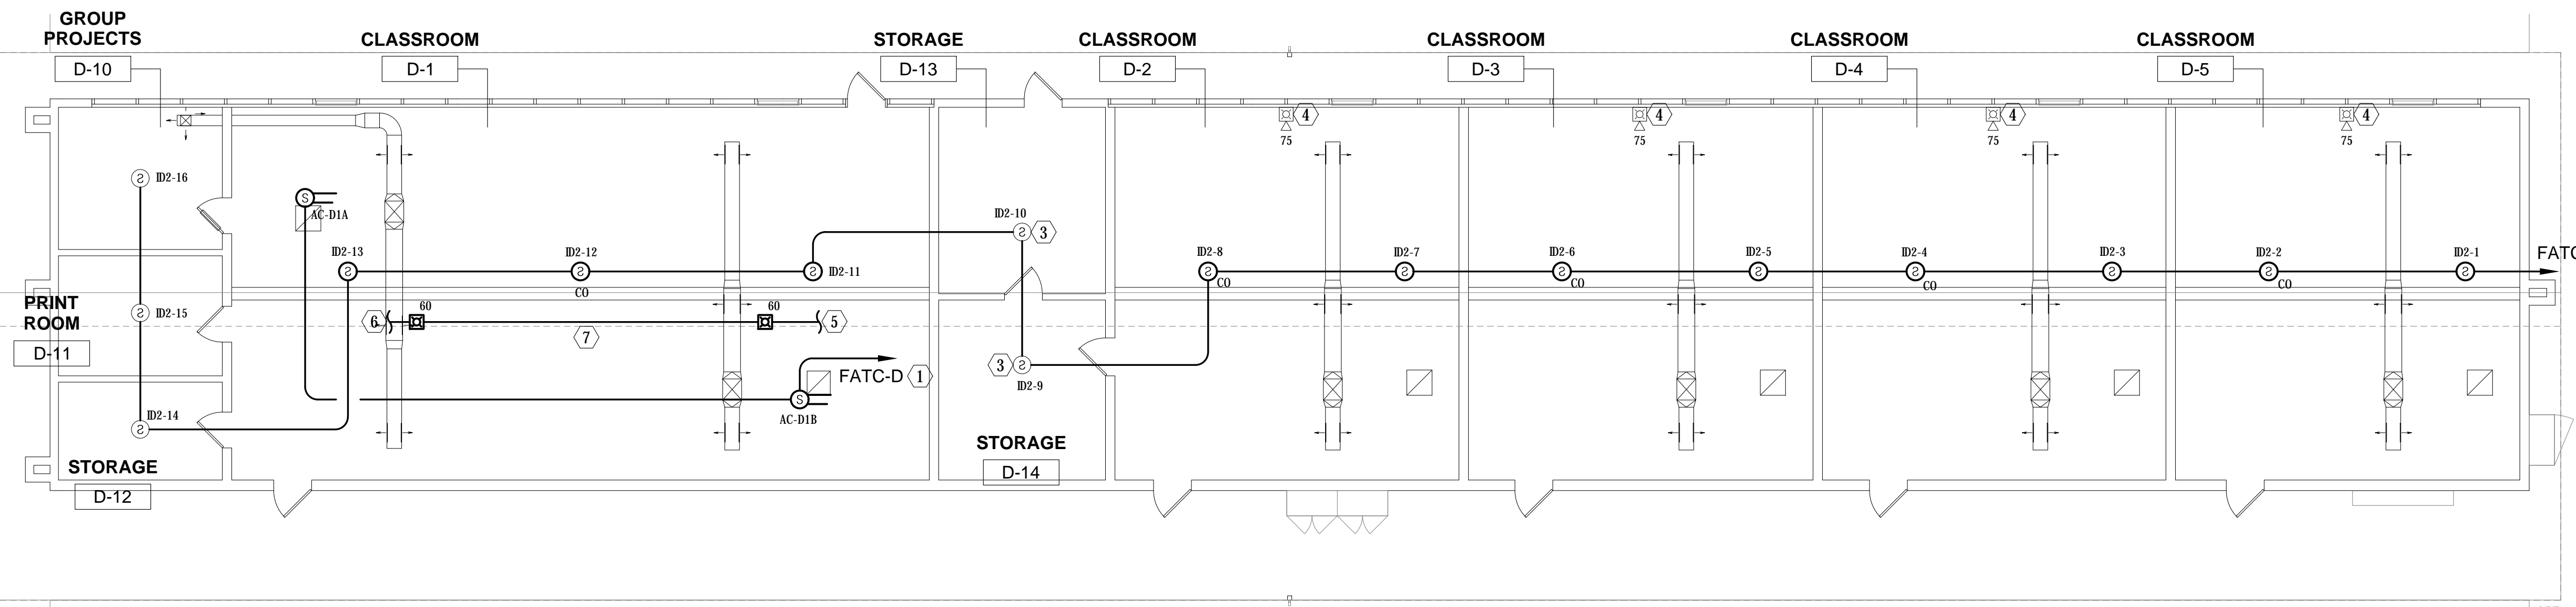

**3 BUILDING D - WEST WING - LIGHTING FLOOR PLAN**  
SCALE: 1/8" = 1'-0"

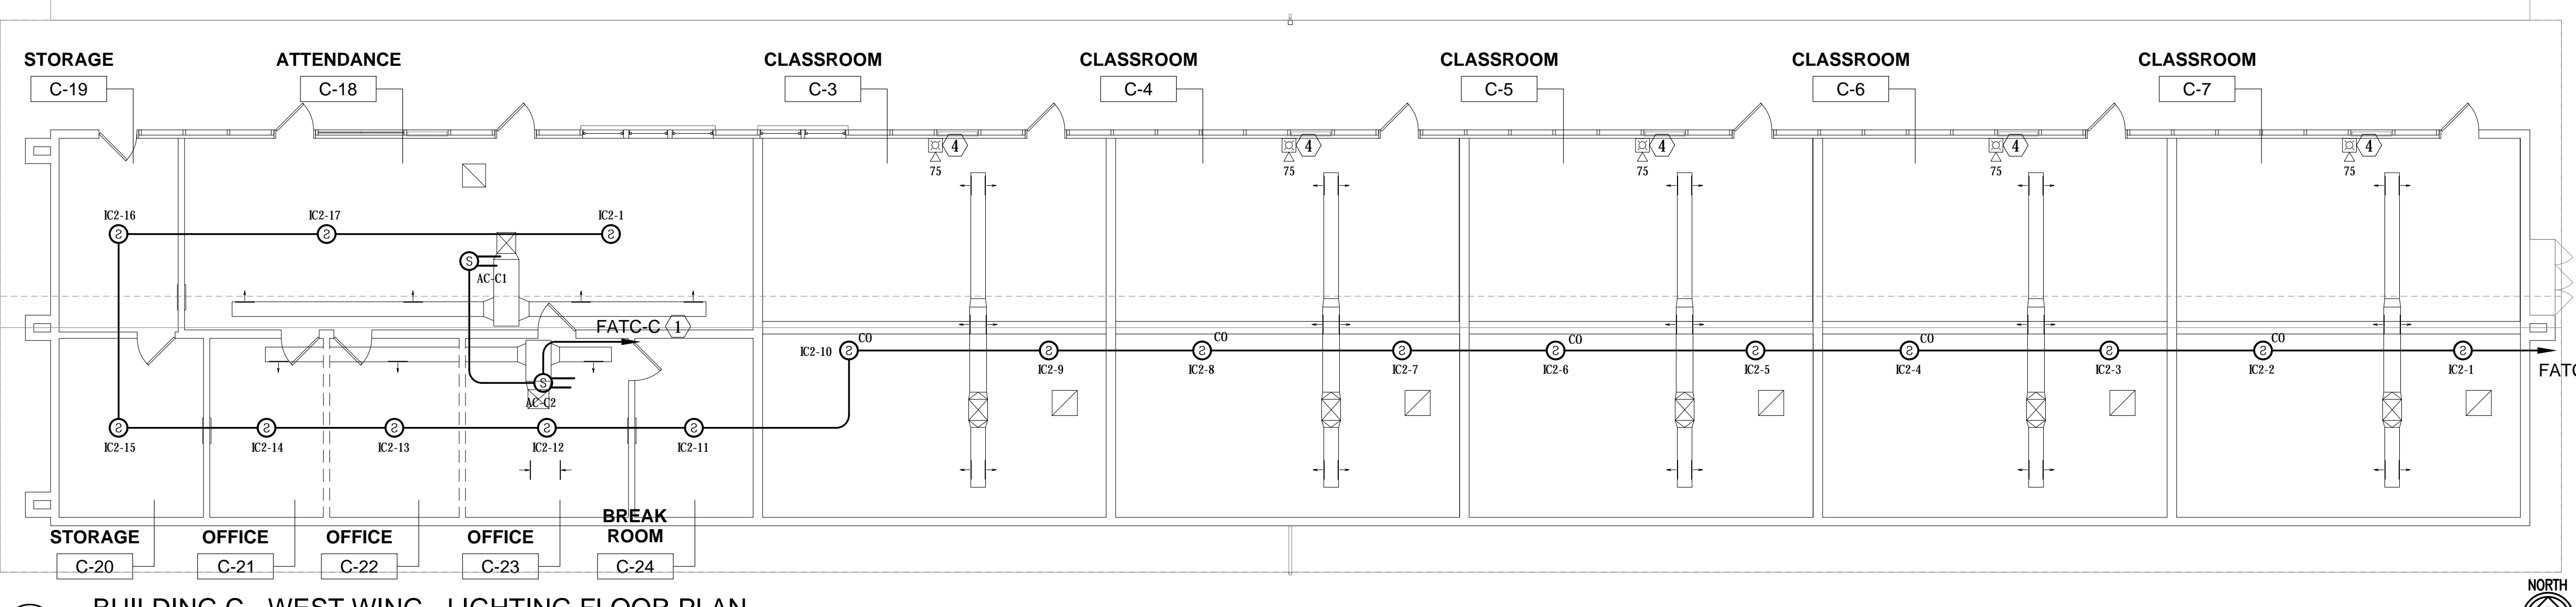

**4 BUILDING C - WEST WING - LIGHTING FLOOR PLAN**  
SCALE: 1/8" = 1'-0"

**BACKCHECK SET**

ISSUE DATE: 4/17/18 BY: AA

**DSA APPROVAL**

IDENTIFICATION STAMP  
DIVISION OF STATE ARCHITECT  
APPL. 02-116505  
AC \_\_\_\_\_ SS \_\_\_\_\_  
DATE \_\_\_\_\_  
FILE NO. 67439-353


**EDGE ELECTRICAL CONSULTING**

431 30th Street  
Sacramento, CA 95816  
916.256.2460  
Project Number E373 Contact CHRIS

300 27th Street #201  
Oakland, CA 94612  
510.775.3836

This document is the property of the Owner and is not to be used without his written permission.

Architect/Engineer Of Record:

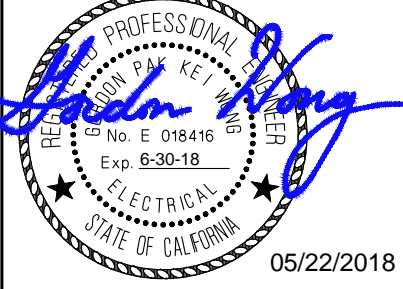

05/22/2018

**HY HIBSER YAMAUCHI Architects, Inc.**  
4602 2nd Street, Suite 3  
Davis, CA 95618  
530.758.1270 tel | 530.758.4789 fax  
HY Architects Project number: 5077

Facility  
**HIRAM JOHNSON HIGH SCHOOL**  
6879 14th Ave, Sacramento, CA 95820

Project  
**HVAC UPGRADE**

Sheet Title  
**FIRE ALARM PLANS  
WEST WING**

Client Project Number: Client Proj. #  
Scale: As indicated  
Drawn By: Chris  
Checked By: Donny  
Issue Date: 4/17/18  
Revit Version: 2017

**E3.21**




IF THIS SHEET IS NOT 30"x42", IT IS  
A REDUCED PRINT SCALE ACCORDINGLY




# Revisions				
No.	Revisions	By	Date	Appr.
1	Addendum #2		5/22/18	


- ### NUMBERED NOTES
- CONNECT INTO (E) ADDRESSABLE LOOP.
  - EXTEND SOUNDER BASE POWER TO FAPS. CONNECT TO AUX. OUTPUT.
  - RECONNECT (E) DEVICE.
  - (E) MULTI-CANDELA HORN/STROBE. ADJUST CANDELA RATING TO BE AS SHOWN.
  - 3/4"C-2N TO PREVIOUS FA NOTIFICATION DEVICE. FIELD VERIFY LOCATION.
  - 3/4"C-2N TO NEXT FA NOTIFICATION DEVICE. FIELD VERIFY LOCATION.
  - 3/4"C-2N.

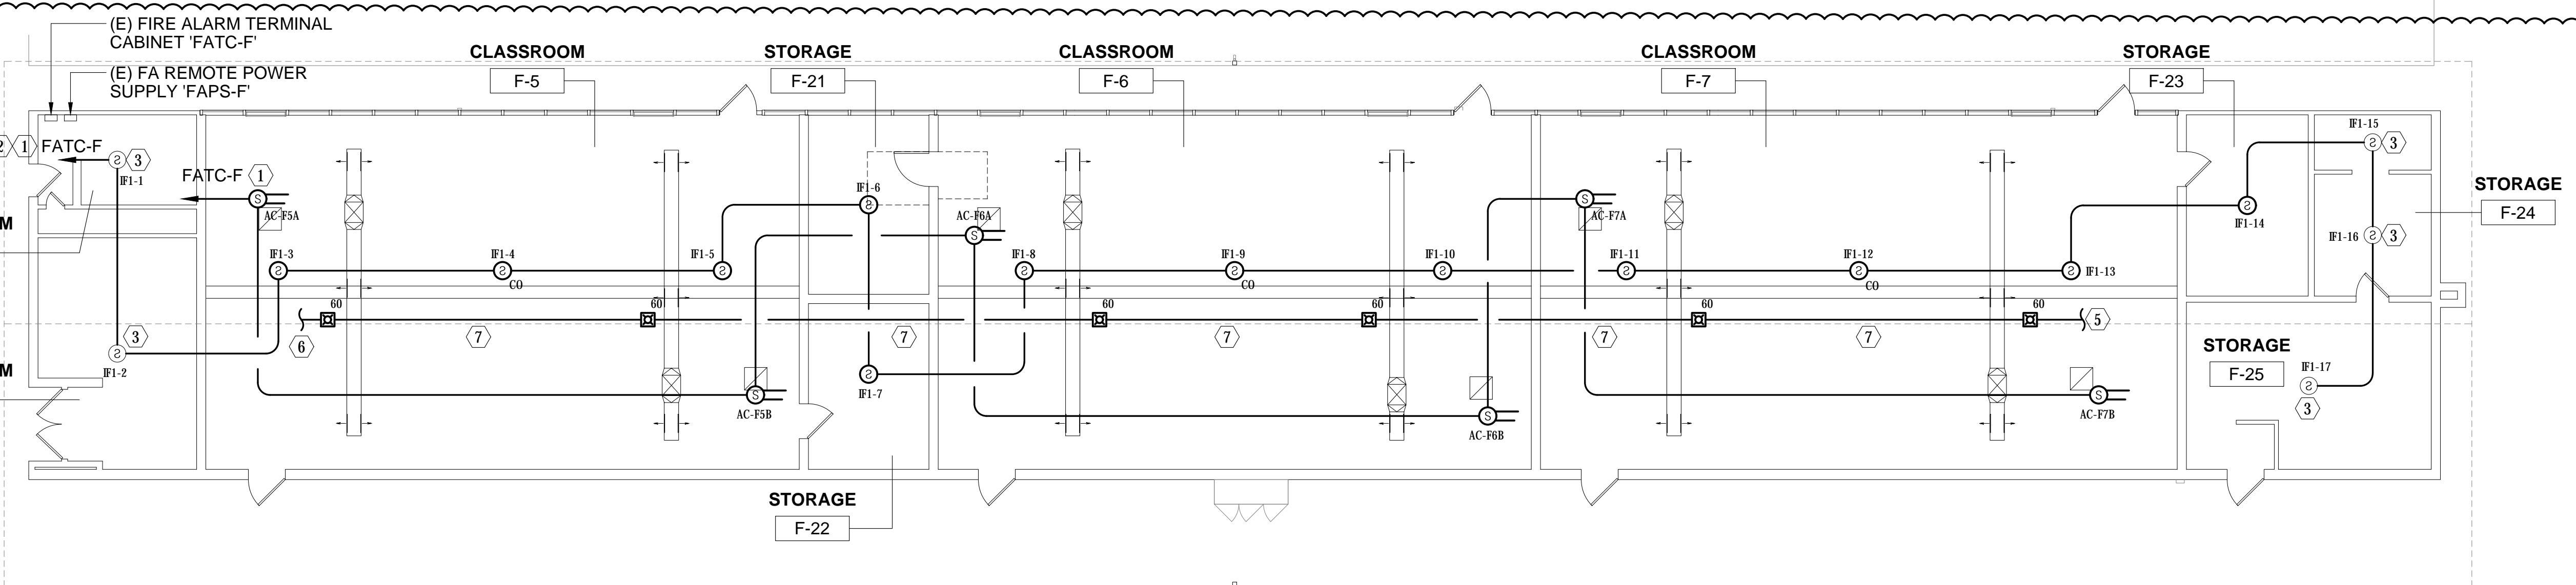


1 BUILDING F - EAST WING - LIGHTING FLOOR PLAN  
SCALE: 1/8" = 1'-0"

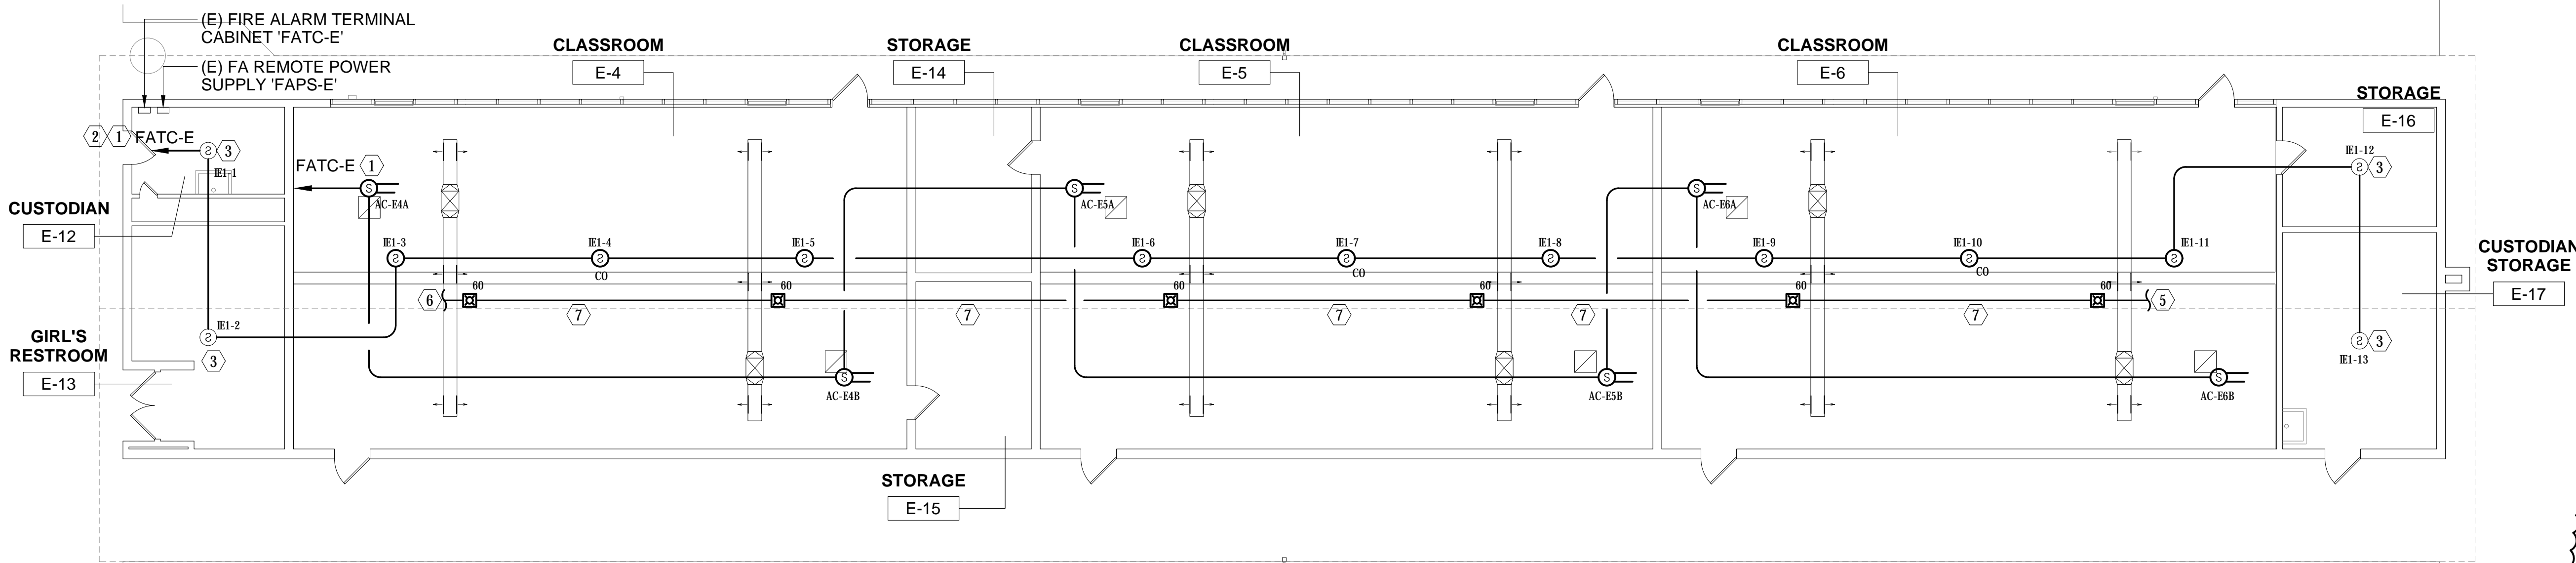

2 BUILDING E - EAST WING - LIGHTING FLOOR PLAN  
SCALE: 1/8" = 1'-0"

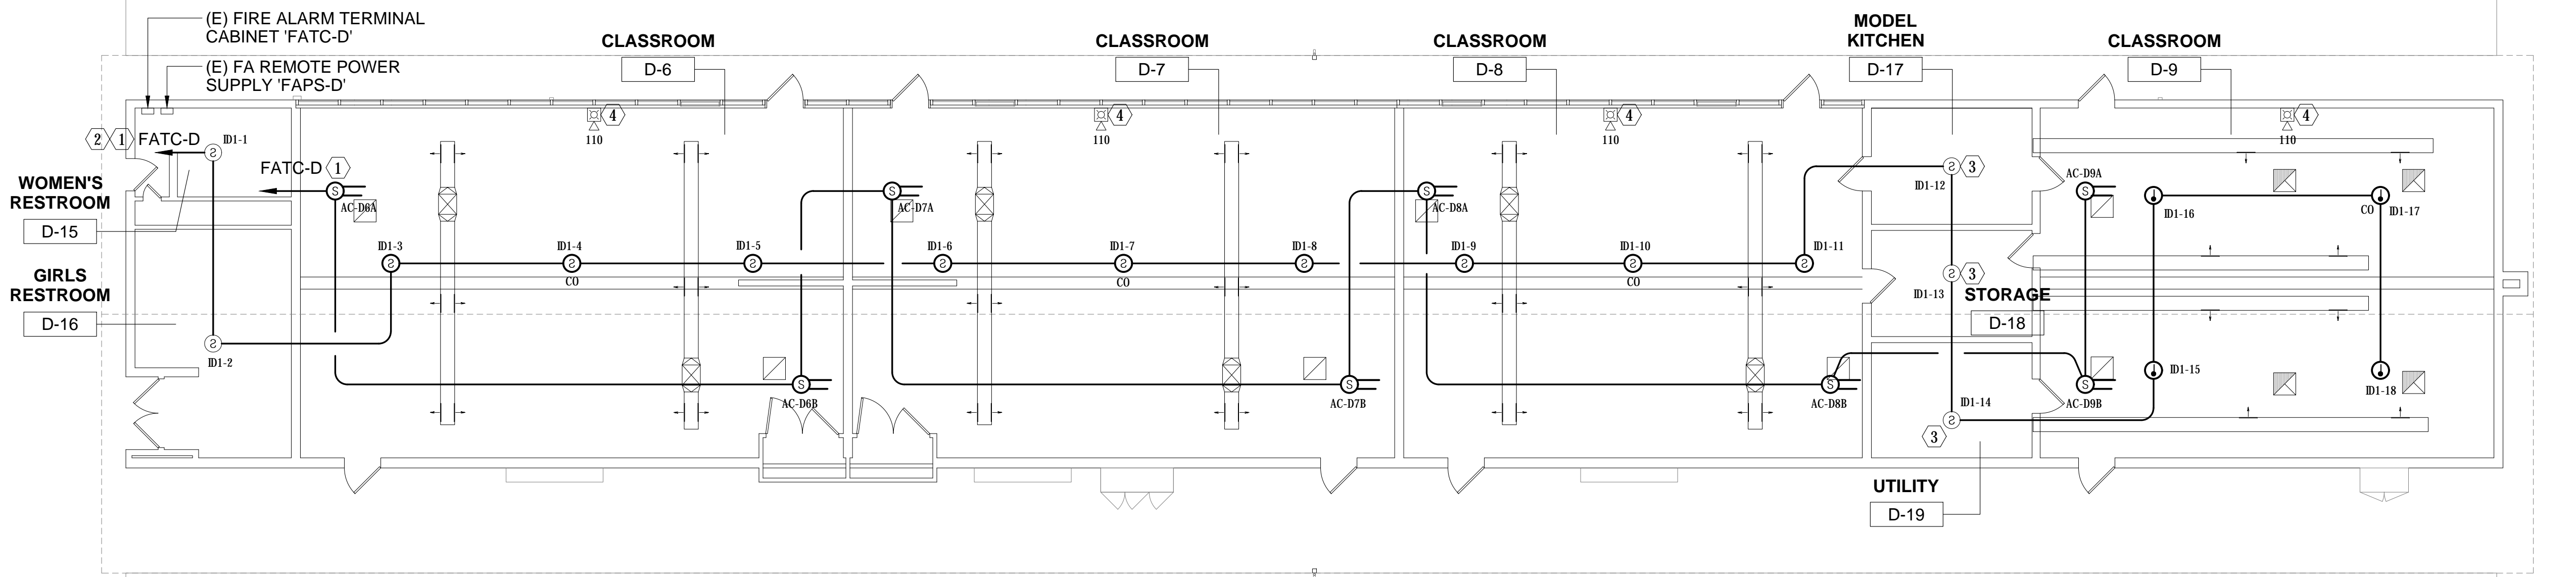

3 BUILDING D - EAST WING - LIGHTING FLOOR PLAN  
SCALE: 1/8" = 1'-0"

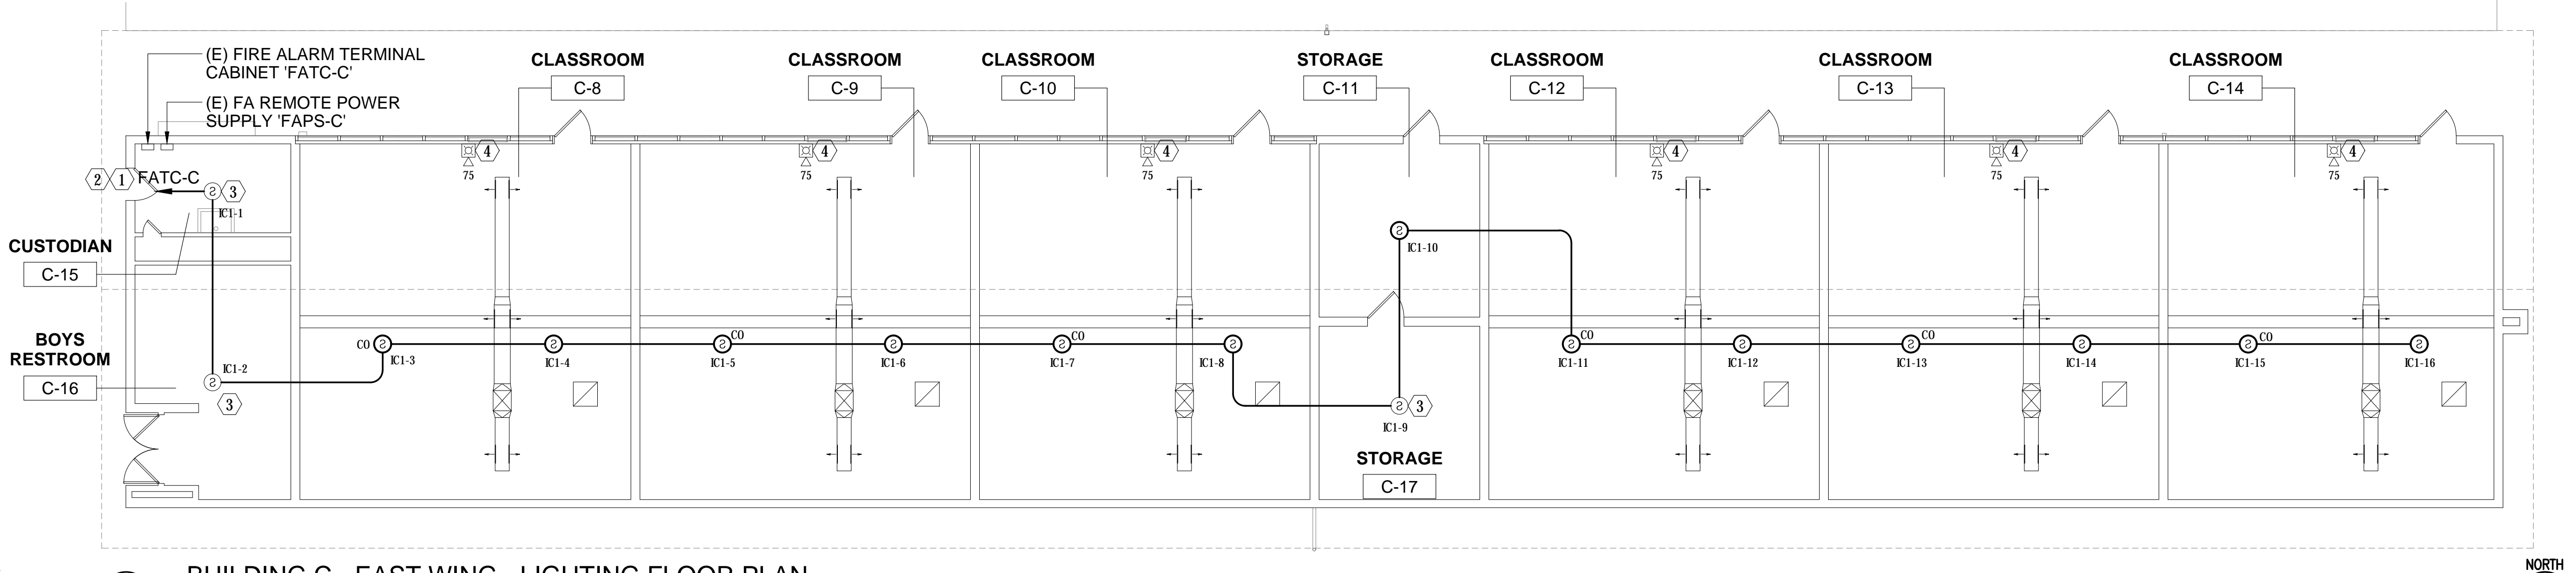

4 BUILDING C - EAST WING - LIGHTING FLOOR PLAN  
SCALE: 1/8" = 1'-0"

### BACKCHECK SET

ISSUE DATE: 4/17/18 BY: AA

### DSA APPROVAL

IDENTIFICATION STAMP  
DIVISION OF STATE ARCHITECT  
APPL. 02-116505  
AC FLS SS  
DATE  
FILE NO. 67439-353

### EDGE ELECTRICAL CONSULTING

431 30th Street  
Sacramento, CA 95816  
916.256.2460  
Project Number E373 Contact CHRIS

300 27th Street #201  
Oakland, CA 94612  
510.775.3896

This document is the property of the Owner and is not to be used without his written permission.  
Architect/Engineer Of Record:



**HY** HIBSER YAMAUCHI  
Architects, Inc.  
4602 2nd Street, Suite 3  
Davis, CA 95618  
530.758.1270 tel | 530.758.4789 fax

HY Architects Project number: 5077

Facility  
HIRAM JOHNSON HIGH SCHOOL  
6879 14th Ave, Sacramento, CA 95820

Project  
HVAC UPGRADE

Sheet Title  
FIRE ALARM PLANS  
EAST WING

Client Project Number: Client Proj. #  
Scale: As indicated  
Drawn By: Chris  
Checked By: Donny  
Issue Date: 4/17/18  
Revit Version: 2017

Sheet  
**E3.22**

